
GENERAL NOTES:


1. THE ELECTRICAL INSTALLATION SHALL COMPLY WITH THE 2009 EDITION OF THE INDIANA ELECTRICAL CODE AND THE 2023 NATIONAL ELECTRICAL CODE. IF THERE ARE DISCREPANCIES BETWEEN THE 2009 INDIANA ELECTRICAL CODE AND THE 2023 NEC, THE MOST STRINGENT REQUIREMENT SHALL APPLY.
2. ELEVATION CALLOUTS INCLUDING BOTTOM OF FIXTURE (BOF) ELEVATIONS ARE FROM PLANT ELEVATION. PLANT ELEVATION 100'-0"= 926'-9 3/5" GEODETIC ELEVATION
3. ALL CONDUIT ENTRIES TO DEVICES, JUNCTION BOXES, CABINETS, PANELS, ETC. SHALL BE FROM THE BOTTOM OR SIDE.
4. SEE LIGHTING PANEL SCHEDULES FOR WIRE SIZES.
5. COMMON NEUTRALS SHALL NOT BE USED FOR ANY BRANCH CIRCUIT.
6. THE INSTALLATION DETAILS AS SHOWN ON THIS PLAN DRAWING ARE REFERENCE. CONTRACTOR SHALL VERIFY AND USE APPROPRIATE INSTALLATION DETAILS.

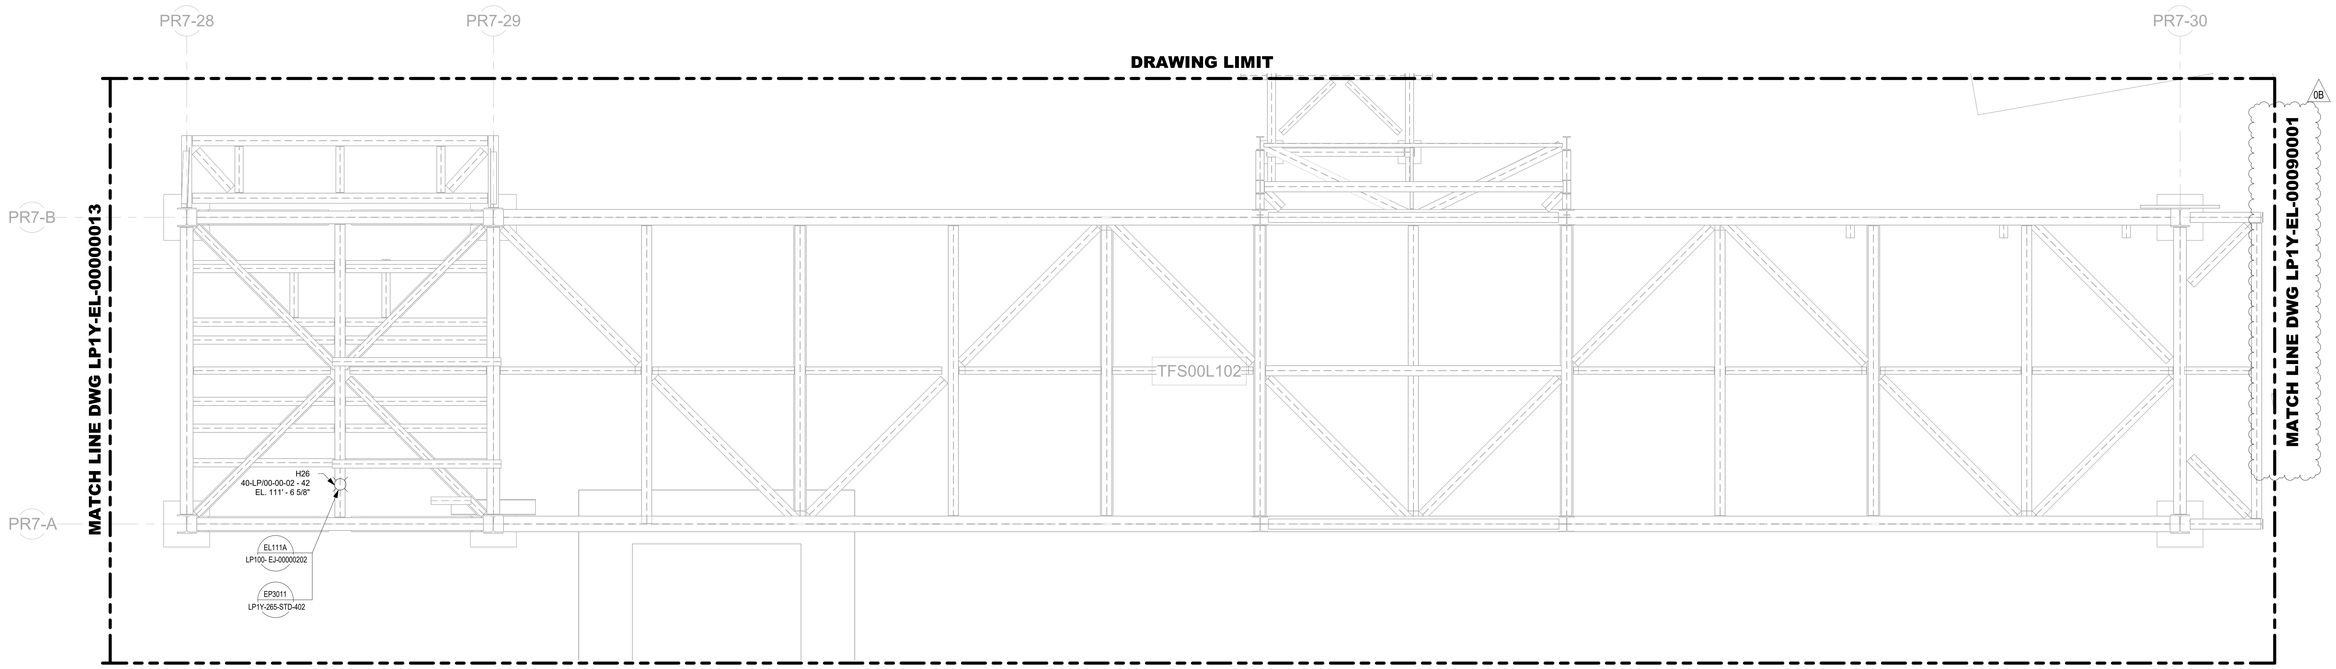

PLAN VIEW (EL 97'-0' TO EL 146'-0)

1/4" = 1'-0"

REFERENCE DRAWINGS	
DRAWING NUMBER	DESCRIPTION
LP100-EJ-00000001 THROUGH LP100-EJ-00000003	GENERAL NOTES, LEGEND AND SYMBOLS
LP100-EJ-00000004 / LP100-EJ-00000005	OVERALL LIGHTING FIXTURE SCHEDULE
LP100-EJ-00000200 SERIES DRAWINGS	ELECTRICAL LIGHTING DETAILS
LP1Y-EL-00000301	ELECTRICAL DRAWING INDEX TANK FARM, CABLE TRAY, LIGHTING AND POWER
LP1Y-EL-00000201 THROUGH LP1Y-EL-00000290	ELECTRICAL LIGHTING PHOTOMETRICS
LP140-265-LST-002	ELECTRICAL CABLE LIST - E HOUSE 40
LP140-EK-00000101	ELECTRICAL PANELBOARD SCHEDULES BUILDING 40 NORMAL LIGHTING AND SMALL POWER 40-LP/00-00-02, 40-RP/00-00-01, 40-RP/00-00-02, 40-RP/00-00-03
LP1Y-EK-00010000 THROUGH LP1Y-EK-00090000	ELECTRICAL HAZARDOUS AREA CLASSIFICATION
LP1Y-265-STD-402	ELECTRICAL POWER DETAILS BUILDING Y TFS/CUB
LP1Y-EL-00000013	ELECTRICAL LIGHTING PLAN TANK FARM, EAST - WEST PIPERACK
LP148-265-LST-002	ELECTRICAL CABLE LIST - E HOUSE 48
LP1Y-EL-00090001	ELECTRICAL LIGHTING PLAN - RAIL UNLOADING RACK
LP1Y-EL-00090002	ELECTRICAL LIGHTING FIXTURE SCHEDULE - RAIL UNLOADING RACK
LP1Y-EL-00090003 LP1Y-EL-00090004 LP1Y-EL-00090005 LP1Y-EL-00090006	ELECTRICAL LIGHTING PHOTOMETRICS - RAIL UNLOADING RACK

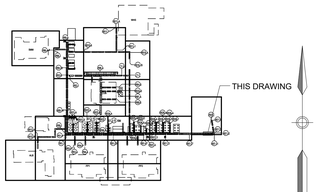

SITE - KEYPLAN

REV	ZONE	PROJECT NUMBER / DESCRIPTION	CHANGE CONTROL	DATE
0B	ALL	ISSUED FOR REVIEW	NA	17-APR-2026
0A	ALL	ISSUED FOR REVIEW	NA	02-MAR-2026
0	ALL	ISSUED FOR CONSTRUCTION	NA	08-MAY-2025
A	ALL	ISSUED FOR SQUAD CHECK	NA	28-APR-2025

REVISIONS

CONFIDENTIAL INFORMATION

THIS DRAWING AND THE IDEAS AND DESIGNS SHOWN THEREON ARE THE EXCLUSIVE PROPERTY OF ELI LILLY AND COMPANY AND ARE NOT TO BE USED, REPRODUCED OR DISCLOSED, EITHER IN WHOLE OR IN PART, WITHOUT THE WRITTEN CONSENT OF ELI LILLY AND COMPANY.

FLUOR®

EFDEE Engineering PC
PROJECT NO. 81LG
NODE: TFS

REV	DATE	DES	ENG	CHK	APP	PM APP
0B	17-APR-2026	ML	AT	BM	RM	SS
0A	02-MAR-2026	BM	AJT	RDN	AJT	SS
0	08-MAY-2025	DA	MS	AM	TL	EM
A	28-APR-2025	RT	MS	AM	TL	EM


ELECTRICAL LIGHTING PLAN
TANK FARM, EAST - WEST PIPERACK

SYSTEM TYPE: NA			EDIFICE/BUILDING: Y	LEVEL/FLOOR: 0	
SUB DISCIPLINE: EP	LOCATION CODE: LP1	LOCATION/GRID: NA	CCI CODE: YELLOW	PROJECT NAME: LP1-306-1181	
CRITICAL QUALITY		ENTERPRISE GROUP: API	DRAWING INTENTION	DRAWING SCALE: 1/4" = 1'-0"	
CRITICAL BUSINESS		EQUIPMENT CLASSIFICATION: NA	ALTERNATE DOCUMENT ID: NA		MERIDIAN REV: 0B
CRITICAL HSE		VENDOR: NA	DOCUMENT ID: LP1Y-EL-00000014		
NON-CRITICAL		ENGINEERING AGENCY DOC ID: NA			

Autodesk Docs://265007 - Manage Plus/
Lilly/LP1/Y-TFS-ED-000-00-00-FGL_detached.rvt
4/20/2026 1:49:51 PM


IF YOU ARE USING A PRINTED COPY OF THIS DOCUMENT, IT IS AN UNCONTROLLED PRINT. CONFIRM WITH THE OFFICIAL "ELECTRONIC RECORD" DOCUMENT IN THE GLOBAL ENGINEERING CONTENT MANAGEMENT SYSTEM.

IF YOU ARE USING A PRINTED COPY OF THIS DOCUMENT, IT IS AN UNCONTROLLED PRINT. CONFIRM WITH THE OFFICIAL "ELECTRONIC RECORD" DOCUMENT IN THE GLOBAL ENGINEERING CONTENT MANAGEMENT SYSTEM.

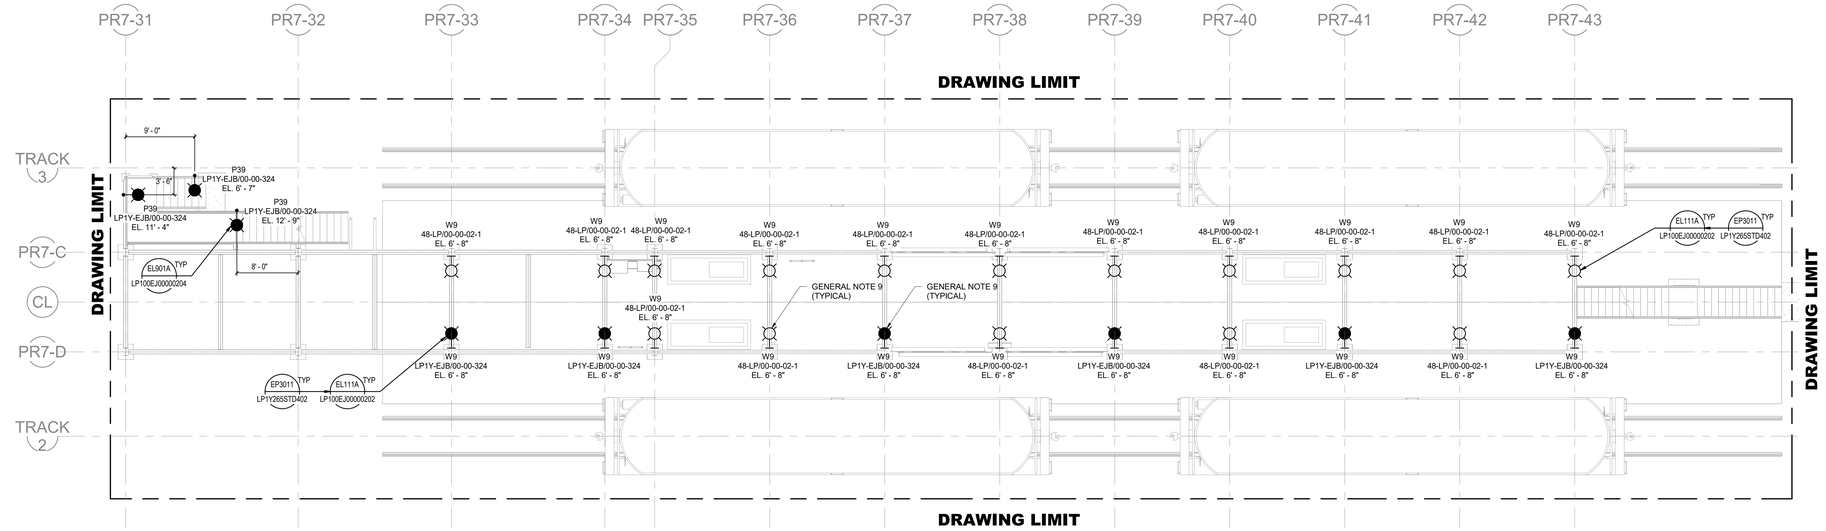

1 LIGHTING PLAN - GROUND LEVEL

SCALE: 1/8" = 1'-0" 0 4' 8' 16'

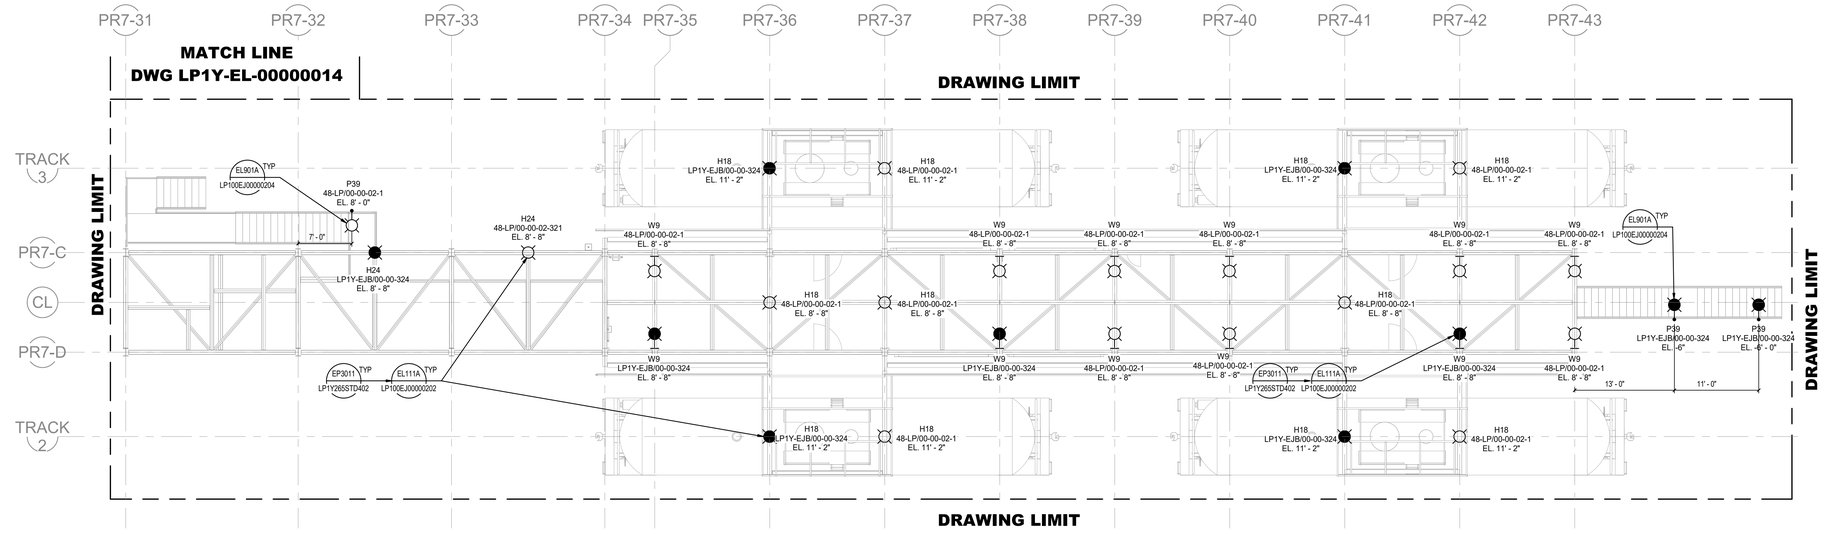

2 LIGHTING PLAN - OPERATING PLATFORM

SCALE: 1/8" = 1'-0" 0 4' 8' 16'


GENERAL NOTES:

1. THE ELECTRICAL INSTALLATION SHALL COMPLY WITH THE 2009 EDITION OF THE INDIANA ELECTRICALCODE AND THE 2023 NATIONAL ELECTRICAL CODE. IF THERE ARE DISCREPANCIES BETWEEN THE 2009 INDIANA ELECTRICAL CODE AND THE 2023 NEC, THE MOST STRINGENT REQUIREMENT SHALL APPLY.
2. ALL CONDUIT ENTRIES TO DEVICES, JUNCTION BOXES, CABINETS, PANELS, ETC. SHALL BE FROM THE BOTTOM OR SIDE.
3. SEE LIGHTING PANEL SCHEDULES FOR WIRE SIZES.
4. COMMON NEUTRALS SHALL NOT BE USED FOR ANY BRANCH CIRCUIT.
5. ALL STANCHION MOUNT FIXTURES SHALL BE INSTALLED USING V-SPRING POLE PER INSTALLATION DETAIL EL901A. THE BOTTOM OF THE FIXTURE ELEVATION SHOULD BE APPROXIMATELY 8' FROM THE TOP OF THE PLATFORM, UNLESS OTHERWISE SPECIFIED. REFER TO DRAWING LP100EJ00000204.
6. EMERGENCY LIGHTING FIXTURES ARE FED FROM ENCLOSED JUNCTION BOX, LP1Y-EJB/00-00-324, LOCATED AT GRID LINES PR7-A & PR7-27. SEE SHEETS LP1Y-EL-00000013 AND LP1Y-EL-00000014.
7. EMERGENCY LIGHTING FIXTURES CIRCUIT IS POWERED BY A LIGHTING INVERTER PROVIDED BY OTHERS.
8. ALL LIGHTING CIRCUITS ARE CONTROLLED VIA LIGHTING CONTACTOR / PHOTOCELL, PROVIDED BY OTHERS.
9. ALL LIGHTING FIXTURES SHOWN ON THE GROUND LEVEL PLAN ARE FED FROM PLATFORM LEVEL LIGHT FIXTURES THAT SHARE THE SAME LIGHTING CIRCUIT. CONTRACTOR TO UTILIZE NEC AND FLUOR STANDARD RECOMMENDED CABLE AND CONDUIT ROUTING FROM PLATFORM LEVEL LIGHT FIXTURE TO GROUND LEVEL LIGHT FIXTURE. CONTRACTOR SHALL MEET NFPA 820 AND NEC FOR HAZARDOUS LOCATION FITTINGS, BOXES, ETC.

PANEL	CKT #	CIRCUIT	LOAD
48-LP/00-00-02	1	LTG - PLATFORM	814 VA
LP1Y-EJB/00-00-324	4	LTG - PLATFORM EMERGENCY	533 VA

REFERENCE DRAWINGS & DOCUMENTS:

DOCUMENT NUMBER	DOCUMENT TITLE
LP1Y-EP-00000113	ELECTRICAL CABLE TRAY AND GROUNDING PLAN TANK FARM, EAST - WEST PIPERACK TF500L101
LP1Y-EP-0009B001	ELECTRICAL CABLE TRAY AND GROUNDING PLAN PLATFORM LEVEL - RAIL UNLOADING RACK
LP1Y-EP-00090006	ELECTRICAL UNDERGROUND GROUNDING PLAN - RAIL UNLOADING RACK
LP148-265-LST-002	ELECTRICAL CABLE LIST - E HOUSE 48
LP142-265-LST-002	ELECTRICAL CABLE LIST - E HOUSE 42
LP1Y-EP-00000324	ELECTRICAL ABOVEGROUND GROUNDING PLAN TANK FARM, EAST - WEST PIPERACK
LP100-CS-30000001	CIVIL SITE PLAN OVERALL
B1LG-00-K004-00010	OVERALL CIVIL PLANS - PHASE 2
LP1Y-EP-0009A001	ELECTRICAL CABLE TRAY AND GROUNDING PLAN GROUND LEVEL - RAIL UNLOADING RACK
LP1Y-SF-0009253	PLATFORM FRAMING PLAN - RAIL UNLOADING RACK
LP1Y-SF-0009254	CABLE TRAY SUPPORT FRAMING PLAN - RAIL UNLOADING RACK
LP1Y-265-EP-00000402	ELECTRICAL TYPICAL POWER DETAILS BUILDING Y TFS/CUB
LP1Y-EL-00090004 LP1Y-EL-00090005 LP1Y-EL-00090006	ELECTRICAL LIGHTING PHOTOMETRICS - RAIL UNLOADING RACK
LP1Y-EK-00000105	PANEL SCHEDULE Y-ELP/00-00-01
LP1Y-EK-00000405	JUNCTION BOX WIRING DIAGRAM
LP100-EJ-00000004 LP100-EJ-00000005	OVERALL LIGHTING FIXTURE SCHEDULE

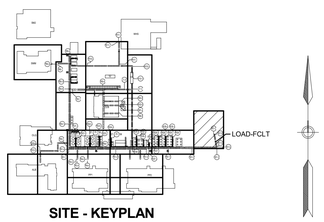

SITE - KEYPLAN

REV	ZONE	PROJECT NUMBER / DESCRIPTION	CHANGE CONTROL	DATE
B	ALL	ISSUED FOR REVIEW	NA	17-APR-2026
A	ALL	ISSUED FOR REVIEW	N/A	02-MAR-2026

REVISIONS

CONFIDENTIAL INFORMATION
THIS DRAWING AND THE IDEAS AND DESIGNS SHOWN THEREON ARE THE EXCLUSIVE PROPERTY OF ELI LILLY AND COMPANY AND ARE NOT TO BE USED, REPRODUCED OR DISCLOSED, EITHER IN WHOLE OR IN PART, WITHOUT THE WRITTEN CONSENT OF ELI LILLY AND COMPANY.

HANSON PROFESSIONAL SERVICES, INC.
www.hanson-inc.com
Offices Nationwide
11931 Wickchester Lane, Suite 370
Houston, TX 77043
(346) 297-1720

REV	DATE	DES	ENG	CHK	APP	PM APP
B	17-APR-2026	ML	AT	BM	RN	SS
A	02-MAR-2026	BM	AJT	RDN	AJT	SS

Lilly

ELECTRICAL LIGHTING PLAN


RAIL UNLOADING RACK

SYSTEM TYPE: NA		EDIFICE/BUILDING	LEVEL/FLOOR
SUB DISCIPLINE	LOCATION CODE: LP1	LOCATION/GRID	CCI CODE / PROJECT NAME: LP1-306-1181
CRITICAL QUALITY	ENTERPRISE GROUP: API	DRAWING INTENTION	DRAWING SCALE: As indicated
CRITICAL BUSINESS	EQUIPMENT CLASSIFICATION: NA	ALTERNATE DOCUMENT ID: NA	MERIDIAN REV
CRITICAL HSE	VENDOR: NA	DOCUMENT ID: LP1Y-EL-00090001	
NON-CRITICAL	ENGINEERING AGENCY DOC ID: NA		

IF YOU ARE USING A PRINTED COPY OF THIS DOCUMENT, IT IS AN UNCONTROLLED PRINT. CONFIRM WITH THE OFFICIAL "ELECTRONIC RECORD" DOCUMENT IN THE GLOBAL ENGINEERING CONTENT MANAGEMENT SYSTEM.


IF YOU ARE USING A PRINTED COPY OF THIS DOCUMENT, IT IS AN UNCONTROLLED PRINT. CONFIRM WITH THE OFFICIAL "ELECTRONIC RECORD" DOCUMENT IN THE GLOBAL ENGINEERING CONTENT MANAGEMENT SYSTEM.

4/20/2026 8:45:39 AM Autodesk Docs://250007 - Hanson-Fluor Lily LP1\Y-TFS-EL-000-000-00-HNS.rvt

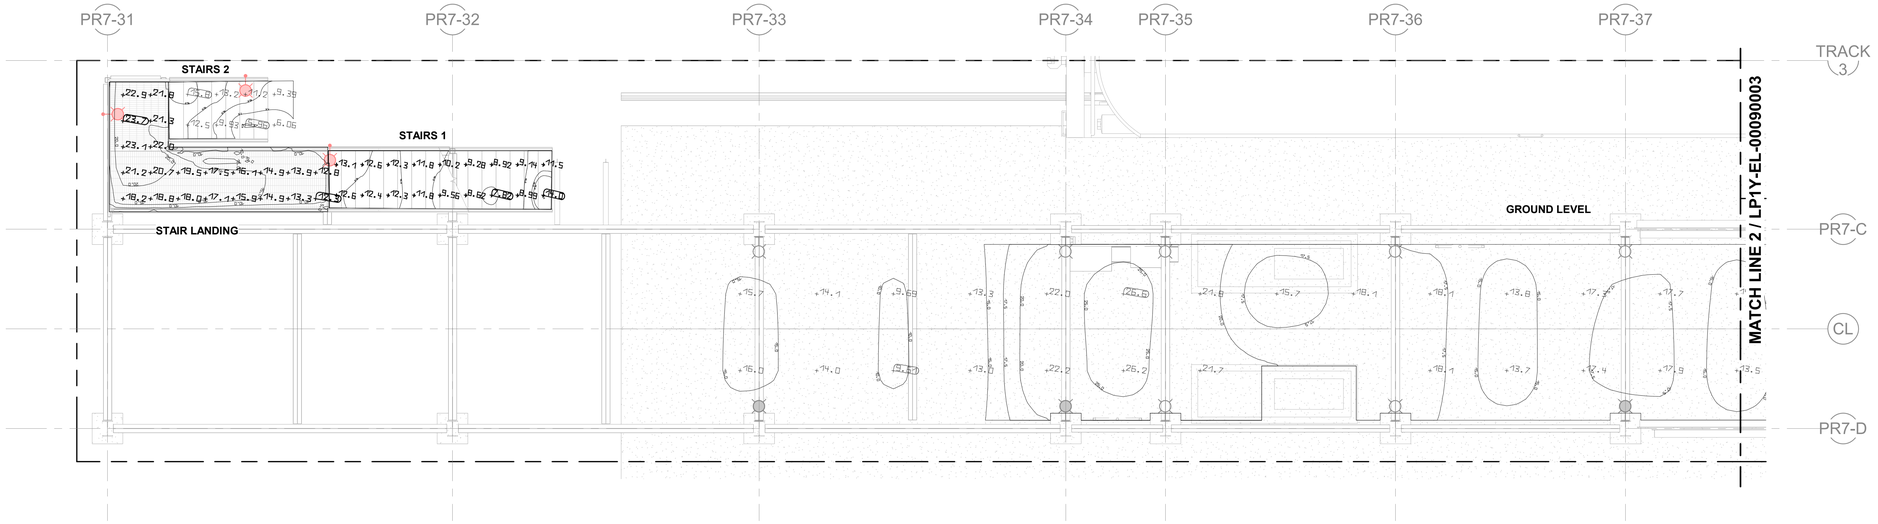

1 LIGHTING PLAN - GROUND LEVEL - NORMAL PHOTOMETRICS - SOUTH

SCALE: 1/4" = 1'-0" 0 2' 4' 8'

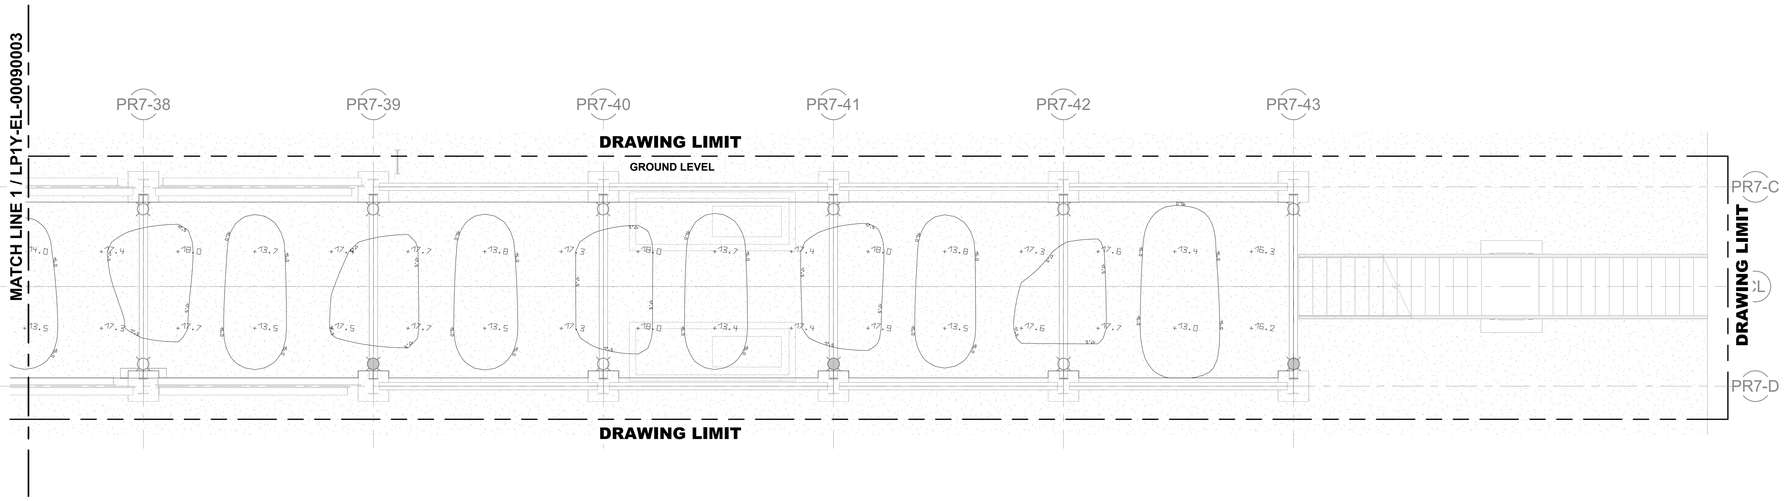

2 LIGHTING PLAN - GROUND LEVEL - NORMAL PHOTOMETRICS - NORTH

SCALE: 1/4" = 1'-0" 0 2' 4' 8'


MODULE NUMBER / AREA	LEVEL	LIGHTING CRITERIA	AVG	MAX	MIN	AVG / MIN	MAX / MIN
GROUND LEVEL	GROUND	10 FC	16.3 fc	26.3 fc	8.18 fc	1.99	3.22
STAIR LANDING	GROUND	10 FC	16.3 fc	23.8 fc	2.49 fc	6.65	9.56
STAIRS 1	GROUND	10 FC	10.9 fc	14.0 fc	7.82 fc	1.40	1.79
STAIRS 2	GROUND	10 FC	10.5 fc	15.8 fc	5.96 fc	1.76	2.64
NORTH EXIST STAIRS	PLATFORM	10 FC	17.1 fc	26.3 fc	7.55 fc	2.27	3.49
PLATFORM	PLATFORM	10 FC	13.9 fc	19.8 fc	7.56 fc	1.85	2.62
WALKWAY TO PLATFORM	PLATFORM	10 FC	14.6 fc	25.1 fc	3.31 fc	4.42	7.58

GENERAL NOTES:

1. FOOT-CANDLE VALUES INDICATE LIGHTING LEVELS AT 30 INCHES ABOVE THE FLOOR, GROUND, OR PLATFORM, WHICH ARE ON THE HORIZONTAL PLANE, EXCEPT WHEN LABELED VERTICAL.
2. ALL LIGHTING FIXTURES CUT-OFF REQUIREMENTS SHALL ADHERE TO THE TOWN OF LEBANON LAND USE CODE.
3. THE ILLUMINANCE CALCULATIONS ARE BASED ON A LIGHT LOSS FACTOR (LLF) OF 0.75 FOR LUMEN AND DIRT DEPRECIATION.
4. THE PHOTOMETRIC GRID USED IS 5 FEET BY 5 FEET FOR GROUND LEVEL, 2 FEET BY 2 FEET FOR ELEVATED PLATFORMS AND WALKWAYS, AND PROVIDES LIGHTING LEVELS DIRECTLY UNDER THE FIXTURES.
5. OUTDOOR ILLUMINATION LEVELS INDICATED DO NOT INCLUDE LIGHTING CONTRIBUTION FROM NEARBY SOURCES SUCH AS STREET LIGHTING.

REFERENCE DRAWINGS & DOCUMENTS:

DOCUMENT NUMBER	DOCUMENT TITLE
LP1Y-EP-00000113	ELECTRICAL CABLE TRAY AND GROUNDING PLAN TANK FARM, EAST - WEST PIPERACK TF500L101
LP1Y-EP-00098001	ELECTRICAL CABLE TRAY AND GROUNDING PLAN PLATFORM LEVEL - RAIL UNLOADING RACK
LP1Y-EP-00090006	ELECTRICAL UNDERGROUND GROUNDING PLAN - RAIL UNLOADING RACK
LP148-265-LST-002	ELECTRICAL CABLE LIST - E HOUSE 48
LP142-265-LST-002	ELECTRICAL CABLE LIST - E HOUSE 42
LP1Y-EP-00000324	ELECTRICAL ABOVEGROUND GROUNDING PLAN TANK FARM, EAST - WEST PIPERACK
LP100-CS-30000001	CIVIL SITE PLAN OVERALL
B1LG-00-K004-00010	OVERALL CIVIL PLANS - PHASE 2
LP1Y-EP-0009A001	ELECTRICAL CABLE TRAY AND GROUNDING PLAN GROUND LEVEL - RAIL UNLOADING RACK
LP1Y-SF-0009253	PLATFORM FRAMING PLAN - RAIL UNLOADING RACK
LP1Y-SF-0009254	CABLE TRAY SUPPORT FRAMING PLAN - RAIL UNLOADING RACK
LP1Y-265-EP-00000402	ELECTRICAL TYPICAL POWER DETAILS BUILDING Y TFS/CUB
LP1Y-EL-00090001	ELECTRICAL LIGHTING PLAN - RAIL UNLOADING RACK
LP1Y-EL-00090004 LP1Y-EL-00090005 LP1Y-EL-00090006	ELECTRICAL LIGHTING PHOTOMETRICS - RAIL UNLOADING RACK
LP1Y-EK-00000105	PANEL SCHEDULE Y-ELP/00-00-01
LP1Y-EK-00000405	JUNCTION BOX WIRING DIAGRAM
LP100-EJ-00000004 LP100-EJ-00000005	OVERALL LIGHTING FIXTURE SCHEDULE

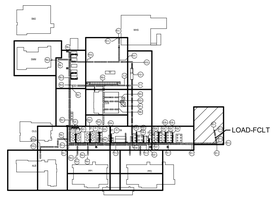

SITE - KEYPLAN

REV	ZONE	PROJECT NUMBER / DESCRIPTION	CHANGE CONTROL	DATE
B	ALL	ISSUED FOR REVIEW	NA	17-APR-2026
A	ALL	ISSUED FOR REVIEW	N/A	02-MAR-2026

REVISIONS

CONFIDENTIAL INFORMATION

THIS DRAWING AND THE IDEAS AND DESIGNS SHOWN THEREON ARE THE EXCLUSIVE PROPERTY OF ELI LILLY AND COMPANY AND ARE NOT TO BE USED, REPRODUCED OR DISCLOSED, EITHER IN WHOLE OR IN PART, WITHOUT THE WRITTEN CONSENT OF ELI LILLY AND COMPANY.

HANSON PROFESSIONAL SERVICES, INC.
www.hanson-inc.com
Offices Nationwide

11931 Wickchester Lane, Suite 370
Houston, TX 77043
(346) 297-1720

REV	DATE	DES	ENG	CHK	APP	PM APP
B	17-APR-2026	ML	AT	BM	RN	SS
A	02-MAR-2026	BM	AJT	RDN	AJT	SS

Lilly


ELECTRICAL LIGHTING PLAN - GROUND LEVEL - NORMAL PHOTOMETRICS
RAIL UNLOADING RACK

SYSTEM TYPE: NA			EDIFICE/BUILDING	LEVEL/FLOOR	
SUB DISCIPLINE	LOCATION CODE: LP1	LOCATION/GRID	CCI CODE	PROJECT NAME: LP1-306-1181	
CRITICAL QUALITY		ENTERPRISE GROUP: API	DRAWING INTENTION	DRAWING SCALE: As indicated	
CRITICAL BUSINESS		EQUIPMENT CLASSIFICATION: NA	ALTERNATE DOCUMENT ID: NA		MERIDIAN REV
CRITICAL HSE		VENDOR: NA	DOCUMENT ID: LP1Y-EL-00090003		
NON-CRITICAL		ENGINEERING AGENCY DOC ID: NA			

IF YOU ARE USING A PRINTED COPY OF THIS DOCUMENT, IT IS AN UNCONTROLLED PRINT. CONFIRM WITH THE OFFICIAL "ELECTRONIC RECORD" DOCUMENT IN THE GLOBAL ENGINEERING CONTENT MANAGEMENT SYSTEM.

IF YOU ARE USING A PRINTED COPY OF THIS DOCUMENT, IT IS AN UNCONTROLLED PRINT. CONFIRM WITH THE OFFICIAL "ELECTRONIC RECORD" DOCUMENT IN THE GLOBAL ENGINEERING CONTENT MANAGEMENT SYSTEM.

4/20/2026 8:49:40 AM Autodesk Docs://2930007 - Hanson-Fluor Lily LP1/Y-TFS-EX-000-00-00-HNS.rvt

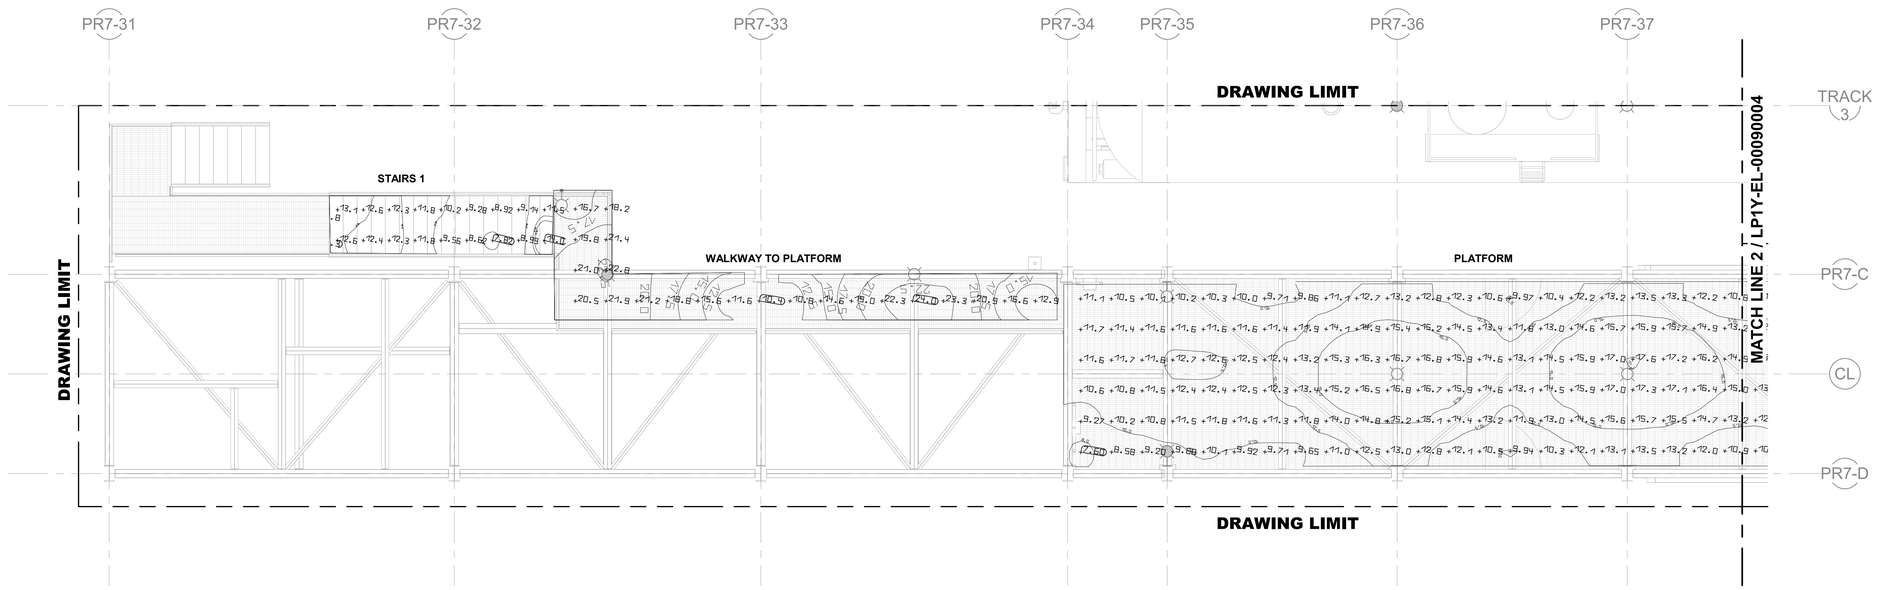


1 LIGHTING PLAN - OPERATING PLATFORM - NORMAL PHOTOMETRICS - SOUTH

SCALE: 1/4" = 1'-0" 0 4' 8' 16'

MODULE NUMBER / AREA	LEVEL	LIGHTING CRITERIA	AVG	MAX	MIN	AVG / MIN	MAX / MIN
GROUND LEVEL	GROUND	10 FC	16.3 fc	26.3 fc	8.18 fc	1.99	3.22
STAIR LANDING	GROUND	10 FC	16.3 fc	23.8 fc	2.49 fc	6.65	9.56
STAIRS 1	GROUND	10 FC	10.9 fc	14.0 fc	7.82 fc	1.40	1.79
STAIRS 2	GROUND	10 FC	10.5 fc	15.8 fc	5.96 fc	1.76	2.64
NORTH EXIST STAIRS	PLATFORM	10 FC	17.1 fc	26.3 fc	7.55 fc	2.27	3.49
PLATFORM	PLATFORM	10 FC	13.9 fc	19.8 fc	7.56 fc	1.85	2.62
WALKWAY TO PLATFORM	PLATFORM	10 FC	14.6 fc	25.1 fc	3.31 fc	4.42	7.58

GENERAL NOTES:

1. FOOT-CANDLE VALUES INDICATE LIGHTING LEVELS AT 30 INCHES ABOVE THE FLOOR, GROUND, OR PLATFORM, WHICH ARE ON THE HORIZONTAL PLANE, EXCEPT WHEN LABELED VERTICAL.
2. ALL LIGHTING FIXTURES CUT-OFF REQUIREMENTS SHALL ADHERE TO THE TOWN OF LEBANON LAND USE CODE.
3. THE ILLUMINANCE CALCULATIONS ARE BASED ON A LIGHT LOSS FACTOR (LLF) OF 0.75 FOR LUMEN AND DIRT DEPRECIATION.
4. THE PHOTOMETRIC GRID USED IS 5 FEET BY 5 FEET FOR GROUND LEVEL, 2 FEET BY 2 FEET FOR ELEVATED PLATFORMS AND WALKWAYS, AND PROVIDES LIGHTING LEVELS DIRECTLY UNDER THE FIXTURES.
5. OUTDOOR ILLUMINATION LEVELS INDICATED DO NOT INCLUDE LIGHTING CONTRIBUTION FROM NEARBY SOURCES SUCH AS STREET LIGHTING.

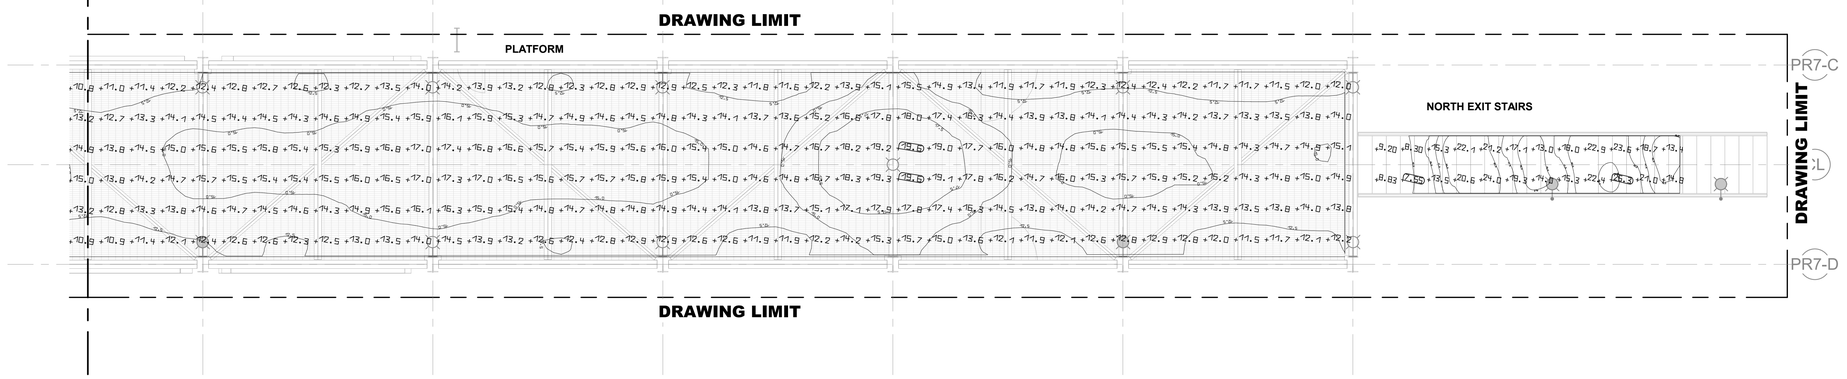


2 LIGHTING PLAN - OPERATING PLATFORM - NORMAL PHOTOMETRICS - NORTH

SCALE: 1/4" = 1'-0" 0 4' 8' 16'

REFERENCE DRAWINGS & DOCUMENTS:

DOCUMENT NUMBER	DOCUMENT TITLE
LP1Y-EP-00000113	ELECTRICAL CABLE TRAY AND GROUNDING PLAN TANK FARM, EAST - WEST PIPERACK TFS00L101
LP1Y-EP-0009B001	ELECTRICAL CABLE TRAY AND GROUNDING PLAN PLATFORM LEVEL - RAIL UNLOADING RACK
LP1Y-EP-00090006	ELECTRICAL UNDERGROUND GROUNDING PLAN - RAIL UNLOADING RACK
LP148-265-LST-002	ELECTRICAL CABLE LIST - E HOUSE 48
LP142-265-LST-002	ELECTRICAL CABLE LIST - E HOUSE 42
LP1Y-EP-00000324	ELECTRICAL ABOVEGROUND GROUNDING PLAN TANK FARM, EAST - WEST PIPERACK
LP100-CS-30000001	CIVIL SITE PLAN OVERALL
B1LG-00-K004-00010	OVERALL CIVIL PLANS - PHASE 2
LP1Y-EP-0009A001	ELECTRICAL CABLE TRAY AND GROUNDING PLAN GROUND LEVEL - RAIL UNLOADING RACK
LP1Y-SF-0009253	PLATFORM FRAMING PLAN - RAIL UNLOADING RACK
LP1Y-SF-0009254	CABLE TRAY SUPPORT FRAMING PLAN - RAIL UNLOADING RACK
LP1Y-265-EP-00000402	ELECTRICAL TYPICAL POWER DETAILS BUILDING Y TFS/CUB
LP1Y-EL-00090001	ELECTRICAL LIGHTING PLAN - RAIL UNLOADING RACK
LP1Y-EL-00090003 LP1Y-EL-00090005 LP1Y-EL-00090006	ELECTRICAL LIGHTING PHOTOMETRICS - RAIL UNLOADING RACK
LP1Y-EK-00000105	PANEL SCHEDULE Y-ELP/00-00-01
LP1Y-EK-00000405	JUNCTION BOX WIRING DIAGRAM
LP100-EJ-00000004 LP100-EJ-00000005	OVERALL LIGHTING FIXTURE SCHEDULE

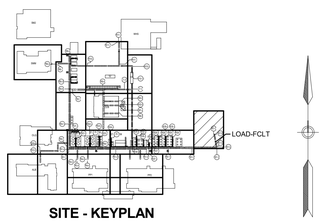

SITE - KEYPLAN

HANSON PROFESSIONAL SERVICES, INC.
www.hanson-inc.com
Offices Nationwide
11931 Wickchester Lane, Suite 370
Houston, TX 77043
(346) 297-1720

REV	DATE	DES	ENG	CHK	APP	PM APP
B	17-APR-2026	ML	AT	BM	RN	SS
A	02-MAR-2026	BM	AJT	RDN	AJT	SS

ELECTRICAL LIGHTING PLAN - PLATFORM LEVEL - NORMAL PHOTOMETRICS

RAIL UNLOADING RACK

REV	ZONE	PROJECT NUMBER / DESCRIPTION	CHANGE CONTROL	DATE
B	ALL	ISSUED FOR REVIEW	NA	17-APR-2026
A	ALL	ISSUED FOR REVIEW	N/A	02-MAR-2026

REVISIONS


CONFIDENTIAL INFORMATION
THIS DRAWING AND THE IDEAS AND DESIGNS SHOWN THEREON ARE THE EXCLUSIVE PROPERTY OF ELI LILLY AND COMPANY AND ARE NOT TO BE USED, REPRODUCED OR DISCLOSED, EITHER IN WHOLE OR IN PART, WITHOUT THE WRITTEN CONSENT OF ELI LILLY AND COMPANY.

SYSTEM TYPE: NA		EDIFICE/BUILDING	LEVEL/FLOOR
SUB DISCIPLINE	LOCATION CODE: LP1 / LOCATION/GRID	CCI CODE	PROJECT NAME: LP1-306-1181
CRITICAL QUALITY	ENTERPRISE GROUP: API	DRAWING INTENTION	DRAWING SCALE: As indicated
CRITICAL BUSINESS	EQUIPMENT CLASSIFICATION: NA	ALTERNATE DOCUMENT ID: NA	MERIDIAN REV
CRITICAL HSE	VENDOR: NA	DOCUMENT ID: LP1Y-EL-00090004	
NON-CRITICAL	ENGINEERING AGENCY DOC ID: NA		

IF YOU ARE USING A PRINTED COPY OF THIS DOCUMENT, IT IS AN UNCONTROLLED PRINT. CONFIRM WITH THE OFFICIAL "ELECTRONIC RECORD" DOCUMENT IN THE GLOBAL ENGINEERING CONTENT MANAGEMENT SYSTEM.

IF YOU ARE USING A PRINTED COPY OF THIS DOCUMENT, IT IS AN UNCONTROLLED PRINT. CONFIRM WITH THE OFFICIAL "ELECTRONIC RECORD" DOCUMENT IN THE GLOBAL ENGINEERING CONTENT MANAGEMENT SYSTEM.

4/20/2026 8:45:41 AM Autodesk Docs://250007 - Hanson-Fluor Lily,LP1Y-TFS-EI-000-000-00-HNS.rvt

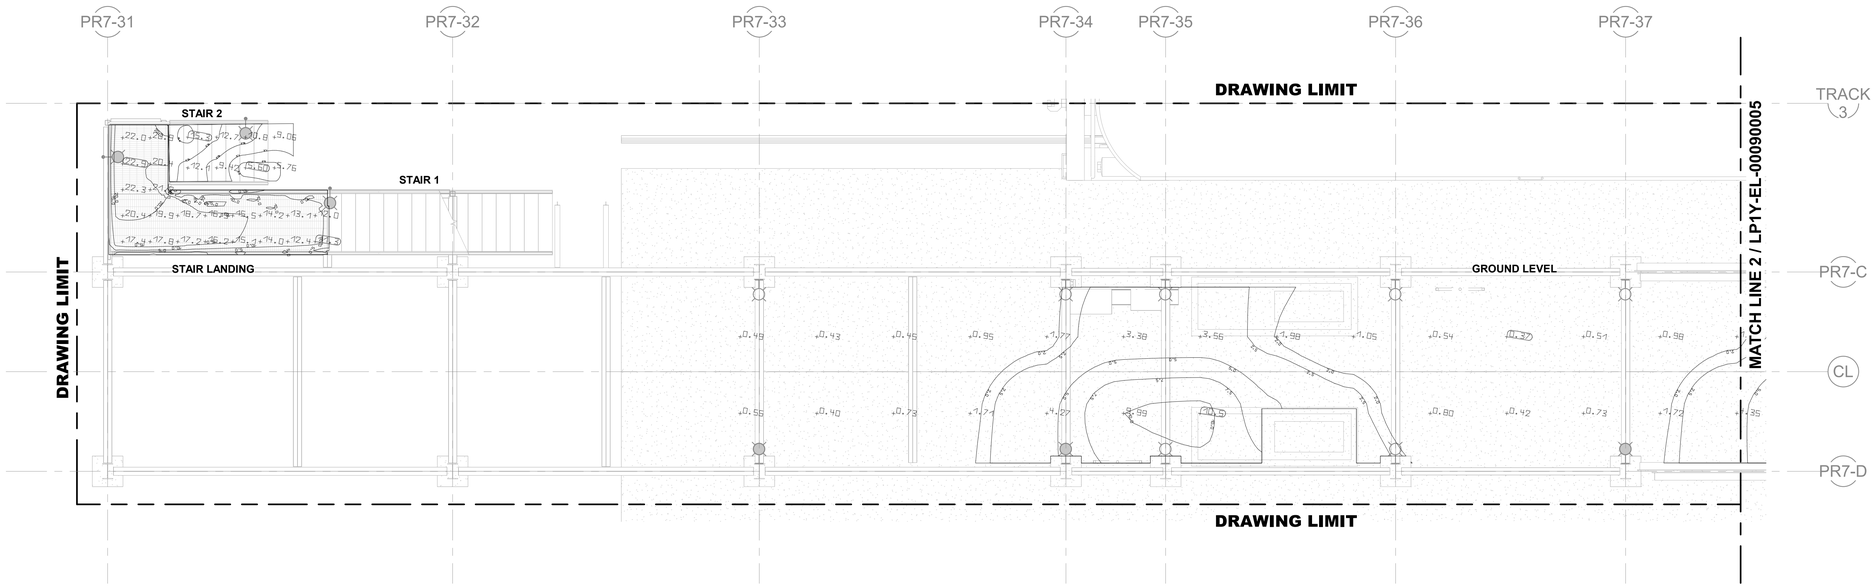

1 LIGHTING PLAN - GROUND LEVEL - EMERGENCY PHOTOMETRICS - SOUTH

SCALE: 1/4" = 1'-0" 0 4' 8' 16'

2 LIGHTING PLAN - GROUND LEVEL - EMERGENCY PHOTOMETRICS - NORTH

SCALE: 1/4" = 1'-0" 0 4' 8' 16'


AREA	LEVEL	LIGHTING CRITERIA	AVG
GROUND LEVEL	GROUND	1 fc	3.27 fc
STAIR LANDING	GROUND	10 fc	15.5 fc
STAIRS 1	GROUND	10 fc	10.6 fc
STAIRS 2	GROUND	10 fc	10.1 fc
NORTH EXIST STAIRS	PLATFORM	10 fc	14.2 fc
PLATFORM	PLATFORM	1 fc	2.46 fc
WALKWAY TO PLATFORM	PLATFORM	1 fc	10.6 fc

GENERAL NOTES:

1. FOOT-CANDLE VALUES INDICATE LIGHTING LEVELS AT 30 INCHES ABOVE THE FLOOR, GROUND, OR PLATFORM, WHICH ARE ON THE HORIZONTAL PLANE, EXCEPT WHEN LABELED VERTICAL.
2. ALL LIGHTING FIXTURES CUT-OFF REQUIREMENTS SHALL ADHERE TO THE TOWN OF LEBANON LAND USE CODE.
3. THE ILLUMINANCE CALCULATIONS ARE BASED ON A LIGHT LOSS FACTOR (LLF) OF 0.75 FOR LUMEN AND DIRT DEPRECIATION.
4. THE PHOTOMETRIC GRID USED IS 5 FEET BY 5 FEET FOR GROUND LEVEL, 2 FEET BY 2 FEET FOR ELEVATED PLATFORMS AND WALKWAYS, AND PROVIDES LIGHTING LEVELS DIRECTLY UNDER THE FIXTURES.
5. OUTDOOR ILLUMINATION LEVELS INDICATED DO NOT INCLUDE LIGHTING CONTRIBUTION FROM NEARBY SOURCES SUCH AS STREET LIGHTING.

REFERENCE DRAWINGS & DOCUMENTS:

DOCUMENT NUMBER	DOCUMENT TITLE
LP1Y-EP-00000113	ELECTRICAL CABLE TRAY AND GROUNDING PLAN TANK FARM, EAST - WEST PIPERACK TFS00L101
LP1Y-EP-0009B001	ELECTRICAL CABLE TRAY AND GROUNDING PLAN PLATFORM LEVEL - RAIL UNLOADING RACK
LP1Y-EP-00090006	ELECTRICAL UNDERGROUND GROUNDING PLAN - RAIL UNLOADING RACK
LP148-265-LST-002	ELECTRICAL CABLE LIST - E HOUSE 48
LP142-265-LST-002	ELECTRICAL CABLE LIST - E HOUSE 42
LP1Y-EP-00000324	ELECTRICAL ABOVEGROUND GROUNDING PLAN TANK FARM, EAST - WEST PIPERACK
LP100-CS-30000001	CIVIL SITE PLAN OVERALL
B1LG-00-K004-00010	OVERALL CIVIL PLANS - PHASE 2
LP1Y-EP-0009A001	ELECTRICAL CABLE TRAY AND GROUNDING PLAN GROUND LEVEL - RAIL UNLOADING RACK
LP1Y-SF-0009253	PLATFORM FRAMING PLAN - RAIL UNLOADING RACK
LP1Y-SF-0009254	CABLE TRAY SUPPORT FRAMING PLAN - RAIL UNLOADING RACK
LP1Y-265-EP-00000402	ELECTRICAL TYPICAL POWER DETAILS BUILDING Y TFS/CUB
LP1Y-EL-00090001	ELECTRICAL LIGHTING PLAN - RAIL UNLOADING RACK
LP1Y-EL-00090003 LP1Y-EL-00090004 LP1Y-EL-00090006	ELECTRICAL LIGHTING PHOTOMETRICS - RAIL UNLOADING RACK
LP1Y-EK-00000105	PANEL SCHEDULE Y-ELP/00-00-01
LP1Y-EK-00000405	JUNCTION BOX WIRING DIAGRAM
LP100-EJ-00000004 LP100-EJ-00000005	OVERALL LIGHTING FIXTURE SCHEDULE

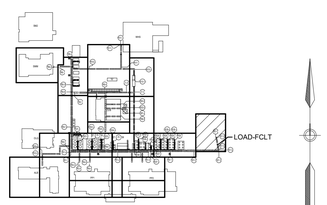

SITE - KEYPLAN

REV	ZONE	PROJECT NUMBER / DESCRIPTION	CHANGE CONTROL	DATE
B	ALL	ISSUED FOR REVIEW	NA	17-APR-2026
A	ALL	ISSUED FOR REVIEW	N/A	02-MAR-2026

REVISIONS

CONFIDENTIAL INFORMATION

THIS DRAWING AND THE IDEAS AND DESIGNS SHOWN THEREON ARE THE EXCLUSIVE PROPERTY OF ELI LILLY AND COMPANY AND ARE NOT TO BE USED, REPRODUCED OR DISCLOSED, EITHER IN WHOLE OR IN PART, WITHOUT THE WRITTEN CONSENT OF ELI LILLY AND COMPANY.

HANSON™
HANSON PROFESSIONAL SERVICES, INC.
www.hanson-inc.com
Offices Nationwide
11931 Wickchester Lane, Suite 370
Houston, TX 77043
(346) 297-1720

REV	DATE	DES	ENG	CHK	APP	PM APP
B	17-APR-2026	ML	AT	BM	RN	SS
A	02-MAR-2026	BM	AJT	RDN	AJT	SS

Lilly

ELECTRICAL LIGHTING PLAN - GROUND LEVEL - EMERGENCY PHOTOMETRICS


RAIL UNLOADING RACK

SYSTEM TYPE: NA			EDIFICE/BUILDING	LEVEL/FLOOR
SUB DISCIPLINE	LOCATION CODE: LP1	LOCATION/GRID	CCI CODE	PROJECT NAME: LP1-306-1181
CRITICAL QUALITY		ENTERPRISE GROUP: API	DRAWING INTENTION	DRAWING SCALE: As indicated
CRITICAL BUSINESS		EQUIPMENT CLASSIFICATION: NA	ALTERNATE DOCUMENT ID: NA	MERIDIAN REV
CRITICAL HSE		VENDOR: NA	DOCUMENT ID	LP1Y-EL-00090005
NON-CRITICAL		ENGINEERING AGENCY DOC ID: NA		

IF YOU ARE USING A PRINTED COPY OF THIS DOCUMENT, IT IS AN UNCONTROLLED PRINT. CONFIRM WITH THE OFFICIAL "ELECTRONIC RECORD" DOCUMENT IN THE GLOBAL ENGINEERING CONTENT MANAGEMENT SYSTEM.


IF YOU ARE USING A PRINTED COPY OF THIS DOCUMENT, IT IS AN UNCONTROLLED PRINT. CONFIRM WITH THE OFFICIAL "ELECTRONIC RECORD" DOCUMENT IN THE GLOBAL ENGINEERING CONTENT MANAGEMENT SYSTEM.

4/20/2026 8:49:42 AM Autodesk Docs://250007 - Hanson-Fluor Lilly's P1/01-TFS-EL-000-00-4NS.rvt

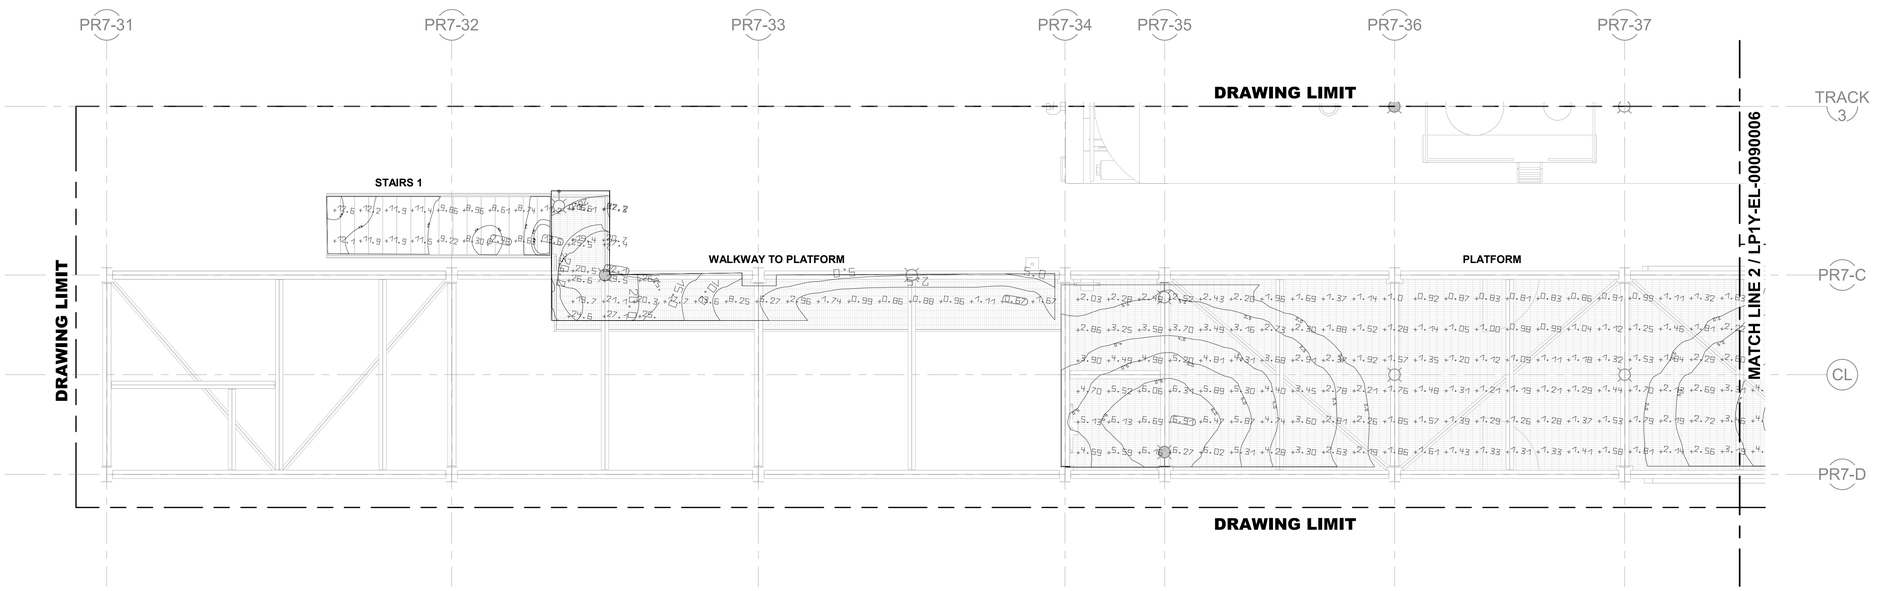

1 LIGHTING PLAN - OPERATING PLATFORM - EMERGENCY PHOTOMETRICS - SOUTH

SCALE: 1/4" = 1'-0" 0 4' 8' 16'

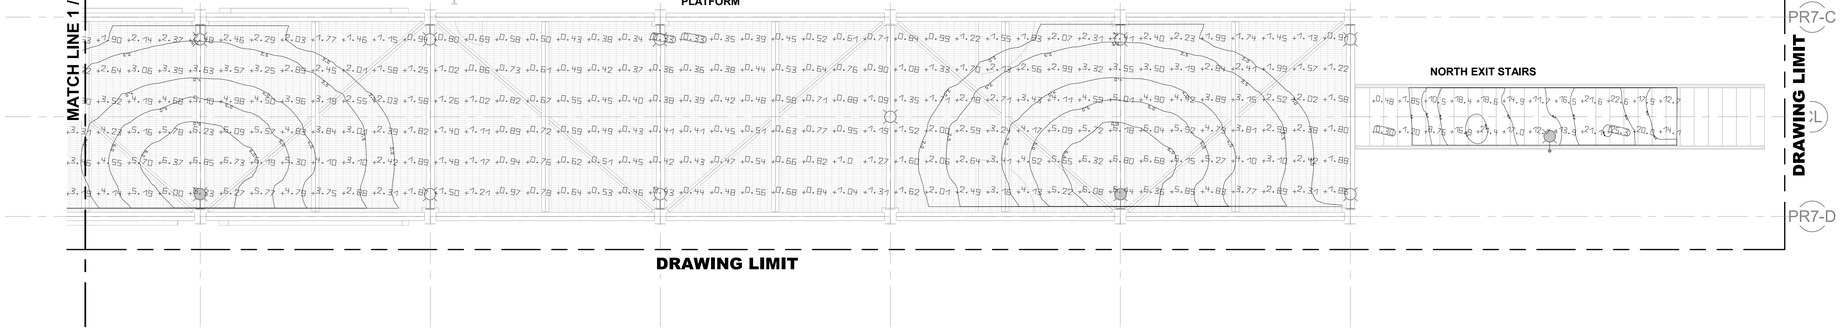

2 LIGHTING PLAN - OPERATING PLATFORM - EMERGENCY PHOTOMETRICS - NORTH

SCALE: 1/4" = 1'-0" 0 4' 8' 16'


AREA	LEVEL	LIGHTING CRITERIA	AVG
GROUND LEVEL	GROUND	1 fc	3.27 fc
STAIR LANDING	GROUND	10 fc	15.5 fc
STAIRS 1	GROUND	10 fc	10.6 fc
STAIRS 2	GROUND	10 fc	10.1 fc
NORTH EXIST STAIRS	PLATFORM	10 fc	14.2 fc
PLATFORM	PLATFORM	1 fc	2.46 fc
WALKWAY TO PLATFORM	PLATFORM	1 fc	10.6 fc

GENERAL NOTES:

1. FOOT-CANDLE VALUES INDICATE LIGHTING LEVELS AT 30 INCHES ABOVE THE FLOOR, GROUND, OR PLATFORM, WHICH ARE ON THE HORIZONTAL PLANE, EXCEPT WHEN LABELED VERTICAL.
2. ALL LIGHTING FIXTURES CUT-OFF REQUIREMENTS SHALL ADHERE TO THE TOWN OF LEBANON LAND USE CODE.
3. THE ILLUMINANCE CALCULATIONS ARE BASED ON A LIGHT LOSS FACTOR (LLF) OF 0.75 FOR LUMEN AND DIRT DEPRECIATION.
4. THE PHOTOMETRIC GRID USED IS 5 FEET BY 5 FEET FOR GROUND LEVEL, 2 FEET BY 2 FEET FOR ELEVATED PLATFORMS AND WALKWAYS, AND PROVIDES LIGHTING LEVELS DIRECTLY UNDER THE FIXTURES.
5. OUTDOOR ILLUMINATION LEVELS INDICATED DO NOT INCLUDE LIGHTING CONTRIBUTION FROM NEARBY SOURCES SUCH AS STREET LIGHTING.

REFERENCE DRAWINGS & DOCUMENTS:

DOCUMENT NUMBER	DOCUMENT TITLE
LP1Y-EP-00000113	ELECTRICAL CABLE TRAY AND GROUNDING PLAN TANK FARM, EAST - WEST PIPERACK TFS00L101
LP1Y-EP-0009B001	ELECTRICAL CABLE TRAY AND GROUNDING PLAN PLATFORM LEVEL - RAIL UNLOADING RACK
LP1Y-EP-00090006	ELECTRICAL UNDERGROUND GROUNDING PLAN - RAIL UNLOADING RACK
LP148-265-LST-002	ELECTRICAL CABLE LIST - E HOUSE 48
LP142-265-LST-002	ELECTRICAL CABLE LIST - E HOUSE 42
LP1Y-EP-00000324	ELECTRICAL ABOVEGROUND GROUNDING PLAN TANK FARM, EAST - WEST PIPERACK
LP100-CS-30000001	CIVIL SITE PLAN OVERALL
B1LG-00-K004-00010	OVERALL CIVIL PLANS - PHASE 2
LP1Y-EP-0009A001	ELECTRICAL CABLE TRAY AND GROUNDING PLAN GROUND LEVEL - RAIL UNLOADING RACK
LP1Y-SF-0009253	PLATFORM FRAMING PLAN - RAIL UNLOADING RACK
LP1Y-SF-0009254	CABLE TRAY SUPPORT FRAMING PLAN - RAIL UNLOADING RACK
LP1Y-265-EP-00000402	ELECTRICAL TYPICAL POWER DETAILS BUILDING Y TFS/CUB
LP1Y-EL-00090001	ELECTRICAL LIGHTING PLAN - RAIL UNLOADING RACK
LP1Y-EL-00090003 LP1Y-EL-00090004 LP1Y-EL-00090005	ELECTRICAL LIGHTING PHOTOMETRICS - RAIL UNLOADING RACK
LP1Y-EK-00000105	PANEL SCHEDULE Y-ELP/00-00-01
LP1Y-EK-00000405	JUNCTION BOX WIRING DIAGRAM
LP100-EJ-00000004 LP100-EJ-00000005	OVERALL LIGHTING FIXTURE SCHEDULE

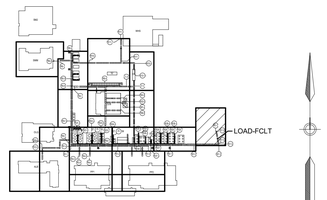

SITE - KEYPLAN

REV	ZONE	PROJECT NUMBER / DESCRIPTION	CHANGE CONTROL	DATE
B	ALL	ISSUED FOR REVIEW	NA	17-APR-2026
A	ALL	ISSUED FOR REVIEW	N/A	02-MAR-2026

REVISIONS

CONFIDENTIAL INFORMATION
THIS DRAWING AND THE IDEAS AND DESIGNS SHOWN THEREON ARE THE EXCLUSIVE PROPERTY OF ELI LILLY AND COMPANY AND ARE NOT TO BE USED, REPRODUCED OR DISCLOSED, EITHER IN WHOLE OR IN PART, WITHOUT THE WRITTEN CONSENT OF ELI LILLY AND COMPANY.

HANSON PROFESSIONAL SERVICES, INC.
www.hanson-inc.com
Offices Nationwide
11931 Wickchester Lane, Suite 370
Houston, TX 77043
(346) 297-1720

REV	DATE	DES	ENG	CHK	APP	PM APP
1	17-APR-2026	ML	AT	BM	RN	SS
0	02-MAR-2026	BM	AJT	RDN	AJT	SS

Lilly

ELECTRICAL LIGHTING PLAN - PLATFORM LEVEL - EMERGENCY PHOTOMETRICS


RAIL UNLOADING RACK

SYSTEM TYPE: NA				EDIFICE/BUILDING	LEVEL/FLOOR
SUB DISCIPLINE	LOCATION CODE: LP1	LOCATION/GRID		CCI CODE	PROJECT NAME: LP1-306-1181
CRITICAL QUALITY		ENTERPRISE GROUP: API		DRAWING INTENTION	DRAWING SCALE: As indicated
CRITICAL BUSINESS		EQUIPMENT CLASSIFICATION: NA		ALTERNATE DOCUMENT ID: NA	MERIDIAN REV
CRITICAL HSE		VENDOR: NA		DOCUMENT ID	LP1Y-EL-00090006
NON-CRITICAL		ENGINEERING AGENCY DOC ID: NA			


IF YOU ARE USING A PRINTED COPY OF THIS DOCUMENT, IT IS AN UNCONTROLLED PRINT. CONFIRM WITH THE OFFICIAL "ELECTRONIC RECORD" DOCUMENT IN THE GLOBAL ENGINEERING CONTENT MANAGEMENT SYSTEM.

IF YOU ARE USING A PRINTED COPY OF THIS DOCUMENT, IT IS AN UNCONTROLLED PRINT. CONFIRM WITH THE OFFICIAL "ELECTRONIC RECORD" DOCUMENT IN THE GLOBAL ENGINEERING CONTENT MANAGEMENT SYSTEM.


4/20/2026 8:49:43 AM Autodesk Docs://290007 - Hanson-Fluor Lilly/LP1Y-TFS-EI-000-000-00-HNS.rvt

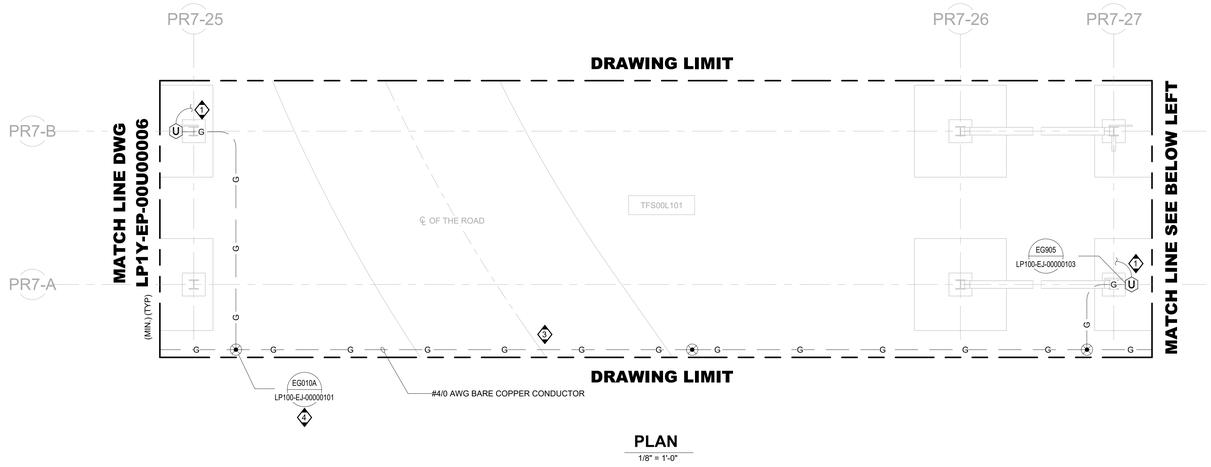

PLAN
1/8" = 1'-0"

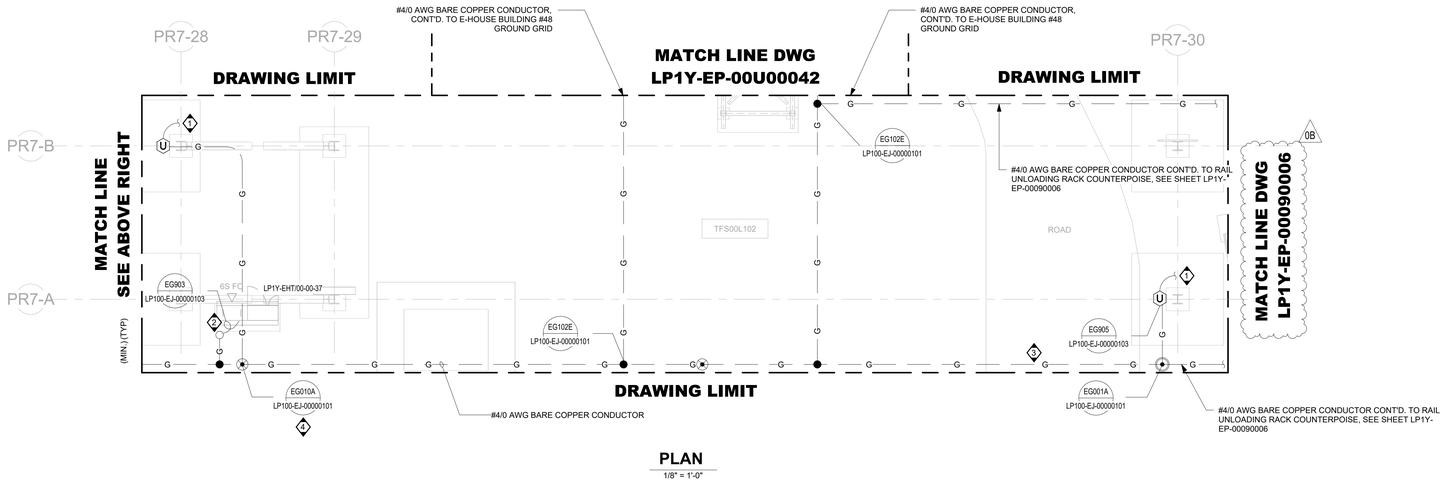

PLAN
1/8" = 1'-0"

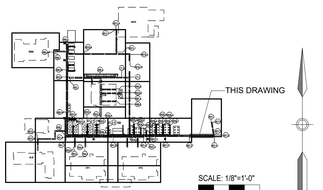

SITE - KEYPLAN

GENERAL NOTES:

1. THE ELECTRICAL INSTALLATION SHALL COMPLY WITH THE 2009 EDITION OF THE INDIANA ELECTRICAL CODE AND THE 2023 NATIONAL ELECTRICAL CODE. IF THERE ARE DISCREPANCIES BETWEEN THE 2009 INDIANA ELECTRICAL CODE AND 2023 NEC, THE MOST STRINGENT REQUIREMENT SHALL APPLY.
2. ALL DIMENSIONS AND ELEVATIONS ARE IN FEET AND INCHES UNLESS NOTED OTHERWISE.
3. REFER TO CIVIL DRAWING B1LG-00-K004-00010 FOR FINISHED GRADE ELEVATION. ELEVATIONS SHOWN ARE PLANT COORDINATES. GEODETIC ELEVATION 926'-9 3/5" IS EQUAL TO PLANT COORDINATE ELEVATION 100'-0".
4. THE MAIN GROUND LOOP SHALL BE #4/0 AWG BARE STRANDED COPPER CABLE AND SHALL BE INSTALLED 2'-6" MINIMUM FROM OUTSIDE THE FOUNDATION AND BURIED 2'-6" MINIMUM BELOW FINISHED GRADE.
5. GROUND CABLES PENETRATING THROUGH FLOOR SLABS SHALL BE INSTALLED IN A 1-1/4" SCHEDULE 40 PVC CONDUIT SLEEVE PER DETAIL EG903 THAT EXTENDS 4" ABOVE FINISHED FLOOR AND GROUND CABLE SHALL EXTEND 10'-0" ABOVE FINISHED FLOOR FOR CONNECTION TO EQUIPMENT OR GROUND BUS BARS.
6. LOCATION OF RODS, TEST WELLS, GROUND CONDUCTORS AND EQUIPMENT GROUNDS ARE SHOWN DIAGRAMATICALLY. EXACT LOCATIONS SHALL BE DETERMINED IN THE FIELD.
7. CONSTRUCTION SHALL COORDINATE THE GROUNDING SYSTEM ROUTING TO AVOID UNDERGROUND AND ABOVEGROUND OBSTRUCTIONS PRIOR TO ANY EXCAVATION OR INSTALLATION WORK FOR THE GROUNDING SYSTEM.
8. ISOLATED, SENSITIVE ELECTRONIC GROUNDING ELECTRODE SYSTEMS SHALL BE INSTALLED AS INDICATED ON THE DRAWINGS AND SHALL BE BONDED TO OTHER GROUNDING ELECTRODES ON THE PREMISES AT ONE LOCATION.
9. GROUND CONDUCTORS EXPOSED OR ENCASED IN CONCRETE SHALL BE INSTALLED IN SCHEDULE 40 PVC CONDUIT WITH NON METALLIC BUSHINGS AT BOTH ENDS.
10. UFER GROUND WILL HAVE BARE GROUND WIRES ENCASED IN CONCRETE.
11. GROUND ROD SHALL BE INSTALLED APPROX. 60FT. (MAX) APART.
12. THE GROUNDING SYSTEM SHALL HAVE A RESISTANCE TO GROUND OF 1 Ω OR LESS.
13. CONTRACTOR SHALL USE THE INSTALLATION DETAILS AS SHOWN ON THE LAYOUT DRAWING. WHERE INSTALLATION DETAILS ARE NOT SHOWN OR CLOSEST DETAIL IS SHOWN, CONTRACTOR TO VERIFY AND USE APPROPRIATE INSTALLATION DETAILS FROM GROUNDING INSTALLATION DETAILS. SEE REFERENCE DRAWINGS TABLE BELOW.
14. INSTALLATION CONTRACTOR SHALL COORDINATE WITH LIGHTNING PROTECTION CONTRACTOR FOR LIGHTNING PROTECTION GROUNDING.

SHEET NOTES:

1. INSTALLATION CONTRACTOR SHALL COIL AND PROTECT 10' #4/0 AWG GREEN INSULATED COPPER STRANDED GROUND CONDUCTOR FOR CONNECTION TO STEEL COLUMN.
2. INSTALLATION CONTRACTOR SHALL COIL AND PROTECT #4/0 AWG GREEN INSULATED COPPER STRANDED GROUND CONDUCTOR FOR EQUIPMENT GROUNDING.
3. ENCASE GROUND CONDUCTOR INSIDE 1" SCHEDULE 80 CONDUIT WHERE GROUND CONDUCTOR RUNS UNDER ROADWAY. CONDUIT SHALL EXTEND AT LEAST 3 FT. FROM EDGE OF THE OPEN DITCH. CONDUIT SHALL BE SEALED AFTER CABLE INSTALLATION. CONDUIT SHALL BE INSTALLED AT 3 FT. DEPTH FROM FINISHED GRADE.
4. GROUND ROD SHALL BE INSTALLED FOR EACH UFER GROUND CONNECTION AS SHOWN, AND ADDITIONAL GROUND RODS IN BETWEEN APPROX. 60 FT. (MAX.) APART. CONTRACTOR TO ADD ADDITIONAL CONNECTIONS TO GROUND RODS AS REQUIRED.

REFERENCE DRAWINGS & DOCUMENTS:

DOCUMENT NUMBER	DOCUMENT TITLE
LP1Y-EL-00000302	ELECTRICAL DRAWING INDEX TANK FARM ABOVEGROUND AND UNDERGROUND GROUNDING
LP100-EJ-00000100 SERIES DRAWINGS	ELECTRICAL GROUNDING DETAILS
LP100-EJ-00000001 THRU LP100-EJ-00000003	GENERAL NOTES, LEGEND AND SYMBOLS
LP1Y-EP-00U00042	ELECTRICAL UNDERGROUND GROUNDING PLAN TANK FARM, E-HOUSE 48
LP1Y-EP-00000324	ELECTRICAL ABOVEGROUND GROUNDING PLAN TANK FARM, EAST - WEST PIPERACK
LP100-EP-00000006	ELECTRICAL SITE GROUNDING PLAN SITE 00, AREA 6
LP100-EP-00000008	ELECTRICAL SITE GROUNDING PLAN SITE 00, AREA 8
LP1Y-SF-0009P000	STRUCTURAL FOUNDATIONS BUILDING Y, SECTOR 9 - TFS00L101, TFS00L102, & CABLE TRAY SUPT STR
LP100-CS-30000001	CIVIL SITE PLAN OVERALL
B1LG-00-K004-00010	OVERALL CIVIL PLANS - PHASE 2
LP1Y-EP-00090006	ELECTRICAL UNDERGROUND GROUNDING PLAN - RAIL UNLOADING RACK

REV	DATE	DES	ENG	CHK	APP	PM APP
0B	17-APR-2026	ML	AT	BM	RN	SS
0A	02-MAR-2026	ML	AJT	RDN	AJT	SS
0	28-AUG-2025	AM	MS	EA	TL	EM
A	09-MAY-2025	AM	MS	EA	TL	EM

FLUOR® EFDEE Engineering PC PROJECT NO: B1LG NODE: TFS

Lilly

ELECTRICAL UNDERGROUND GROUNDING PLAN
TANK FARM, EAST - WEST PIPERACK

REV	ZONE	PROJECT NUMBER / DESCRIPTION	CHANGE CONTROL	DATE
0B	ALL	ISSUED FOR REVIEW	NA	17-APR-2026
0A	ALL	ISSUED FOR REVIEW	NA	02-MAR-2026
0	ALL	ISSUED FOR CONSTRUCTION	NA	28-AUG-2025
A	ALL	ISSUED FOR REVIEW	NA	09-MAY-2025

REVISIONS

CONFIDENTIAL INFORMATION:
THIS DRAWING AND THE IDEAS AND DESIGNS SHOWN THEREON ARE THE EXCLUSIVE PROPERTY OF ELI LILLY AND COMPANY AND ARE NOT TO BE USED, REPRODUCED OR DISCLOSED, EITHER IN WHOLE OR IN PART, WITHOUT THE WRITTEN CONSENT OF ELI LILLY AND COMPANY.


SYSTEM TYPE: NA		EDIFICE/BUILDING: Y	LEVEL/FLOOR: 0
SUB DISCIPLINE: EP	LOCATION CODE: LP1	LOCATION/GRID	CCI CODE: YELLOW
CRITICAL QUALITY		ENTERPRISE GROUP: API	DRAWING INTENTION
CRITICAL BUSINESS		EQUIPMENT CLASSIFICATION: NA	ALTERNATE DOCUMENT ID: NA
CRITICAL HSE		VENDOR: NA	DOCUMENT ID: LP1Y-EP-00U00027
NON-CRITICAL		ENGINEERING AGENCY DOC ID: NA	

PROJECT NAME: LP1-306-1181
DRAWING SCALE: 1/8" = 1'-0"
MERIDIAN REV: 0B

Autodesk Docs://1906007 - Monaco Plus/Lilly/LP1Y-TFS-ES-000-000-00-FGL_detached.rvt
4/29/2026 1:49:58 PM


IF YOU ARE USING A PRINTED COPY OF THIS DOCUMENT, IT IS AN UNCONTROLLED PRINT. CONFIRM WITH THE OFFICIAL "ELECTRONIC RECORD" DOCUMENT IN THE GLOBAL ENGINEERING CONTENT MANAGEMENT SYSTEM.

IF YOU ARE USING A PRINTED COPY OF THIS DOCUMENT, IT IS AN UNCONTROLLED PRINT. CONFIRM WITH THE OFFICIAL "ELECTRONIC RECORD" DOCUMENT IN THE GLOBAL ENGINEERING CONTENT MANAGEMENT SYSTEM.

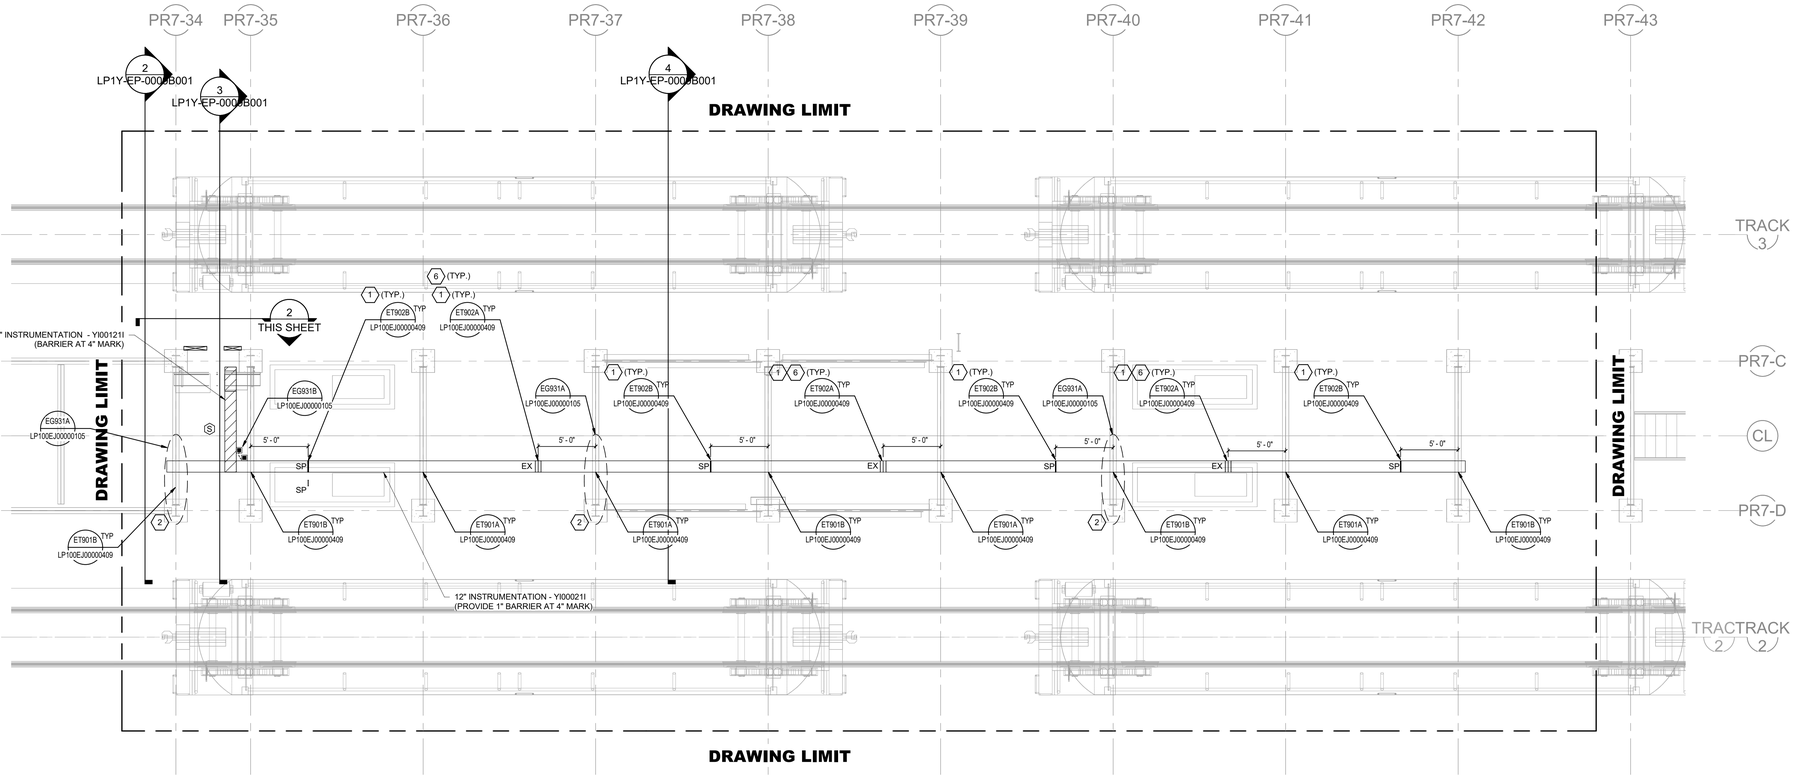

1 CABLE TRAY PLAN - GROUND LEVEL

SCALE: 3/16" = 1'-0"

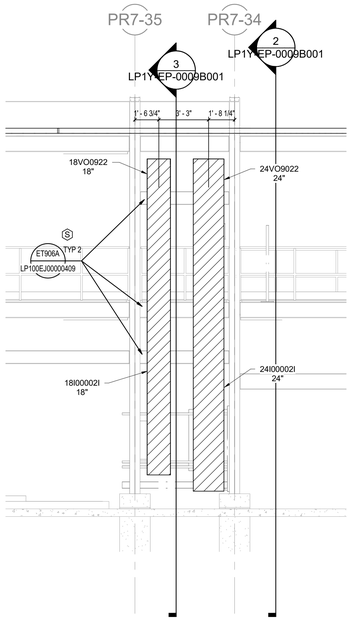


2 SECTION

SCALE: 1/4" = 1'-0"

LEGEND & SYMBOLS:

- (S) OR ▨ SHIP LOOSE
- SCOPE SPLIT
- EX EXPANSION JOINT

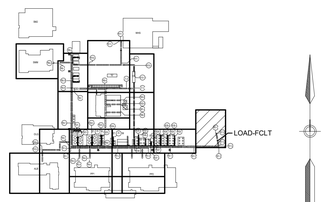

SITE - KEYPLAN

GENERAL NOTES:

1. ALL DIMENSIONS AND ELEVATIONS ARE IN FEET AND INCHES UNLESS NOTED OTHERWISE.
2. REFER TO CIVIL DRAWING B1LG-00-K004-00010 AND RAIL UNLOADING RACK STRUCTURAL DRAWINGS FOR FINISHED GRADE ELEVATION. ELEVATIONS SHOWN ARE PLANT COORDINATES. GEODETIC ELEVATION 926'-9 3/5" IS EQUAL TO PLANT COORDINATE ELEVATION 100'-0".
3. THE ELECTRICAL INSTALLATION SHALL COMPLY WITH THE 2009 EDITION OF THE INDIANA ELECTRICAL CODE AND THE 2023 NATIONAL ELECTRICAL CODE. IF THERE ARE DISCREPANCIES BETWEEN THE 2009 INDIANA ELECTRICAL CODE AND 2023 NEC, THE MOST STRINGENT REQUIREMENT SHALL APPLY.
4. REFER TO DRAWING LP100-EJ-00000001 FOR GENERAL NOTES AND DRAWINGS LP100-EJ-00000002 AND LP100-EJ-00000103 FOR LEGEND AND SYMBOLS.
5. REFER TO DRAWINGS LP100-EJ-00000400 SERIES FOR STANDARD CABLE TRAY INSTALLATION DETAILS.
6. REFER TO DRAWING LP100-EJ-00000100 SERIES FOR STANDARD GROUNDING INSTALLATION DETAILS.
7. REFER TO LP100-EJ-00000409 (ET903) FOR MODULE CABLE TRAY INSTALLATION GUIDE.
8. MODULE CONTRACTOR SHALL ENSURE ALL MATERIALS ATTACHED TO THE MODULE WILL NOT EXCEED THE SHIPPING VOLUME OF THE MODULE.
9. REFER TO LP100-265-EMS-16110 FOR CABLE TRAY SPECIFICATION AND CABLE TRAY COVER INSTALLATION REQUIREMENTS. TRAY COVERS, WHERE REQUIRED, SHALL BE INSTALLED AFTER ALL CABLES ARE PULLED AND SECURED.
10. CABLE TRAY SHALL BE 6" DEEP, 20FT SPANS, HEAVY-DUTY ALUMINIUM, LADDER TYPE WITH 9" RUNG SPACING, NEMA CLASS 20C+ UNLESS SPECIFIED OTHERWISE. CABLE TRAY DESIGN BASIS IS B-LINE H46A HEAVY DUTY CABLE TRAY OR APPROVED EQUAL. ANY DEVIATIONS MAY REQUIRE CHANGES IN SUPPORTS, DESIGN, DETAILS, LOAD CAPACITIES, ETC. ANY CHANGES THAT RESULT IN CHANGES INCLUDING COSTS AND SCHEDULE SHALL BE BORNE BY THE CONTRACTOR.
11. INSTALLATION DETAILS SHOW TYPICAL CABLE TRAY FITTING TYPES TO BE USED. CONTRACTOR SHALL USE HEAVY-DUTY FITTINGS FOR ALL INSTALLATIONS INDICATED ON PLAN DRAWINGS.
12. CONTRACTOR SHALL USE THE INSTALLATION DETAILS AS SHOWN ON THIS PLAN DRAWING. WHERE INSTALLATION DETAILS ARE NOT SHOWN, CONTRACTOR SHALL VERIFY AND USE APPROPRIATE INSTALLATION DETAILS FROM TRAY INSTALLATION DETAILS SPECIFIED IN NOTE 5 AND DETERMINE THE FINAL LOCATION OF THE CABLE TRAY SUPPORT.
13. ALL CABLE TRAY HARDWARE SHALL BE 316SS UNLESS SPECIFIED OTHERWISE.
14. HEAVY DUTY EXPANSION SPLICE PLATES SHALL BE INSTALLED EVERY 40 FT. HEAVY DUTY MID-SPAN SPLICE PLATES SHALL BE USED AT ALL LOCATIONS (EXCEPT EXPANSION JOINTS) TO SUPPORT THE MAXIMUM CABLE, SNOW AND ICE LOADS.
15. FIXED HOLD DOWN CLAMPS FOR HORIZONTAL TRAYS SHALL BE INSTALLED AT ALL FITTINGS AND AT MID-POINTS BETWEEN EXPANSION JOINTS IN STRAIGHT RUNS. CABLE TRAYS GUIDE CLAMPS SHALL BE INSTALLED AT OTHER SUPPORT LOCATIONS.
16. FOR VERTICAL CABLE TRAY RUNS THAT ARE LONGER THAN 50FT, EXPANSION JOINT SHALL BE PROVIDED AT EVERY 20FT. SUPPORT OF VERTICAL TRAY DROP NEEDS TO BE SUPPORTED IN AT LEAST TWO LOCATIONS FOR A 20FT SPAN OF CABLE TRAY. REFER TO LP100-EJ-00000409 (ET906) FOR HOLD DOWN CLAMP OF VERTICAL CABLE TRAY.

SHEET KEY NOTES:

1. HEAVY DUTY EXPANSION AND HEAVY DUTY MID SPAN SPLICE PLATE ON STRAIGHT TRAYS SHALL BE INSTALLED AT 1/4 OF THE SUPPORT SPAN (5'-0" FROM THE SUPPORT).
2. GROUNDING CONNECTION FOR STACKED CABLE TRAY BONDING TO BE INSTALLED BY INSTALLATION CONTRACTOR EVERY 40 FEET (MAXIMUM). REFER TO DETAIL EG931A ON DRAWING LP100-EJ-00000105.
3. CABLE TRAY GROUND SHALL BE CONNECTED TO MAIN UNDERGROUND GROUND GRID VIA GROUND LUG PROVIDED ON COLUMN. COLUMN GROUND LUG CONNECTION AND FINAL CONNECTION TO MAIN GROUND GRID SHALL BE COMPLETED BY INSTALLATION CONTRACTOR. REFER TO UNDERGROUND GROUNDING PLAN.
4. SITE CONTRACTOR SHALL SUPPLY AND INSTALL ONE #4/0 AWG BARE STRANDED COPPER GROUND CONDUCTOR ON THE OUTSIDE OF THE SIDERAIL FOR THE ENTIRE LENGTH OF THE CABLE TRAY SHOWN.
5. NOT USED.
6. INSTALLATION CONTRACTOR SHALL SUPPLY AND INSTALL HEAVY DUTY TYPE HOLD DOWN CLAMP / EXPANSION GUIDE WHERE ES0905 IS SHOWN.
7. THE 6" 480Y/277 EMERGENCY POWER TRAY - YE00364E WILL CONTINUE AS PART OF K215 SCOPE WORK UNTIL LP1Y-EJB/00-00-324 LOCATED AT PR-7-27/PR7-A AS DETAILED ON SHEETS LP1Y-EP-00000113 AND LP1Y-EP-00000114.
8. THE 12" COMPARTMENT OF THE 18I00001I CABLE TRAY IS INTENDED FOR FIBER OPTIC, SHIELDED CABLE, AND RTD HEAT TRACE CONTROL CABLE.

REFERENCE DRAWINGS & DOCUMENTS

DOCUMENT NUMBER	DOCUMENT TITLE
LP1Y-EP-00000113	ELECTRICAL CABLE TRAY AND GROUNDING PLAN TANK FARM, EAST - WEST PIPERACK TFS00L101
LP1Y-EP-00000160	ELECTRICAL CABLE TRAY AND GROUNDING PLAN TANK FARM, E-HOUSE 48
LP1Y-EP-0009006	ELECTRICAL UNDERGROUND GROUNDING PLAN - RAIL UNLOADING RACK
LP1Y-EP-00000114	ELECTRICAL CABLE TRAY AND GROUNDING PLAN TANK FARM, EAST - WEST PIPERACK TFS00L102
LP1Y-EP-00U00027	ELECTRICAL UNDERGROUND GROUNDING PLAN TANK FARM, EAST - WEST PIPERACK
LP1Y-EP-00000324	ELECTRICAL ABOVEGROUND GROUNDING PLAN TANK FARM, EAST - WEST PIPERACK
LP1Y-CS-30000001	CIVIL SITE PLAN OVERALL
B1LG-00-K004-00010	OVERALL CIVIL PLANS - PHASE 2
LP1Y-EP-0009B001	ELECTRICAL CABLE TRAY AND GROUNDING PLAN PLATFORM LEVEL - RAIL UNLOADING RACK
LP1Y-SF-0009253	PLATFORM FRAMING PLAN - RAIL UNLOADING RACK
LP1Y-SF-0009254	CABLE TRAY SUPPORT FRAMING PLAN - RAIL UNLOADING RACK
LP1Y-265-EP-00000402	ELECTRICAL TYPICAL POWER DETAILS BUILDING Y TFS/CUB
LP148-265-LST-002	ELECTRICAL CABLE LIST - EHOUSE 48
LP1Y-270-LST-K215-03	INSTRUMENT CABLE SCHEDULE - RAIL UNLOADING RACK
LP1Y-EP-00090001	ELECTRICAL ABOVE GROUND GROUNDING PLAN - GROUND LEVEL - RAIL UNLOADING RACK
LP1Y-EP-00090005	ELECTRICAL ABOVE GROUND GROUNDING PLAN - PLATFORM LEVEL - RAIL UNLOADING RACK

HANSON PROFESSIONAL SERVICES, INC.
www.hanson-inc.com
Offices Nationwide
11931 Wickchester Lane, Suite 370
Houston, TX 77043
(346) 297-1720

REV	DATE	DES	ENG	CHK	APP	PM APP
A	17-APR-2026	ML	AT	BM	RN	SS
B	02-MAR-2026	BM	AJT	RDN	AJT	SS

CABLE TRAY AND GROUNDING PLAN
GROUND LEVEL
RAIL UNLOADING RACK

REV	ZONE	PROJECT NUMBER / DESCRIPTION	CHANGE CONTROL	DATE
B	ALL	ISSUED FOR REVIEW	NA	17-APR-2026
A	ALL	ISSUED FOR REVIEW	NA	02-MAR-2026

REVISIONS

CONFIDENTIAL INFORMATION


THIS DRAWING AND THE IDEAS AND DESIGNS SHOWN THEREON ARE THE EXCLUSIVE PROPERTY OF ELI LILLY AND COMPANY AND ARE NOT TO BE USED, REPRODUCED OR DISCLOSED, EITHER IN WHOLE OR IN PART, WITHOUT THE WRITTEN CONSENT OF ELI LILLY AND COMPANY.

SYSTEM TYPE: NA		EDIFICE/BUILDING: Y	LEVEL/FLOOR: 0
SUB DISCIPLINE	LOCATION CODE: LP1	LOCATION/GRID: COL C-D / 33-43	CCI CODE: YELLOW / PROJECT NAME: LP1-306-1181
CRITICAL QUALITY		ENTERPRISE GROUP: API	DRAWING INTENTION / DRAWING SCALE: As indicated
CRITICAL BUSINESS		EQUIPMENT CLASSIFICATION: NA	ALTERNATE DOCUMENT ID: NA / MERIDIAN REV
CRITICAL HSE		VENDOR: NA	DOCUMENT ID: LP1Y-EP-0009A001
NON-CRITICAL		ENGINEERING AGENCY DOC ID: NA	

IF YOU ARE USING A PRINTED COPY OF THIS DOCUMENT, IT IS AN UNCONTROLLED PRINT. CONFIRM WITH THE OFFICIAL "ELECTRONIC RECORD" DOCUMENT IN THE GLOBAL ENGINEERING CONTENT MANAGEMENT SYSTEM.

IF YOU ARE USING A PRINTED COPY OF THIS DOCUMENT, IT IS AN UNCONTROLLED PRINT. CONFIRM WITH THE OFFICIAL "ELECTRONIC RECORD" DOCUMENT IN THE GLOBAL ENGINEERING CONTENT MANAGEMENT SYSTEM.

4/20/2026 8:49:55 AM Autodesk Docs://2930007 - Hanson-Fluor Lily/LP1/01-TFS-EN-000-000-00-HNS.rvt

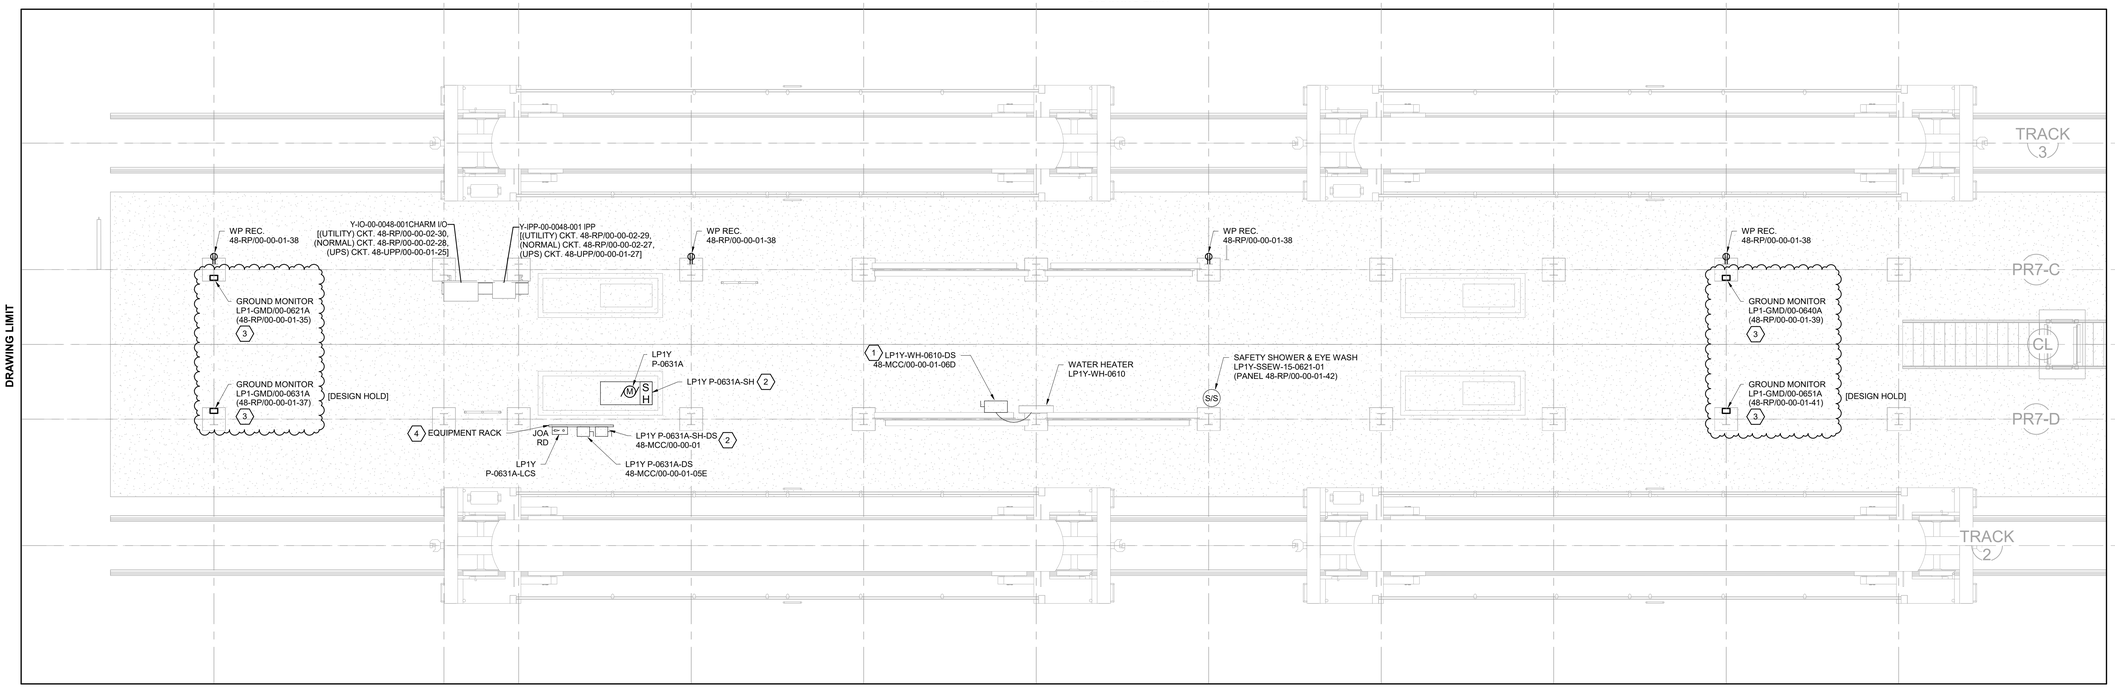

1 POWER PLAN - GROUND LEVEL - ENLARGED


SCALE: 3/16" = 1'-0" 0 4' 8' 12'

GENERAL NOTES:

1. THE ELECTRICAL INSTALLATION SHALL COMPLY WITH THE 2009 EDITION OF THE INDIANA ELECTRICAL CODE AND THE 2023 NATIONAL ELECTRICAL CODE. IF THERE ARE DISCREPANCIES BETWEEN THE 2009 INDIANA ELECTRICAL CODE AND THE 2023 NEC, THE MOST STRINGENT REQUIREMENT SHALL APPLY.
2. TOP ELEVATION OF ELECTRICAL JUNCTION BOXES AND PANELS SHALL BE 6' - 7" FROM FINISHED CONCRETE GROUND LEVEL UNLESS OTHERWISE NOTED.
3. CONTRACTOR SHALL COORDINATE EXACT LOCATION OF ALL DEVICES WITH ALL TRADES PRIOR TO INSTALLATION.
4. ALL POWER LOADS SHOWN ON THIS SHEET ARE FED FROM THE PLATFORM LEVEL POWER TRAYS. CONTRACTOR TO UTILIZE NEC AND FLUOR STANDARD RECOMMENDED CABLE AND CONDUIT ROUTING FROM PLATFORM CABLE TRAY TO POWER LOAD. CONTRACTOR SHALL MEET NFPA 820 AND NEC FOR HAZARDOUS LOCATION FITTINGS, BOXES, ETC.
5. ALL ELECTRICAL AND INSTRUMENTATION DISTRIBUTION EQUIPMENT SHOWN ON THIS SHEET SHALL BE RATED FOR CLASS 1, DIVISION 2, ENVIRONMENTS PER NFPA 70 (NEC) AND NFPA 820. THIS INCLUDES FITTINGS, BOXES AND OTHER CONNECTION POINTS.
6. ELECTRICAL HEAT TRACING (EHT) DESIGN BY THERMON. RTDs, HEAT TRACE POWER CABLES, POWER MARSHALLING JUNCTION BOXES, HEAT TRACE CABLE, CONTROL CABLE, CONTROL COMPONENTS, AND RTDs JUNCTION BOXES ARE PROVIDED AND SHOWN IN THE THERMON DESIGN PACKAGE. CONTRACTOR TO PROVIDE CABLE TRAY SPACE AND OTHER RACEWAY INFRASTRUCTURE AS REQUIRED BY THERMON. CONTRACTOR TO COORDINATE WITH THERMON. — HOLD
7. MOUNTING HEIGHT OF RECEPTACLE DEVICES SHALL BE BASED ON STANDARD INSTALLATION DETAILS UNLESS OTHERWISE INDICATED IN THE DRAWING.

SHEET KEY NOTE:

1. NEC CODE COMPLIANT LOCAL FUSED DISCONNECT SWITCH TO BE SUPPLIED WITH PACKAGED WATER HEATER PANEL.
2. MOTOR SPACE HEATER WILL BE CONNECTED TO POWER SOURCE 48-RP/00-00-01 VIA 48-MCC/00-00-01. REFER TO ONE LINE DIAGRAM ON SHEET LP148-EK-00000603.
3. GROUND MONITORING SYSTEM FOR LOADING ARM. [DESIGN HOLD]
4. PROVIDE STAINLESS STEEL UNISTRUT EQUIPMENT RACK FOR THE UNLOADING PUMP DISCONNECT SWITCH, MOTOR SPACE HEATER SWITCH, AND JOA. PROVIDE (2) 4-BOLT POST BASE (6" X 6" X 1/4" THICK) FOR THE POST WITH CONCRETE ANCHOR BOLTS.

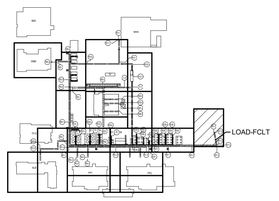

SITE - KEYPLAN

REFERENCE DRAWINGS & DOCUMENTS

DOCUMENT NUMBER	DOCUMENT TITLE
LP100-EJ-00000300 SERIES DRAWINGS	ELECTRICAL STANDARD MOTOR INSTALLATION DETAILS
LP100-EJ-00000411	ELECTRICAL SUPPORT INSTALLATION DETAILS BUILDING 00 SITE/GENERAL
LP1Y-265-STD-401	ELECTRICAL POWER DETAILS BUILDING Y TFS/CUB
LP1Y-265-STD-402	ELECTRICAL POWER DETAILS BUILDING Y TFS/CUB
LP100-EJ-00000001 THRU LP100-EJ-00000003	GENERAL NOTES, LEGENDS, AND SYMBOLS
LP148-EK00000101	ELECTRICAL PANELBOARD SCHEDULES BLDG 48 NORMAL LIGHTING AND SMALL POWER, 48-LP/00-00-01 48-LP/00-00-02, 48-RP/00-00-01, 48-RP/00-00-02, 48-RP/00-00-03
LP148-EK00000102	ELECTRICAL PANELBOARD SCHEDULES BUILDING 48, UPS PANEL 48-UDP/00-00-01, 48-UPP/00-00-01, 48-UPP/00-00-02
LP148-265-LST-002	ELECTRICAL CABLE LIST - EHOUSE 48
LP1Y-EK-00080000 & LP1Y-EK-00080001	ELECTRICAL HAZARDOUS AREA CLASSIFICATION
LP148-EK-00000603 & LP148-EK-00000604	ELECTRICAL SINGLE LINE DIAGRAM BUILDING 40 LP148-MCC/00-00-01
LP1Y-EP-00000014	ELECTRICAL POWER PLAN - TANK FARM, EAST - WEST PIPERACK
LP1Y-EP-0009B005	ELECTRICAL POWER PLAN - PLATFORM LEVEL (RAIL UNLOADING RACK)
LP1Y-EP-00090001	ELECTRICAL ABOVE GROUND GROUNDING PLAN - GROUND LEVEL - RAIL UNLOADING RACK

HANSON PROFESSIONAL SERVICES, INC.
www.hanson-inc.com
Offices Nationwide
11931 Wickchester Lane, Suite 370
Houston, TX 77043
(346) 297-1720

REV	DATE	DES	ENG	CHK	APP	PM APP
2	02-MAR-2026	MGL	AJT	RN	AJT	SS
1	17-APR-2026	ML	AT	BM	RN	SS

Lilly

ELECTRICAL POWER PLAN - GROUND LEVEL

RAIL UNLOADING RACK

REV	ZONE	PROJECT NUMBER / DESCRIPTION	CHANGE CONTROL	DATE
1	ALL	ISSUED FOR REVIEW	NA	17-APR-2026
2	ALL	ISSUED FOR REVIEW	NA	02-MAR-2026

REVISIONS

CONFIDENTIAL INFORMATION


THIS DRAWING AND THE IDEAS AND DESIGNS SHOWN THEREON ARE THE EXCLUSIVE PROPERTY OF ELI LILLY AND COMPANY AND ARE NOT TO BE USED, REPRODUCED OR DISCLOSED, EITHER IN WHOLE OR IN PART, WITHOUT THE WRITTEN CONSENT OF ELI LILLY AND COMPANY.

SYSTEM TYPE: NA		EDIFICE/BUILDING: Y	LEVEL/FLOOR: 0
SUB DISCIPLINE	LOCATION CODE: LP1	LOCATION/GRID: COL C-D / 33-43	CCI CODE: YELLOW
			PROJECT NAME: LP1-306-1181
CRITICAL QUALITY		ENTERPRISE GROUP: API	DRAWING INTENTION
			DRAWING SCALE: As indicated
CRITICAL BUSINESS		EQUIPMENT CLASSIFICATION: NA	ALTERNATE DOCUMENT ID
			MERIDIAN REV: 0B
CRITICAL HSE		VENDOR: NA	DOCUMENT ID
NON-CRITICAL		ENGINEERING AGENCY DOC ID: NA	LP1Y-EP-0009A005

4/20/2026 11:32:29 AM Autodesk Docs://250007 - Hanson-Fluor Lilly\LP1\Y-TFS-EG-000-00-HNS.rvt


IF YOU ARE USING A PRINTED COPY OF THIS DOCUMENT, IT IS AN UNCONTROLLED PRINT. CONFIRM WITH THE OFFICIAL "ELECTRONIC RECORD" DOCUMENT IN THE GLOBAL ENGINEERING CONTENT MANAGEMENT SYSTEM.

IF YOU ARE USING A PRINTED COPY OF THIS DOCUMENT, IT IS AN UNCONTROLLED PRINT. CONFIRM WITH THE OFFICIAL "ELECTRONIC RECORD" DOCUMENT IN THE GLOBAL ENGINEERING CONTENT MANAGEMENT SYSTEM.

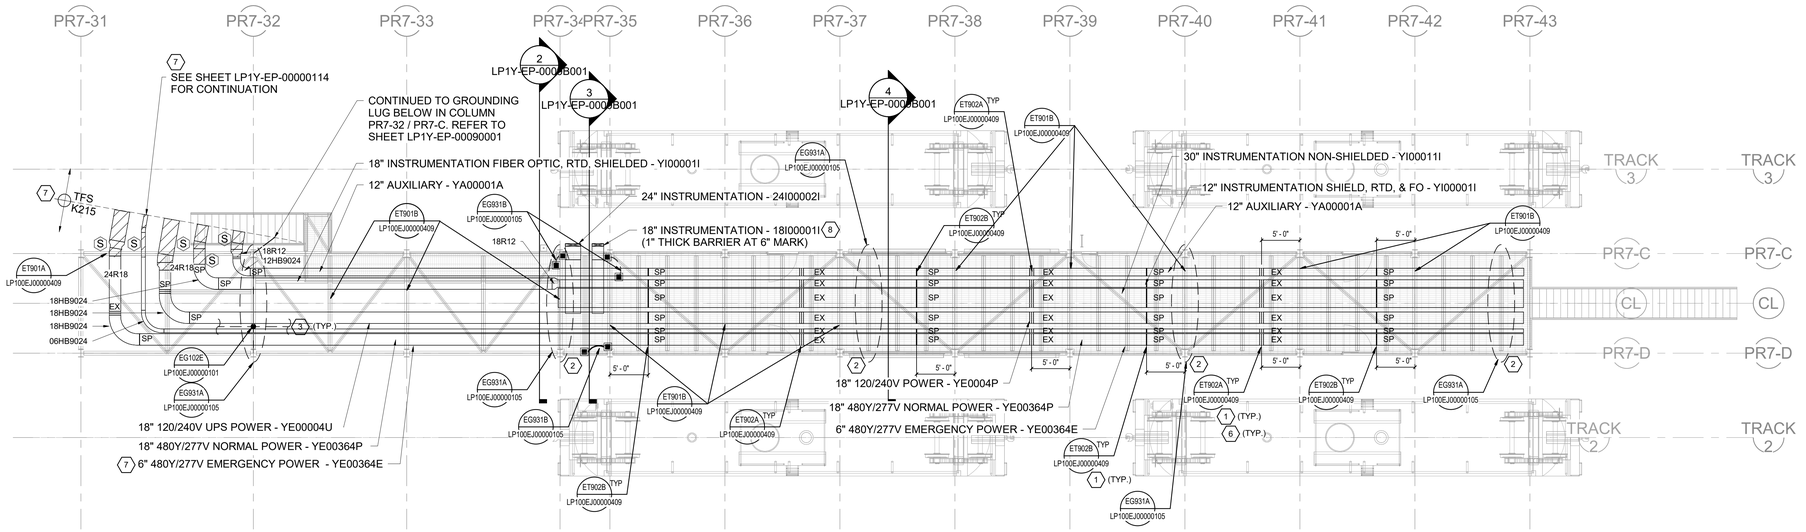


1 CABLE TRAY PLAN - OPERATING PLATFORM

SCALE: 1/8" = 1'-0"

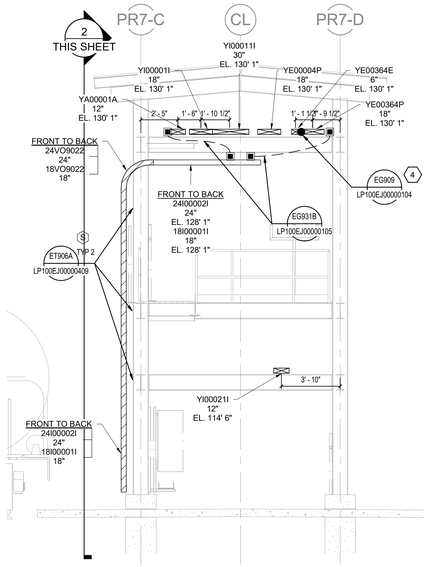


2 SECTION

SCALE: 1/4" = 1'-0"

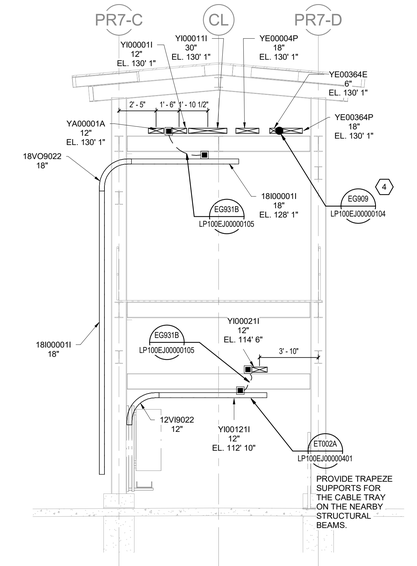

3 SECTION

SCALE: 1/4" = 1'-0"

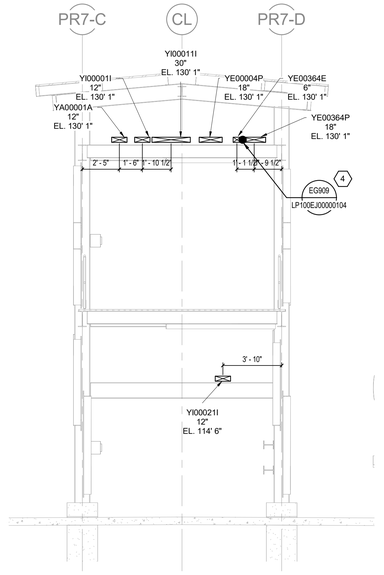

4 SECTION

SCALE: 1/4" = 1'-0"

LEGEND & SYMBOLS:

- (S) OR ▨ SHIP LOOSE
- SCOPE SPLIT
- EX EXPANSION JOINT

GENERAL NOTES:


1. ALL DIMENSIONS AND ELEVATIONS ARE IN FEET AND INCHES UNLESS NOTED OTHERWISE.
2. REFER TO CIVIL DRAWING B1LG-00-K004-00010 AND RAIL UNLOADING RACK STRUCTURAL DRAWINGS FOR FINISHED GRADE ELEVATION. ELEVATIONS SHOWN ARE PLANT COORDINATES. GEODETIC ELEVATION 926'-9 3/5" IS EQUAL TO PLANT COORDINATE ELEVATION 100'-0".
3. THE ELECTRICAL INSTALLATION SHALL COMPLY WITH THE 2009 EDITION OF THE INDIANA ELECTRICAL CODE AND THE 2023 NATIONAL ELECTRICAL CODE. IF THERE ARE DISCREPANCIES BETWEEN THE 2009 INDIANA ELECTRICAL CODE AND 2023 NEC, THE MOST STRINGENT REQUIREMENT SHALL APPLY.
4. REFER TO DRAWING LP100-EJ-00000001 FOR GENERAL NOTES AND DRAWINGS LP100-EJ-00000002 AND LP100-EJ-00000103 FOR LEGEND AND SYMBOLS.
5. REFER TO DRAWINGS LP100-EJ-00000400 SERIES FOR STANDARD CABLE TRAY INSTALLATION DETAILS.
6. REFER TO DRAWING LP100-EJ-00000100 SERIES FOR STANDARD GROUNDING INSTALLATION DETAILS.
7. REFER TO LP100-EJ-00000409 (ET903) FOR MODULE CABLE TRAY INSTALLATION GUIDE.
8. MODULE CONTRACTOR SHALL ENSURE ALL MATERIALS ATTACHED TO THE MODULE WILL NOT EXCEED THE SHIPPING VOLUME OF THE MODULE.
9. REFER TO LP100-265-EMS-16110 FOR CABLE TRAY SPECIFICATION AND CABLE TRAY COVER INSTALLATION REQUIREMENTS. TRAY COVERS, WHERE REQUIRED, SHALL BE INSTALLED AFTER ALL CABLES ARE PULLED AND SECURED.
10. CABLE TRAY SHALL BE 6" DEEP, 20FT SPANS, HEAVY-DUTY ALUMINIUM, LADDER TYPE WITH 9" RUNG SPACING, NEMA CLASS 20C+ UNLESS SPECIFIED OTHERWISE. CABLE TRAY DESIGN BASIS IS B-LINE H46A HEAVY DUTY CABLE TRAY OR APPROVED EQUAL. ANY DEVIATIONS MAY REQUIRE CHANGES IN SUPPORTS, DESIGN, DETAILS, LOAD CAPACITIES, ETC. ANY CHANGES THAT RESULT IN CHANGES INCLUDING COSTS AND SCHEDULE SHALL BE BORNE BY THE CONTRACTOR.
11. INSTALLATION DETAILS SHOW TYPICAL CABLE TRAY FITTING TYPES TO BE USED. CONTRACTOR SHALL USE HEAVY-DUTY FITTINGS FOR ALL INSTALLATIONS INDICATED ON PLAN DRAWINGS.
12. CONTRACTOR SHALL USE THE INSTALLATION DETAILS AS SHOWN ON THIS PLAN DRAWING. WHERE INSTALLATION DETAILS ARE NOT SHOWN, CONTRACTOR SHALL VERIFY AND USE APPROPRIATE INSTALLATION DETAILS FROM TRAY INSTALLATION DETAILS SPECIFIED IN NOTE 5 AND DETERMINE THE FINAL LOCATION OF THE CABLE TRAY SUPPORT.
13. ALL CABLE TRAY HARDWARE SHALL BE 316SS UNLESS SPECIFIED OTHERWISE.
14. HEAVY DUTY EXPANSION SPLICE PLATES SHALL BE INSTALLED EVERY 40 FT. HEAVY DUTY MID-SPAN SPLICE PLATES SHALL BE USED AT ALL LOCATIONS (EXCEPT EXPANSION JOINTS) TO SUPPORT THE MAXIMUM CABLE, SNOW AND ICE LOADS.
15. FIXED HOLD DOWN CLAMPS FOR HORIZONTAL TRAYS SHALL BE INSTALLED AT ALL FITTINGS AND AT MID-POINTS BETWEEN EXPANSION JOINTS IN STRAIGHT RUNS. CABLE TRAYS GUIDE CLAMPS SHALL BE INSTALLED AT OTHER SUPPORT LOCATIONS.
16. FOR VERTICAL CABLE TRAY RUNS THAT ARE LONGER THAN 50FT, EXPANSION JOINT SHALL BE PROVIDED AT EVERY 20FT. SUPPORT OF VERTICAL TRAY DROP NEEDS TO BE SUPPORTED IN AT LEAST TWO LOCATIONS FOR A 20FT SPAN OF CABLE TRAY. REFER TO LP100-EJ-00000409 (ET906) FOR HOLD DOWN CLAMP OF VERTICAL CABLE TRAY.

SHEET KEY NOTES:

1. HEAVY DUTY EXPANSION AND HEAVY DUTY MID SPAN SPLICE PLATE ON STRAIGHT TRAYS SHALL BE INSTALLED AT 1/4 OF THE SUPPORT SPAN (5'-0" FROM THE SUPPORT).
2. GROUNDING CONNECTION FOR STACKED CABLE TRAY BONDING TO BE INSTALLED BY INSTALLATION CONTRACTOR EVERY 40 FEET (MAXIMUM). REFER TO DETAIL EG931A ON DRAWING LP100-EJ-00000105.
3. CABLE TRAY GROUND SHALL BE CONNECTED TO MAIN UNDERGROUND GROUND GRID VIA GROUND LUG PROVIDED ON COLUMN. COLUMN GROUND LUG CONNECTION AND FINAL CONNECTION TO MAIN GROUND GRID SHALL BE COMPLETED BY INSTALLATION CONTRACTOR. REFER TO UNDERGROUND GROUNDING PLAN.
4. SITE CONTRACTOR SHALL SUPPLY AND INSTALL ONE #4/0 AWG BARE STRANDED COPPER GROUND CONDUCTOR ON THE OUTSIDE OF THE SIDERAIL FOR THE ENTIRE LENGTH OF THE CABLE TRAY SHOWN.
5. NOT USED.
6. INSTALLATION CONTRACTOR SHALL SUPPLY AND INSTALL HEAVY DUTY TYPE HOLD DOWN CLAMP / EXPANSION GUIDE WHERE ES0905 IS SHOWN.
7. THE 6" 480Y/277 EMERGENCY POWER TRAY - YE00364E WILL CONTINUE AS PART OF K215 SCOPE WORK UNTIL LP1Y-EJB/00-00-324 LOCATED AT PR-7-27/PR7-A AS DETAILED ON SHEETS LP1Y-EP-00000113 AND LP1Y-EP-00000114.
8. THE 12" COMPARTMENT OF THE 18I00001I CABLE TRAY IS INTENDED FOR FIBER OPTIC, SHIELDED CABLE, AND RTD HEAT TRACE CONTROL CABLE.

REFERENCE DRAWINGS & DOCUMENTS

DOCUMENT NUMBER	DOCUMENT TITLE
LP1Y-EP-00000113	ELECTRICAL CABLE TRAY AND GROUNDING PLAN TANK FARM, EAST - WEST PIPERACK TFS00L101
LP1Y-EP-00000160	ELECTRICAL CABLE TRAY AND GROUNDING PLAN TANK FARM, E-HOUSE 48
LP1Y-EP-00090006	ELECTRICAL UNDERGROUND GROUNDING PLAN - RAIL UNLOADING RACK
LP1Y-EP-00000114	ELECTRICAL CABLE TRAY AND GROUNDING PLAN TANK FARM, EAST - WEST PIPERACK TFS00L102
LP1Y-EP-00U00027	ELECTRICAL UNDERGROUND GROUNDING PLAN TANK FARM, EAST - WEST PIPERACK
LP1Y-EP-00000324	ELECTRICAL ABOVEGROUND GROUNDING PLAN TANK FARM, EAST - WEST PIPERACK
LP1Y-CS-00000001	CIVIL SITE PLAN OVERALL
B1LG-00-K004-00010	OVERALL CIVIL PLANS - PHASE 2
LP1Y-EP-0009A001	ELECTRICAL CABLE TRAY AND GROUNDING PLAN GROUND LEVEL - RAIL UNLOADING RACK
LP1Y-SF-0009253	PLATFORM FRAMING PLAN - RAIL UNLOADING RACK
LP1Y-SF-0009254	CABLE TRAY SUPPORT FRAMING PLAN - RAIL UNLOADING RACK
LP1Y-265-EP-00000402	ELECTRICAL TYPICAL POWER DETAILS BUILDING Y TFS/CUB
LP148-265-LST-002	ELECTRICAL CABLE LIST - EHOUSE 48
LP1Y-270-LST-K215-03	INSTRUMENT CABLE SCHEDULE - RAIL UNLOADING RACK
LP1Y-EP-00090001	ELECTRICAL ABOVE GROUND GROUNDING PLAN - GROUND LEVEL - RAIL UNLOADING RACK
LP1Y-EP-00090005	ELECTRICAL ABOVE GROUND GROUNDING PLAN - PLATFORM LEVEL - RAIL UNLOADING RACK

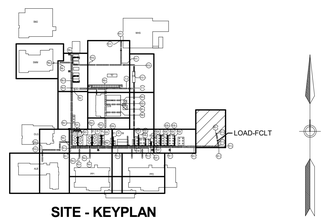

SITE - KEYPLAN

HANSON PROFESSIONAL SERVICES, INC.
www.hanson-inc.com
Offices Nationwide
11931 Wickchester Lane, Suite 370
Houston, TX 77043
(346) 297-1720

REV	DATE	DES	ENG	CHK	APP	PM APP
B	17-APR-2026	ML	AT	BM	RN	SS
A	02-MAR-2026	BM	AJT	RDN	AJT	SS

CABLE TRAY AND GROUNDING PLAN
PLATFORM LEVEL
RAIL UNLOADING RACK

REV	ZONE	PROJECT NUMBER / DESCRIPTION	CHANGE CONTROL	DATE
B	ALL	ISSUED FOR REVIEW	NA	17-APR-2026
A	ALL	ISSUED FOR REVIEW	NA	02-MAR-2026

REVISIONS

CONFIDENTIAL INFORMATION


THIS DRAWING AND THE IDEAS AND DESIGNS SHOWN THEREON ARE THE EXCLUSIVE PROPERTY OF ELI LILLY AND COMPANY AND ARE NOT TO BE USED, REPRODUCED OR DISCLOSED, EITHER IN WHOLE OR IN PART, WITHOUT THE WRITTEN CONSENT OF ELI LILLY AND COMPANY.

SYSTEM TYPE: NA		EDIFICE/BUILDING: Y	LEVEL/FLOOR: 1
SUB DISCIPLINE:	LOCATION CODE: LP1	LOCATION/GRID: COL C-D / 33-43	CCI CODE: YELLOW
			PROJECT NAME: LP1-306-1181
CRITICAL QUALITY	ENTERPRISE GROUP: API	DRAWING INTENTION	DRAWING SCALE: As indicated
CRITICAL BUSINESS	EQUIPMENT CLASSIFICATION: NA	ALTERNATE DOCUMENT ID: NA	MERIDIAN REV
CRITICAL HSE	VENDOR: NA	DOCUMENT ID: LP1Y-EP-0009B001	
NON-CRITICAL	ENGINEERING AGENCY DOC ID: NA		

IF YOU ARE USING A PRINTED COPY OF THIS DOCUMENT, IT IS AN UNCONTROLLED PRINT. CONFIRM WITH THE OFFICIAL "ELECTRONIC RECORD" DOCUMENT IN THE GLOBAL ENGINEERING CONTENT MANAGEMENT SYSTEM.

IF YOU ARE USING A PRINTED COPY OF THIS DOCUMENT, IT IS AN UNCONTROLLED PRINT. CONFIRM WITH THE OFFICIAL "ELECTRONIC RECORD" DOCUMENT IN THE GLOBAL ENGINEERING CONTENT MANAGEMENT SYSTEM.

4/20/2026 8:49:37 AM Autodesk Docs://2930007 - Hanson-Fluor Lily/LP1Y-TFS-EN-000-00-00-HNS.rvt

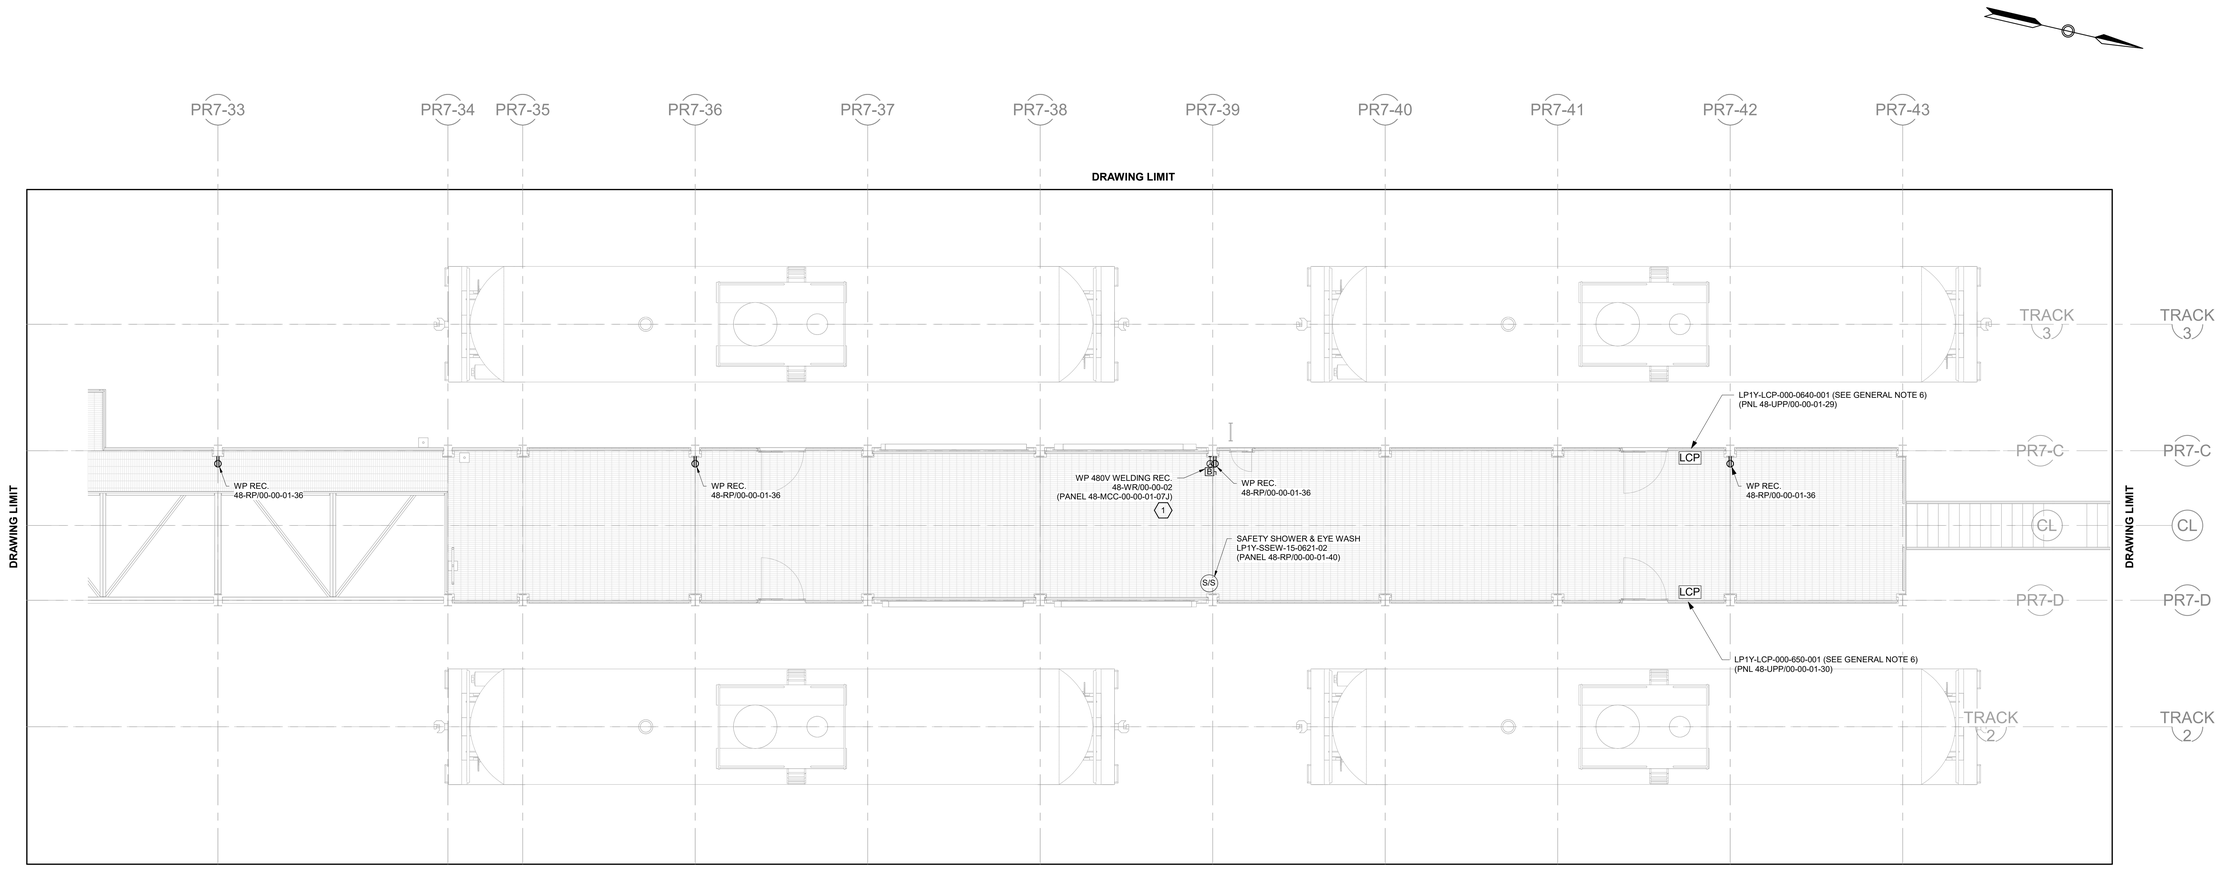

1 POWER PLAN - OPERATING PLATFORM - ENLARGED


SCALE: 3/16" = 1'-0"
0 4' 8' 12'

GENERAL NOTES:

1. THE ELECTRICAL INSTALLATION SHALL COMPLY WITH THE 2009 EDITION OF THE INDIANA ELECTRICAL CODE AND THE 2023 NATIONAL ELECTRICAL CODE. IF THERE ARE DISCREPANCIES BETWEEN THE 2009 INDIANA ELECTRICAL CODE AND THE 2023 NEC, THE MOST STRINGENT REQUIREMENT SHALL APPLY.
2. TOP ELEVATION OF ELECTRICAL JUNCTION BOXES AND PANELS SHALL BE 6' - 7" FROM PLATFORM LEVEL UNLESS OTHERWISE NOTED.
3. CONTRACTOR SHALL COORDINATE EXACT LOCATION OF ALL DEVICES WITH ALL TRADES PRIOR TO INSTALLATION.
4. ALL POWER LOADS SHOWN ON THIS SHEET ARE FED FROM THE PLATFORM LEVEL POWER TRAYS. CONTRACTOR TO UTILIZE NEC AND FLUOR STANDARD RECOMMENDED CABLE AND CONDUIT ROUTING FROM PLATFORM CABLE TRAY TO POWER LOAD.
5. ALL ELECTRICAL AND INSTRUMENTATION DISTRIBUTION EQUIPMENT SHOWN ON THIS SHEET SHALL BE RATED FOR CLASS 1, DIVISION 2 ENVIRONMENTS PER NFPA 70 (NEC) AND NFPA 820. THIS INCLUDES FITTINGS, BOXES, AND OTHER CONNECTION POINTS.
6. LP1Y-LCP-000-0640-001 AND LP1Y-LCP-000-0650-001 PORTABLE PROBE CONTROLLERS TO BE WIRED PER THE INSTRUMENTATION WIRING DIAGRAM SHEET LP1Y-DIA-K215-17.
7. MOUNTING HEIGHT OF RECEPTACLE DEVICES SHALL BE BASED ON STANDARD INSTALLATION DETAILS UNLESS OTHERWISE INDICTAED IN THE DRAWING.

SHEET KEY NOTE:

1. WELDING RECEPTACLE TO BE LOCATED IN AN UNCLASSIFIED AREA WITHIN THE RAIL CAR AREA. HOLD 1.

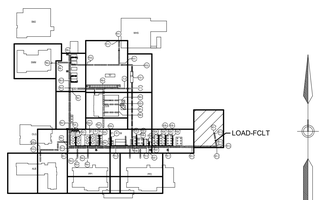

SITE - KEYPLAN

REFERENCE DRAWINGS & DOCUMENTS

DOCUMENT NUMBER	DOCUMENT TITLE
LP100-EJ-00000300 SERIES DRAWINGS	ELECTRICAL STANDARD MOTOR INSTALLATION DETAILS
LP100-EJ-00000411	ELECTRICAL SUPPORT INSTALLATION DETAILS BUILDING 00 SITE/GENERAL
LP1Y-265-STD-401	ELECTRICAL POWER DETAILS BUILDING Y TFS/CUB
LP1Y-265-STD-402	ELECTRICAL POWER DETAILS BUILDING Y TFS/CUB
LP100-EJ-00000001 THRU LP100-EJ-00000003	GENERAL NOTES, LEGENDS, AND SYMBOLS
LP148-EK00000101	ELECTRICAL PANELBOARD SCHEDULES BLDG 48 NORMAL LIGHTING AND SMALL POWER, 48-LP/00-00-01 48-LP/00-00-02, 48-RP/00-00-01, 48-RP/00-00-02, 48-RP/00-00-03
LP148-EK00000102	ELECTRICAL PANELBOARD SCHEDULES BUILDING 48, UPS PANEL 48-UDP/00-00-01, 48-UPP/00-00-01, 48-UPP/00-00-02
LP148-265-LST-002	ELECTRICAL CABLE LIST - EHOUSE 48
LP1Y-EK-00080000 & LP1Y-EK-00080001	ELECTRICAL HAZARDOUS AREA CLASSIFICATION
LP148-EK-00000603 & LP148-EK-00000604	ELECTRICAL SINGLE LINE DIAGRAM BUILDING 40 LP148-MCC/00-00-01
LP1Y-EP-00000014	ELECTRICAL POWER PLAN - TANK FARM, EAST - WEST PIPERACK
LP1Y-EP-0009A005	ELECTRICAL POWER PLAN - GROUND LEVEL (RAIL UNLOADING RACK)
LP1Y-EP-00090005	ELECTRICAL ABOVE GROUND GROUNDING PLAN - PLATFORM LEVEL - RAIL UNLOADING RACK

HANSON™
HANSON PROFESSIONAL SERVICES, INC.
www.hanson-inc.com
Offices Nationwide
11931 Wickchester Lane, Suite 370
Houston, TX 77043
(346) 297-1720

REV	DATE	DES	ENG	CHK	APP	PM APP
1	17-APR-2026	ML	AT	BM	RN	SS
0	02-MAR-2026	MGL	AJT	RN	AJT	SS

Lilly

ELECTRICAL POWER PLAN - PLATFORM LEVEL

RAIL UNLOADING RACK

REV	ZONE	PROJECT NUMBER / DESCRIPTION	CHANGE CONTROL	DATE
0	ALL	ISSUED FOR REVIEW	NA	17-APR-2026
0	ALL	ISSUED FOR REVIEW	NA	02-MAR-2026

REVISIONS

CONFIDENTIAL INFORMATION


THIS DRAWING AND THE IDEAS AND DESIGNS SHOWN THEREON ARE THE EXCLUSIVE PROPERTY OF ELI LILLY AND COMPANY AND ARE NOT TO BE USED, REPRODUCED OR DISCLOSED, EITHER IN WHOLE OR IN PART, WITHOUT THE WRITTEN CONSENT OF ELI LILLY AND COMPANY.

SYSTEM TYPE: NA		EDIFICE/BUILDING: Y	LEVEL/FLOOR: 0
SUB DISCIPLINE:	LOCATION CODE: LP1	LOCATION/GRID: COL C-D / 33-43	CCI CODE: YELLOW	PROJECT NAME: LP1-306-1181
CRITICAL QUALITY		ENTERPRISE GROUP: API	DRAWING INTENTION	DRAWING SCALE: As indicated
CRITICAL BUSINESS		EQUIPMENT CLASSIFICATION: NA	ALTERNATE DOCUMENT ID: NA	MERIDIAN REV
CRITICAL HSE		VENDOR: NA	DOCUMENT ID	
NON-CRITICAL		ENGINEERING AGENCY DOC ID: NA	LP1Y-EP-0009B005	

4/20/2026 8:49:31 AM Autodesk Docs://280007 - Hanson-Fluor Lilly/LP1Y-TFS-EG-000-00-HNS.rvt


IF YOU ARE USING A PRINTED COPY OF THIS DOCUMENT, IT IS AN UNCONTROLLED PRINT. CONFIRM WITH THE OFFICIAL "ELECTRONIC RECORD" DOCUMENT IN THE GLOBAL ENGINEERING CONTENT MANAGEMENT SYSTEM.

IF YOU ARE USING A PRINTED COPY OF THIS DOCUMENT, IT IS AN UNCONTROLLED PRINT. CONFIRM WITH THE OFFICIAL "ELECTRONIC RECORD" DOCUMENT IN THE GLOBAL ENGINEERING CONTENT MANAGEMENT SYSTEM.

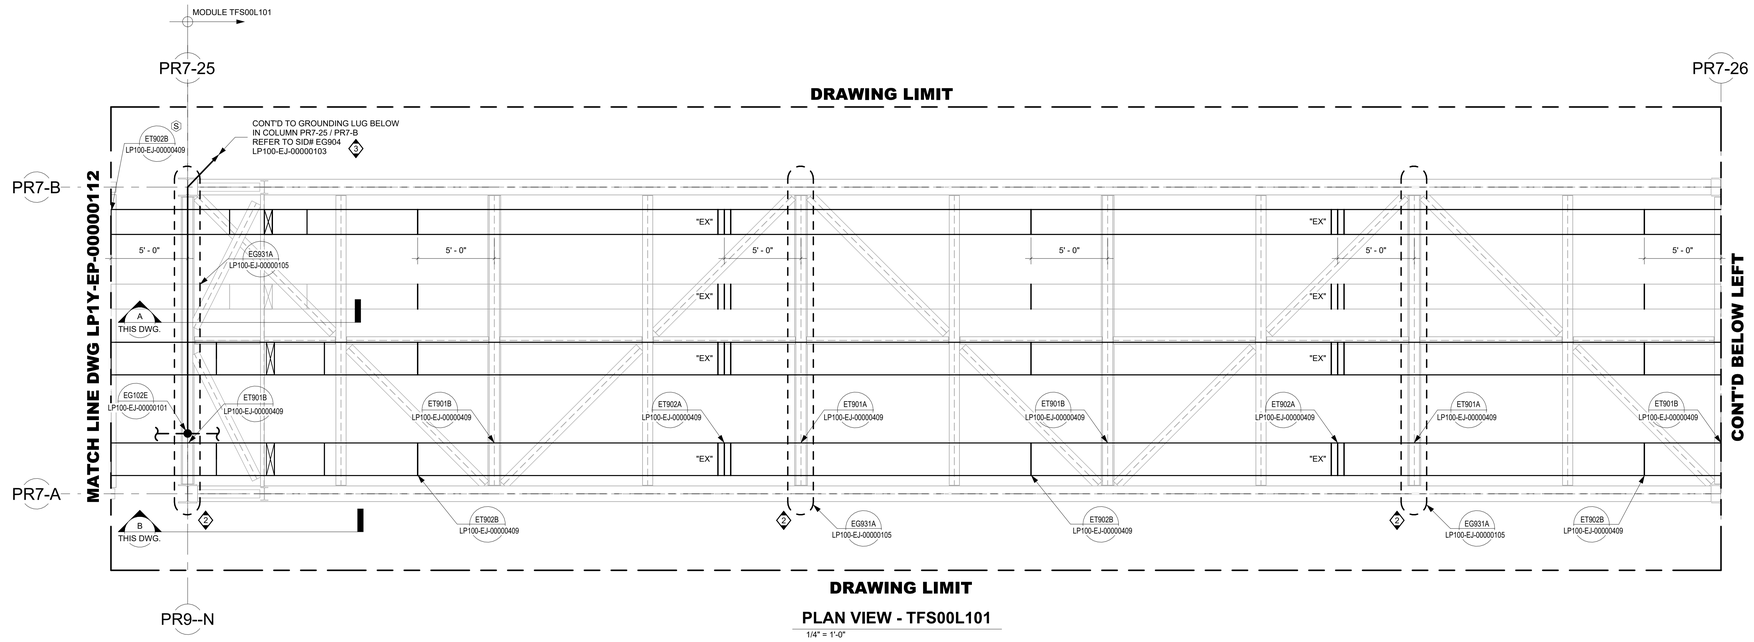

PLAN VIEW - TFS00L101

1/4" = 1'-0"

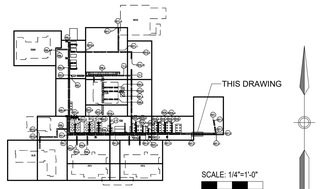

SITE - KEYPLAN

GENERAL NOTES:

1. ALL DIMENSIONS AND ELEVATIONS ARE IN FEET AND INCHES UNLESS NOTED OTHERWISE.
2. REFER TO CIVIL DRAWING B1LG-00-K004-00010 FOR FINISHED GRADE ELEVATION. ELEVATIONS SHOWN ARE PLANT COORDINATES. GEODETIC ELEVATION 926'-9 3/5" IS EQUAL TO PLANT COORDINATE ELEVATION 100'-0".
3. THE ELECTRICAL INSTALLATION SHALL COMPLY WITH THE 2009 EDITION OF THE INDIANA ELECTRICAL CODE AND THE 2023 NATIONAL ELECTRICAL CODE. IF THERE ARE DISCREPANCIES BETWEEN THE 2009 INDIANA ELECTRICAL CODE AND 2023 NEC, THE MOST STRINGENT REQUIREMENT SHALL APPLY.
4. REFER TO DRAWING LP100-EJ-00000001 FOR GENERAL NOTES AND DRAWINGS LP100-EJ-00000002 AND LP100-EJ-00000103 FOR LEGEND AND SYMBOLS.
5. REFER TO DRAWINGS LP100-EJ-00000400 SERIES FOR STANDARD CABLE TRAY INSTALLATION DETAILS.
6. REFER TO DRAWING LP100-EJ-00000100 SERIES FOR STANDARD GROUNDING INSTALLATION DETAILS.
7. REFER TO LP100-EJ-00000409 (ET903) FOR MODULE CABLE TRAY INSTALLATION GUIDE.
8. MODULE CONTRACTOR SHALL ENSURE ALL MATERIALS ATTACHED TO THE MODULE WILL NOT EXCEED THE SHIPPING VOLUME OF THE MODULE.
9. REFER TO LP100-265-EMS-16110 FOR CABLE TRAY SPECIFICATION AND CABLE TRAY COVER INSTALLATION REQUIREMENTS. TRAY COVERS, WHERE REQUIRED, SHALL BE INSTALLED AFTER ALL CABLES ARE PULLED AND SECURED.
10. CABLE TRAY SHALL BE 6" DEEP, 20FT SPANS, HEAVY-DUTY ALUMINIUM, LADDER TYPE WITH 9" RUNG SPACING, NEMA CLASS 20C+ UNLESS SPECIFIED OTHERWISE. CABLE TRAY DESIGN BASIS IS B-LINE H46A HEAVY DUTY CABLE TRAY OR APPROVED EQUAL. ANY DEVIATIONS MAY REQUIRE CHANGES IN SUPPORTS, DESIGN, DETAILS, LOAD CAPACITIES, ETC. ANY CHANGES THAT RESULT IN CHANGES INCLUDING COSTS AND SCHEDULE SHALL BE BORNE BY THE CONTRACTOR.
11. INSTALLATION DETAILS SHOW TYPICAL CABLE TRAY FITTING TYPES TO BE USED. CONTRACTOR SHALL USE HEAVY-DUTY FITTINGS FOR ALL INSTALLATIONS INDICATED ON PLAN DRAWINGS.
12. CONTRACTOR SHALL USE THE INSTALLATION DETAILS AS SHOWN ON THIS PLAN DRAWING. WHERE INSTALLATION DETAILS ARE NOT SHOWN, CONTRACTOR SHALL VERIFY AND USE APPROPRIATE INSTALLATION DETAILS FROM TRAY INSTALLATION DETAILS SPECIFIED IN NOTE 5 AND DETERMINE THE FINAL LOCATION OF THE CABLE TRAY SUPPORT.
13. ALL CABLE TRAY HARDWARE SHALL BE 316SS UNLESS SPECIFIED OTHERWISE.
14. HEAVY DUTY EXPANSION SPLICE PLATES SHALL BE INSTALLED EVERY 40 FT. HEAVY DUTY MID-SPAN SPLICE PLATES SHALL BE USED AT ALL LOCATIONS (EXCEPT EXPANSION JOINTS) TO SUPPORT THE MAXIMUM CABLE, SNOW AND ICE LOADS.
15. FIXED HOLD DOWN CLAMPS FOR HORIZONTAL TRAYS SHALL BE INSTALLED AT ALL FITTINGS AND AT MID-POINTS BETWEEN EXPANSION JOINTS IN STRAIGHT RUNS. CABLE TRAYS GUIDE CLAMPS SHALL BE INSTALLED AT OTHER SUPPORT LOCATIONS.
16. FOR VERTICAL CABLE TRAY RUNS THAT ARE LONGER THAN 50FT, EXPANSION JOINT SHALL BE PROVIDED AT EVERY 20FT. SUPPORT OF VERTICAL TRAY DROP NEEDS TO BE SUPPORTED IN AT LEAST TWO LOCATIONS FOR A 20FT SPAN OF CABLE TRAY. REFER TO LP100-EJ-00000409 (ET906) FOR HOLD DOWN CLAMP OF VERTICAL CABLE TRAY.

LEGEND:

- Ⓢ OR ▨ SHIP LOOSE
- SCOPE SPLIT
- EX EXPANSION JOINT

SHEET NOTES:

1. HEAVY DUTY EXPANSION AND HEAVY DUTY MID SPAN SPLICE PLATE ON STRAIGHT TRAYS SHALL BE INSTALLED AT 1/4 OF THE SUPPORT SPAN (5'-0" FROM THE SUPPORT).
2. GROUNDING CONNECTION FOR STACKED CABLE TRAY BONDING TO BE INSTALLED BY INSTALLATION CONTRACTOR EVERY 40 FEET (MAXIMUM). REFER TO DETAIL EG931A ON DRAWING LP100-EJ-00000105.
3. CABLE TRAY MAIN GROUND CABLE SHALL BE CONNECTED TO MAIN UNDERGROUND GROUND GRID VIA GROUND LUG PROVIDED ON COLUMN. COLUMN GROUND LUG CONNECTION AND FINAL CONNECTION TO MAIN GROUND GRID SHALL BE COMPLETED BY INSTALLATION CONTRACTOR. REFER TO UNDERGROUND GROUNDING PLAN.
4. SITE CONTRACTOR SHALL SUPPLY AND INSTALL ONE #4/0 AWG BARE STRANDED COPPER GROUND CONDUCTOR ON THE OUTSIDE OF THE SIDERAIL FOR THE ENTIRE LENGTH OF THE CABLE TRAY SHOWN.
5. DELETED.
6. INSTALLATION CONTRACTOR SHALL SUPPLY AND INSTALL HEAVY DUTY TYPE HOLD DOWN CLAMP/EXPANSION GUIDE WHERE ES0905 IS SHOWN.
7. THE 6" 480Y/277 EMERGENCY POWER TRAY - YE00364E WILL CONTINUE AS PART OF K215 SCOPE WORK UNTIL LP1Y-EJB/00-00-324 LOCATED AT PR-7-27/PR7-A.

REFERENCE DRAWINGS & DOCUMENTS:

DOCUMENT NUMBER	DOCUMENT TITLE
LP1Y-EP-00000112	ELECTRICAL CABLE TRAY AND GROUNDING PLAN TANK FARM, EAST - WEST PIPERACK TFS00A112
LP1Y-EP-00000114	ELECTRICAL CABLE TRAY AND GROUNDING PLAN TANK FARM, EAST - WEST PIPERACK TFS00L102
LP1Y-EP-00U00027	ELECTRICAL UNDERGROUND GROUNDING PLAN TANK FARM, EAST - WEST PIPERACK
LP1Y-EL-00000301	ELECTRICAL DRAWING INDEX TANK FARM, CABLE TRAY, LIGHTING AND POWER
LP1Y-EL-00000302	ELECTRICAL DRAWING INDEX TANK FARM, ABOVEGROUND AND UNDERGROUND GROUNDING
LP1Y-EP-00000324	ELECTRICAL ABOVEGROUND GROUNDING PLAN TANK FARM, EAST - WEST PIPERACK TFS00L101/TFS00L102
LP100-CS-30000001	CIVIL SITE PLAN OVERALL
B1LG-00-K004-00010	OVERALL CIVIL PLANS - PHASE 2
LP1Y-SF-0009A550	STRUCTURAL FRAMING ELEVATION SHT 1 BUILDING Y,SECTOR 9, SUB-SECTOR A TFS00L101
LP1Y-SF-0009A551	STRUCTURAL FRAMING ELEVATION SHT 2 BUILDING Y, SECTOR 9, SUB-SECTOR A TFS00L101
LP1Y-SF-0009P000	STRUCTURAL FOUNDATIONS BUILDING Y,SECTOR 9 TFS00L101,TFS00L102, & CABLE TRAY SUPT STR
LP1Y-EP-0009B001	CABLE TRAY AND GROUNDING PLAN - PLATFORM LEVEL - RAIL UNLOADING RACK
LP1Y-EL-00090001	ELECTRICAL LIGHTING PLAN - RAIL UNLOADING RACK

FLUOR® EFDEE Engineering PC
PROJECT NO. B1LG
NODE: TFS

Lilly

ELECTRICAL CABLE TRAY AND GROUNDING PLAN TANK FARM, EAST - WEST PIPERACK TFS00L101

REV	ZONE	PROJECT NUMBER / DESCRIPTION	CHANGE CONTROL	DATE
1A	ALL	ISSUED FOR REVIEW	NA	17-APR-2026
1	ALL	ISSUED FOR CONSTRUCTION	NA	05-NOV-2025
0	ALL	ISSUED FOR CONSTRUCTION	NA	11-APR-2025
A	ALL	ISSUED FOR SQUAD CHECK (SQCK)	NA	13-MAR-2025

REVISIONS

REV	DATE	DES	ENG	CHK	APP	PM APP
1A	17-APR-2026	ML	AT	BM	RN	SS
1	05-NOV-2025	JB	MS	EA	TL	EM
0	11-APR-2025	MT	MS	JN	TL	EM
A	13-MAR-2025	JA	MS	JN	SB	EM

CONFIDENTIAL INFORMATION
THIS DRAWING AND THE IDEAS AND DESIGNS SHOWN THEREON ARE THE EXCLUSIVE PROPERTY OF ELI LILLY AND COMPANY AND ARE NOT TO BE USED, REPRODUCED OR DISCLOSED, EITHER IN WHOLE OR IN PART, WITHOUT THE WRITTEN CONSENT OF ELI LILLY AND COMPANY.


SYSTEM TYPE: NA		EDIFICE/BUILDING: Y	LEVEL/FLOOR: 0
SUB DISCIPLINE: EP	LOCATION CODE: LP1	LOCATION/GRID	CCI CODE: YELLOW
CRITICAL QUALITY	ENTERPRISE GROUP: API	DRAWING INTENTION	DRAWING SCALE: 1/4" = 1'-0"
CRITICAL BUSINESS	EQUIPMENT CLASSIFICATION: NA	ALTERNATE DOCUMENT ID: NA	MERIDIAN REV: 1A
CRITICAL HSE	VENDOR: NA	DOCUMENT ID: LP1Y-EP-00000113	
NON-CRITICAL	ENGINEERING AGENCY DOC ID: NA		

PROJECT NAME: LP1-306-1181

IF YOU ARE USING A PRINTED COPY OF THIS DOCUMENT, IT IS AN UNCONTROLLED PRINT. CONFIRM WITH THE OFFICIAL "ELECTRONIC RECORD" DOCUMENT IN THE GLOBAL ENGINEERING CONTENT MANAGEMENT SYSTEM.


IF YOU ARE USING A PRINTED COPY OF THIS DOCUMENT, IT IS AN UNCONTROLLED PRINT. CONFIRM WITH THE OFFICIAL "ELECTRONIC RECORD" DOCUMENT IN THE GLOBAL ENGINEERING CONTENT MANAGEMENT SYSTEM.


Autodesk Docs://250007 - Hanson-Fluor Lilly/LP1Y-TFS-EG-000-000-00-FGL_detached.rvt
4/20/2026 1:55:02 PM

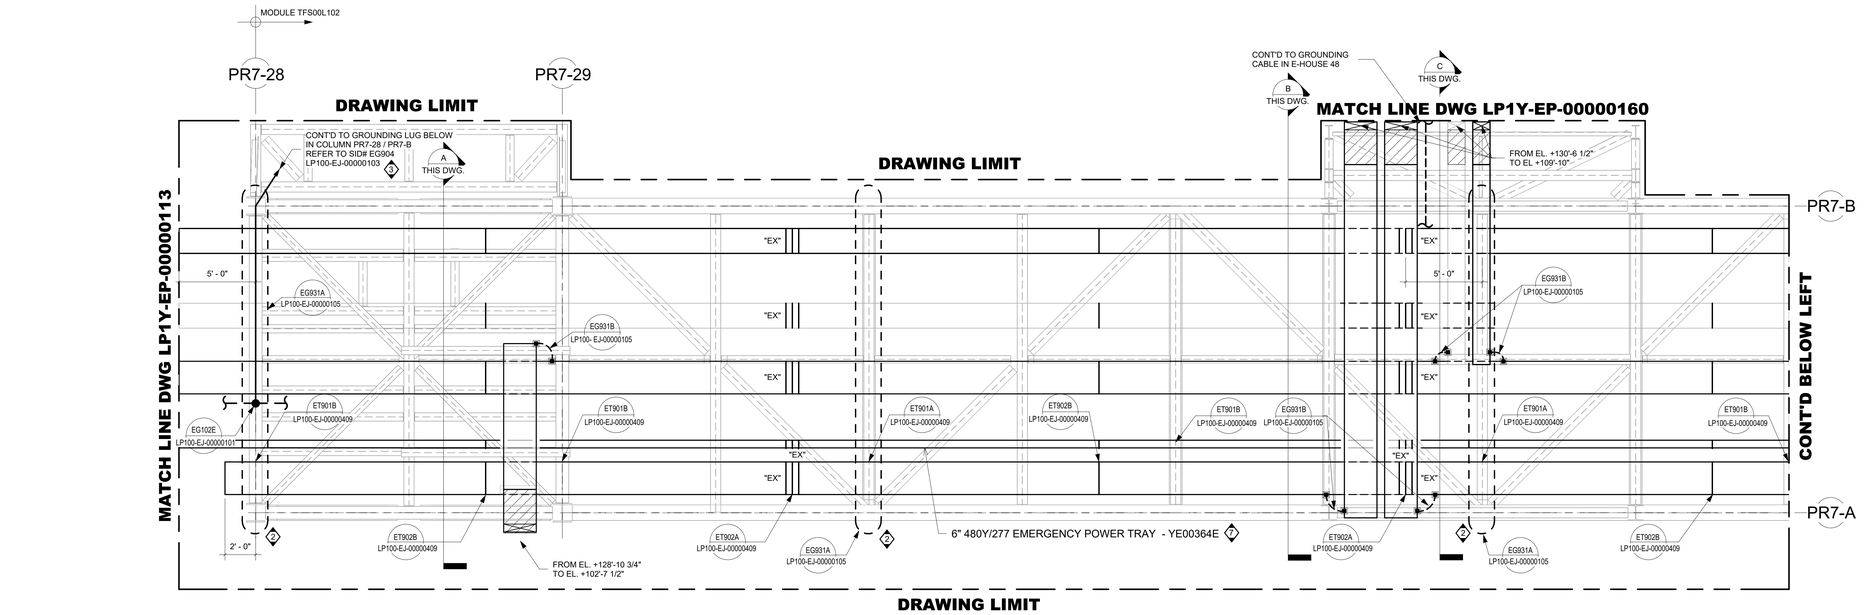


PLAN VIEW - TFS00L102

1/4" = 1'-0"

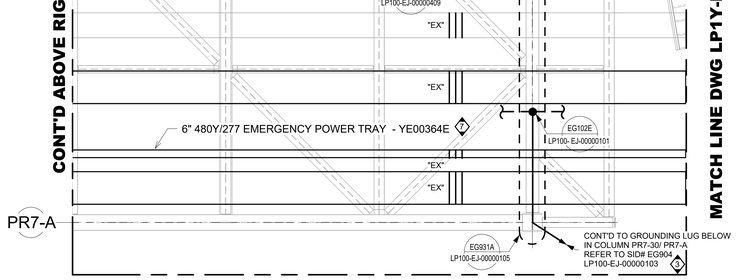


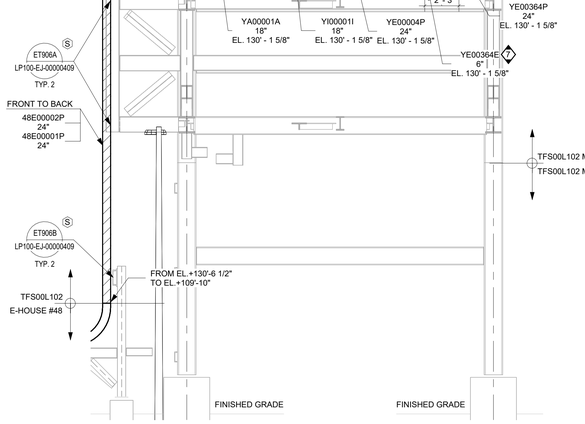


B SECTION
THIS DWG. 1/4" = 1'-0"

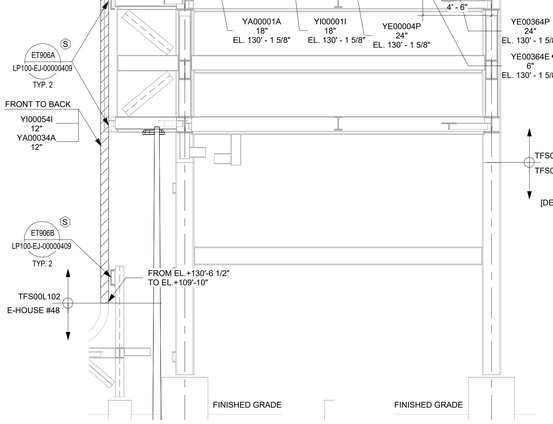


C SECTION
THIS DWG. 1/4" = 1'-0"

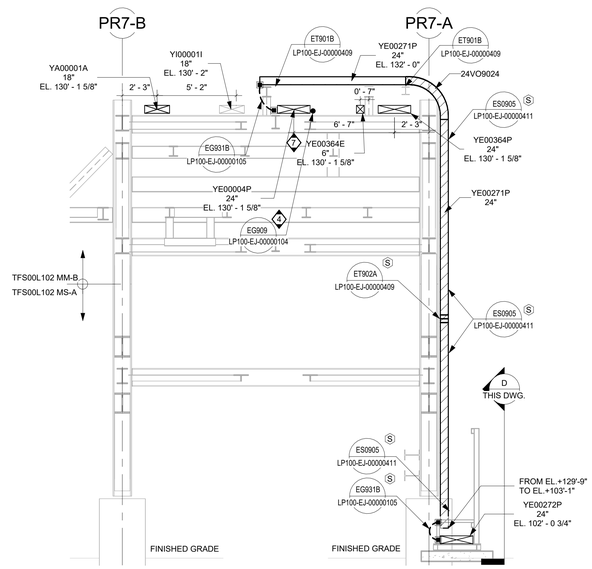

A SECTION
THIS DWG. 1/4" = 1'-0"

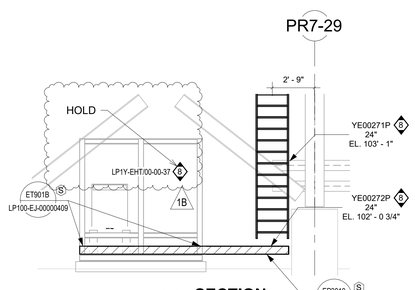

D SECTION
THIS DWG. 1/4" = 1'-0"

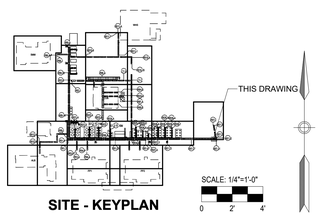

SITE - KEYPLAN

GENERAL NOTES:

1. ALL DIMENSIONS AND ELEVATIONS ARE IN FEET AND INCHES UNLESS NOTED OTHERWISE.
2. REFER TO CIVIL DRAWING B1LG-00-K004-00010 FOR FINISHED GRADE ELEVATION. ELEVATIONS SHOWN ARE PLANT COORDINATES. GEODETIC ELEVATION 926'-9 3/5" IS EQUAL TO PLANT COORDINATE ELEVATION 100'-0".
3. THE ELECTRICAL INSTALLATION SHALL COMPLY WITH THE 2009 EDITION OF THE INDIANA ELECTRICAL CODE AND THE 2023 NATIONAL ELECTRICAL CODE. IF THERE ARE DISCREPANCIES BETWEEN THE 2009 INDIANA ELECTRICAL CODE AND 2023 NEC, THE MOST STRINGENT REQUIREMENT SHALL APPLY.
4. REFER TO DRAWING LP100-EJ-00000001 FOR GENERAL NOTES AND DRAWINGS LP100-EJ-00000002 AND LP100-EJ-00000103 FOR LEGEND AND SYMBOLS.
5. REFER TO DRAWINGS LP100-EJ-00000400 SERIES FOR STANDARD CABLE TRAY INSTALLATION DETAILS.
6. REFER TO DRAWING LP100-EJ-00000100 SERIES FOR STANDARD GROUNDING INSTALLATION DETAILS.
7. REFER TO LP100-EJ-00000409 (ET903) FOR MODULE CABLE TRAY INSTALLATION GUIDE.
8. MODULE CONTRACTOR SHALL ENSURE ALL MATERIALS ATTACHED TO THE MODULE WILL NOT EXCEED THE SHIPPING VOLUME OF THE MODULE.
9. REFER TO LP100-265-EMS-16110 FOR CABLE TRAY SPECIFICATION AND CABLE TRAY COVER INSTALLATION REQUIREMENTS. TRAY COVERS, WHERE REQUIRED, SHALL BE INSTALLED AFTER ALL CABLES ARE PULLED AND SECURED.
10. CABLE TRAY SHALL BE 6" DEEP, 20FT SPANS, HEAVY-DUTY ALUMINIUM, LADDER TYPE WITH 9" RUNG SPACING, NEMA CLASS 20C+ UNLESS SPECIFIED OTHERWISE. CABLE TRAY DESIGN BASIS IS B-LINE HA6A HEAVY DUTY CABLE TRAY OR APPROVED EQUAL. ANY DEVIATIONS MAY REQUIRE CHANGES IN SUPPORTS, DESIGN, DETAILS, LOAD CAPACITIES, ETC. ANY CHANGES THAT RESULT IN CHANGES INCLUDING COSTS AND SCHEDULE SHALL BE BORNE BY THE CONTRACTOR.
11. INSTALLATION DETAILS SHOW TYPICAL CABLE TRAY FITTING TYPES TO BE USED. CONTRACTOR SHALL USE HEAVY-DUTY FITTINGS FOR ALL INSTALLATIONS INDICATED ON PLAN DRAWINGS.
12. CONTRACTOR SHALL USE THE INSTALLATION DETAILS AS SHOWN ON THIS PLAN DRAWING. WHERE INSTALLATION DETAILS ARE NOT SHOWN, CONTRACTOR SHALL VERIFY AND USE APPROPRIATE INSTALLATION DETAILS FROM TRAY INSTALLATION DETAILS SPECIFIED IN NOTE 5 AND DETERMINE THE FINAL LOCATION OF THE CABLE TRAY SUPPORT.
13. ALL CABLE TRAY HARDWARE SHALL BE 316SS UNLESS SPECIFIED OTHERWISE.
14. HEAVY DUTY EXPANSION SPLICE PLATES SHALL BE INSTALLED EVERY 40 FT. HEAVY DUTY MID-SPAN SPLICE PLATES SHALL BE USED AT ALL LOCATIONS (EXCEPT EXPANSION JOINTS) TO SUPPORT THE MAXIMUM CABLE, SNOW AND ICE LOADS.
15. FIXED HOLD DOWN CLAMPS FOR HORIZONTAL TRAYS SHALL BE INSTALLED AT ALL FITTINGS AND AT MID-POINTS BETWEEN EXPANSION JOINTS IN STRAIGHT RUNS. CABLE TRAYS GUIDE CLAMPS SHALL BE INSTALLED AT OTHER SUPPORT LOCATIONS.
16. FOR VERTICAL CABLE TRAY RUNS THAT ARE LONGER THAN 50FT, EXPANSION JOINT SHALL BE PROVIDED AT EVERY 20FT. SUPPORT OF VERTICAL TRAY DROP NEEDS TO BE SUPPORTED IN AT LEAST TWO LOCATIONS FOR A 20FT SPAN OF CABLE TRAY. REFER TO LP100-EJ-00000409 (ET906) FOR HOLD DOWN CLAMP OF VERTICAL CABLE TRAY.

LEGEND:

Ⓢ OR ▨ SHIP LOOSE

⊕ SCOPE SPLIT

EX EXPANSION JOINT

SHEET NOTES:

1. HEAVY DUTY EXPANSION AND HEAVY DUTY MID SPAN SPLICE PLATE ON STRAIGHT TRAYS SHALL BE INSTALLED AT 1/4 OF THE SUPPORT SPAN (5'-0" FROM THE SUPPORT).
2. GROUNDING CONNECTION FOR STACKED CABLE TRAY BONDING TO BE INSTALLED BY INSTALLATION CONTRACTOR EVERY 40 FEET (MAXIMUM). REFER TO DETAIL EG931A ON DRAWING LP100-EJ-00000105.
3. CABLE TRAY MAIN GROUND CABLE SHALL BE CONNECTED TO MAIN UNDERGROUND GROUND GRID VIA GROUND LUG PROVIDED ON COLUMN. COLUMN GROUND LUG CONNECTION AND FINAL CONNECTION TO MAIN GROUND GRID SHALL BE COMPLETED BY INSTALLATION CONTRACTOR. REFER TO UNDERGROUND GROUNDING PLAN.
4. SITE CONTRACTOR SHALL SUPPLY AND INSTALL ONE #4/0 AWG BARE STRANDED COPPER GROUND CONDUCTOR ON THE OUTSIDE OF THE SIDERAIL FOR THE ENTIRE LENGTH OF THE CABLE TRAY SHOWN.
5. THE CONTRACTOR SHALL SUPPLY AND INSTALL 3M COLD SHRINK CABLE SPLICE KIT, QS-III OR AN APPROVED EQUIVALENT FOR CONNECTION OF THE MV CABLES. WHEN SPLICING CABLES WITHIN THE SAME CABLE TRAY, THE SPLICES SHOULD BE STAGGERED. THE SPLICING LOCATION IN THE TRAY MUST HAVE A CABLE TRAY COVER TO GUARD AGAINST ENVIRONMENTAL ELEMENTS LIKE RAIN, SNOW OR DEBRIS. THE FINAL POSITIONING OF THE SPLICE KITS IS THE RESPONSIBILITY OF THE CONTRACTOR. THE CONTRACTOR SHALL REDLINE THE ELECTRICAL CABLE TRAY LAYOUT DRAWINGS WITH THE EXACT LOCATION OF THE SPLICES.
6. INSTALLATION CONTRACTOR SHALL SUPPLY AND INSTALL HEAVY DUTY TYPE HOLD DOWN CLAMP, EXPANSION GUIDE WHERE ES0905 IS SHOWN.
7. THE 6" 480Y/277 EMERGENCY POWER TRAY - YE00364E WILL CONTINUE AS PART OF K215 SCOPE WORK UNTIL LP1Y-EJB/00-00-324 LOCATED AT PR-7-27/PR7-A.
8. ELECTRICAL HEAT TRACE 277V POWER AND RTD CONTROL CABLES FOR K215 SCOPE WORK WILL BE ROUTED FROM PANEL LP1Y-EHT/00-00-37 TO THE HEAT TRACE COMPONENTS IN THE RAIL UNLOADING RACK AREA. REFER TO K215 THERMON ELECTRICAL HEAT TRACE DRAWINGS FOR MORE DETAILS. [DESIGN HOLD]

REFERENCE DRAWINGS & DOCUMENTS:

DOCUMENT NUMBER	DOCUMENT TITLE
LP1Y-EP-00000113	ELECTRICAL CABLE TRAY AND GROUNDING PLAN TANK FARM, EAST - WEST PIPERACK TFS00L101
LP1Y-EP-00000160	ELECTRICAL CABLE TRAY AND GROUNDING PLAN TANK FARM, E-HOUSE 48
LP1Y-EP-00U00027	ELECTRICAL UNDERGROUND GROUNDING PLAN TANK FARM, EAST - WEST PIPERACK
LP1Y-EL-00000301	ELECTRICAL DRAWING INDEX TANK FARM, CABLE TRAY, LIGHTING AND POWER
LP1Y-EL-00000302	ELECTRICAL DRAWING INDEX TANK FARM, ABOVEGROUND AND UNDERGROUND GROUNDING
LP1Y-EP-00000324	ELECTRICAL ABOVEGROUND GROUNDING PLAN TANK FARM, EAST - WEST PIPERACK
LP100-CS-30000001	CIVIL SITE PLAN OVERALL
B1LG-00-K004-00010	OVERALL CIVIL PLANS - PHASE 2
LP1Y-SF-0009B550	STRUCTURAL FRAMING ELEVATION SHT 1 BUILDING Y, SECTOR 9, SUB-SECTOR B TFS00L102
LP1Y-SF-0009B551	STRUCTURAL FRAMING ELEVATION SHT 2 BUILDING Y,SECTOR 9, SUB-SECTOR B TFS00L102
LP1Y-SF-0009P000	STRUCTURAL FOUNDATIONS BUILDING Y,SECTOR 9 TFS00L101,TFS00L102, & CABLE TRAY SUPT STR
LP142-265-LST-002	ELECTRICAL CABLE LIST - E HOUSE 42
LP148-265-LST-002	ELECTRICAL CABLE LIST - E HOUSE 48
LP1Y-EK-00000105	PANEL SCHEDULE Y-ELP/00-00-01
LP1Y-EK-00000405	JUNCTION BOX WIRING DIAGRAM
LP1Y-EL-00090001	ELECTRICAL LIGHTING PLAN - RAIL UNLOADING RACK
LP1Y-EP-0009B001	CABLE TRAY AND GROUNDING PLAN - PLATFORM LEVEL - RAIL UNLOADING RACK

REV	DATE	DES	ENG	CHK	APP	PM APP
1B	17-APR-2026	ML	AT	BM	RN	SS
1A	02-MAR-2026	ML	AJT	RDN	AJT	SS
1	05-NOV-2025	JB	MS	EA	TL	EM
0	11-APR-2025	MT	MS	JN	TL	EM
A	17-MAR-2025	JA	MS	JN	SB	EM

FLUOR® EFDEE Engineering PC PROJECT NO. B1LG NODE: TFS

Lilly

ELECTRICAL CABLE TRAY AND GROUNDING PLAN TANK FARM, EAST - WEST PIPERACK TFS00L102

REV	ZONE	PROJECT NUMBER / DESCRIPTION	CHANGE CONTROL	DATE
1B	ALL	ISSUED FOR REVIEW	NA	17-APR-2026
1A	ALL	ISSUED FOR REVIEW	NA	02-MAR-2026
1	ALL	ISSUED FOR CONSTRUCTION	NA	05-NOV-2025
0	ALL	ISSUED FOR CONSTRUCTION	NA	11-APR-2025
A	ALL	ISSUED FOR SQUAD CHECK (SQCK)	NA	17-MAR-2025

REVISIONS

CONFIDENTIAL INFORMATION


THIS DRAWING AND THE IDEAS AND DESIGNS SHOWN THEREON ARE THE EXCLUSIVE PROPERTY OF ELI LILLY AND COMPANY AND ARE NOT TO BE USED, REPRODUCED OR DISCLOSED, EITHER IN WHOLE OR IN PART, WITHOUT THE WRITTEN CONSENT OF ELI LILLY AND COMPANY.

SYSTEM TYPE: NA		EDIFICE/BUILDING: Y	LEVEL/FLOOR: 0
SUB DISCIPLINE: EP	LOCATION CODE: LP1	LOCATION/GRID	CCI CODE: YELLOW
CRITICAL QUALITY	ENTERPRISE GROUP: API	DRAWING INTENTION	PROJECT NAME: LP1-306-1181
CRITICAL BUSINESS	EQUIPMENT CLASSIFICATION: NA	ALTERNATE DOCUMENT ID: NA	DRAWING SCALE: 1/4" = 1'-0"
CRITICAL HSE	VENDOR: NA	DOCUMENT ID: LP1Y-EP-00000114	MERIDIAN REV: 1B
NON-CRITICAL	ENGINEERING AGENCY DOC ID: NA		


IF YOU ARE USING A PRINTED COPY OF THIS DOCUMENT, IT IS AN UNCONTROLLED PRINT. CONFIRM WITH THE OFFICIAL "ELECTRONIC RECORD" DOCUMENT IN THE GLOBAL ENGINEERING CONTENT MANAGEMENT SYSTEM.

IF YOU ARE USING A PRINTED COPY OF THIS DOCUMENT, IT IS AN UNCONTROLLED PRINT. CONFIRM WITH THE OFFICIAL "ELECTRONIC RECORD" DOCUMENT IN THE GLOBAL ENGINEERING CONTENT MANAGEMENT SYSTEM.


Autodesk Docs://265007 - Hanson Plot Lilly/LP1Y/TFS-E0-000-000-00-FSL_detached.rvt
4/20/2026 1:50:37 PM

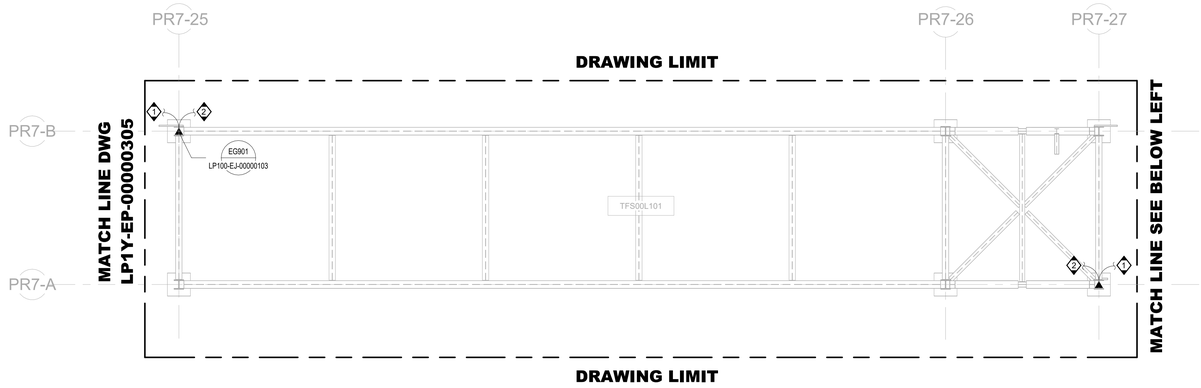

PLAN
1/8" = 1'-0"

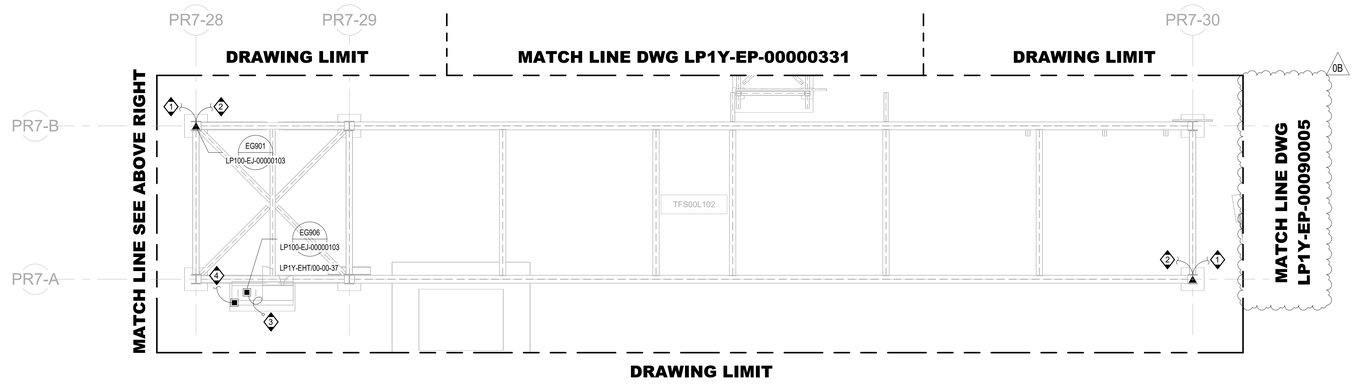

PLAN
1/8" = 1'-0"

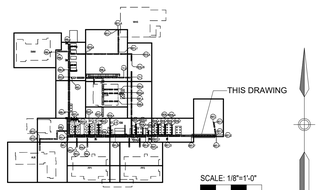

SITE - KEYPLAN

GENERAL NOTES:

1. THE ELECTRICAL INSTALLATION SHALL COMPLY WITH THE 2009 EDITION OF THE INDIANA ELECTRICAL CODE AND THE 2023 NATIONAL ELECTRICAL CODE. IF THERE ARE DISCREPANCIES BETWEEN THE 2009 INDIANA ELECTRICAL CODE AND 2023 NEC, THE MOST STRINGENT REQUIREMENT SHALL APPLY.
2. CONTRACTOR SHALL VERIFY THE LOCATION OF INSTRUMENT DEVICES / CABINETS / ENCLOSURES, ETC. AND INSTALL BOND CONDUCTORS AS REQUIRED.

SHEET NOTES:

1. INSTALLATION CONTRACTOR SHALL UNCOIL THE #4/0 AWG GROUND CONDUCTOR PROVIDED FOR UFER GROUNDING AND CONNECT TO STEEL COLUMN AS PER INSTALLATION DETAIL.
2. RUN #4/0 AWG GREEN INSULATED GROUND CONDUCTOR AND CONNECT TO GROUND LOOP ROUTED OUTSIDE THE FLANGE OF CABLE TRAY USING APPROPRIATE CONNECTORS. REFER TO CABLE TRAY AND GROUNDING PLAN.
3. INSTALLATION CONTRACTOR SHALL UNCOIL THE #4/0 AWG GROUND CONDUCTOR AND CONNECT TO EQUIPMENT AS PER INSTALLATION DETAIL.
4. BOND EHT SKID FRAME WITH SERVIT POST PROVIDED BY VENDOR TO #4/0 AWG GROUND CONDUCTOR IN CABLE TRAY.

REFERENCE DRAWINGS & DOCUMENTS:

DOCUMENT NUMBER	DOCUMENT TITLE
LP1Y-EL-00000302	ELECTRICAL DRAWING INDEX TANK FARM ABOVEGROUND AND UNDERGROUND GROUNDING
LP100-EJ-00000100 SERIES DRAWINGS	ELECTRICAL GROUNDING DETAILS
LP100-EJ-00000001 THRU LP100-EJ-00000003	GENERAL NOTES, LEGEND AND SYMBOLS
LP1Y-EP-00U00027	ELECTRICAL UNDERGROUND GROUNDING PLAN TANK FARM, EAST - WEST PIPERACK
LP1Y-EP-00000113	ELECTRICAL CABLE TRAY AND GROUNDING PLAN TANK FARM, EAST - WEST PIPERACK - TFS00L101
LP1Y-EP-00000114	ELECTRICAL CABLE TRAY AND GROUNDING PLAN TANK FARM, EAST - WEST PIPERACK - TFS00L102
LP1Y-SF-0009P000	STRUCTURAL FOUNDATIONS BUILDING Y, SECTOR 9 - TFS00L101, TFS00L102, & CABLE TRAY SUPT STR
LP1Y-EP-00090006	ELECTRICAL UNDERGROUND GROUNDING PLAN - RAIL UNLOADING RACK
LP1Y-EP-0009A001	ELECTRICAL CABLE TRAY AND GROUNDING PLAN GROUND LEVEL - RAIL UNLOADING RACK
LP1Y-EP-0009B001	ELECTRICAL CABLE TRAY AND GROUNDING PLAN PLATFORM LEVEL - RAIL UNLOADING RACK
LP1Y-EP-00090005	ELECTRICAL ABOVE GROUND GROUNDING PLAN - PLATFORM LEVEL - RAIL UNLOADING RACK
LP1Y-EP-00090001	ELECTRICAL ABOVE GROUND GROUNDING PLAN - GROUND LEVEL - RAIL UNLOADING RACK

0B

FLUOR®
EFDEE Engineering PC
PROJECT NO: 815.0
NODE: TFS

REV	DATE	DES	ENG	CHK	APP	PM APP
0B	17-APR-2026	ML	AT	BM	RN	SS
0A	02-MAR-2026	ML	AJT	RDN	AJT	SS
0	29-MAY-2025	AM	MS	EA	TL	EM
A	09-MAY-2025	AM	MS	EA	TL	EM

Lilly

ELECTRICAL ABOVEGROUND GROUNDING PLAN
TANK FARM, EAST - WEST PIPERACK

REV	ZONE	PROJECT NUMBER / DESCRIPTION	CHANGE CONTROL	DATE
0B	ALL	ISSUED FOR REVIEW	NA	17-APR-2026
0A	ALL	ISSUED FOR REVIEW	NA	02-MAR-2026
0	ALL	ISSUED FOR CONSTRUCTION	NA	29-MAY-2025
A	ALL	ISSUED FOR REVIEW	NA	09-MAY-2025

REVISIONS

CONFIDENTIAL INFORMATION

THIS DRAWING AND THE IDEAS AND DESIGNS SHOWN THEREON ARE THE EXCLUSIVE PROPERTY OF ELI LILLY AND COMPANY AND ARE NOT TO BE USED, REPRODUCED OR DISCLOSED, EITHER IN WHOLE OR IN PART, WITHOUT THE WRITTEN CONSENT OF ELI LILLY AND COMPANY.


SYSTEM TYPE: NA		EDIFICE/BUILDING: Y	LEVEL/FLOOR: 0
SUB DISCIPLINE: EP	LOCATION CODE: LP1	LOCATION/GRID: N/A	CCI CODE: YELLOW
CRITICAL QUALITY:		ENTERPRISE GROUP: API	DRAWING INTENTION:
CRITICAL BUSINESS:		EQUIPMENT CLASSIFICATION: NA	ALTERNATE DOCUMENT ID: NA
CRITICAL HSE:		VENDOR: NA	DOCUMENT ID: LP1Y-EP-00000324
NON-CRITICAL:		ENGINEERING AGENCY DOC ID: NA	

PROJECT NAME: LP1-306-1181
DRAWING SCALE: 1/8" = 1'-0"
MERIDIAN REV: 0B

Autodesk Docs://1580007 - Monroe Plus/Lilly/LP1/XY-TFS-ES/000-000/X00-FGL_detached.rvt
4/29/2026 1:05:51 PM

IF YOU ARE USING A PRINTED COPY OF THIS DOCUMENT, IT IS AN UNCONTROLLED PRINT. CONFIRM WITH THE OFFICIAL "ELECTRONIC RECORD" DOCUMENT IN THE GLOBAL ENGINEERING CONTENT MANAGEMENT SYSTEM.

IF YOU ARE USING A PRINTED COPY OF THIS DOCUMENT, IT IS AN UNCONTROLLED PRINT. CONFIRM WITH THE OFFICIAL "ELECTRONIC RECORD" DOCUMENT IN THE GLOBAL ENGINEERING CONTENT MANAGEMENT SYSTEM.

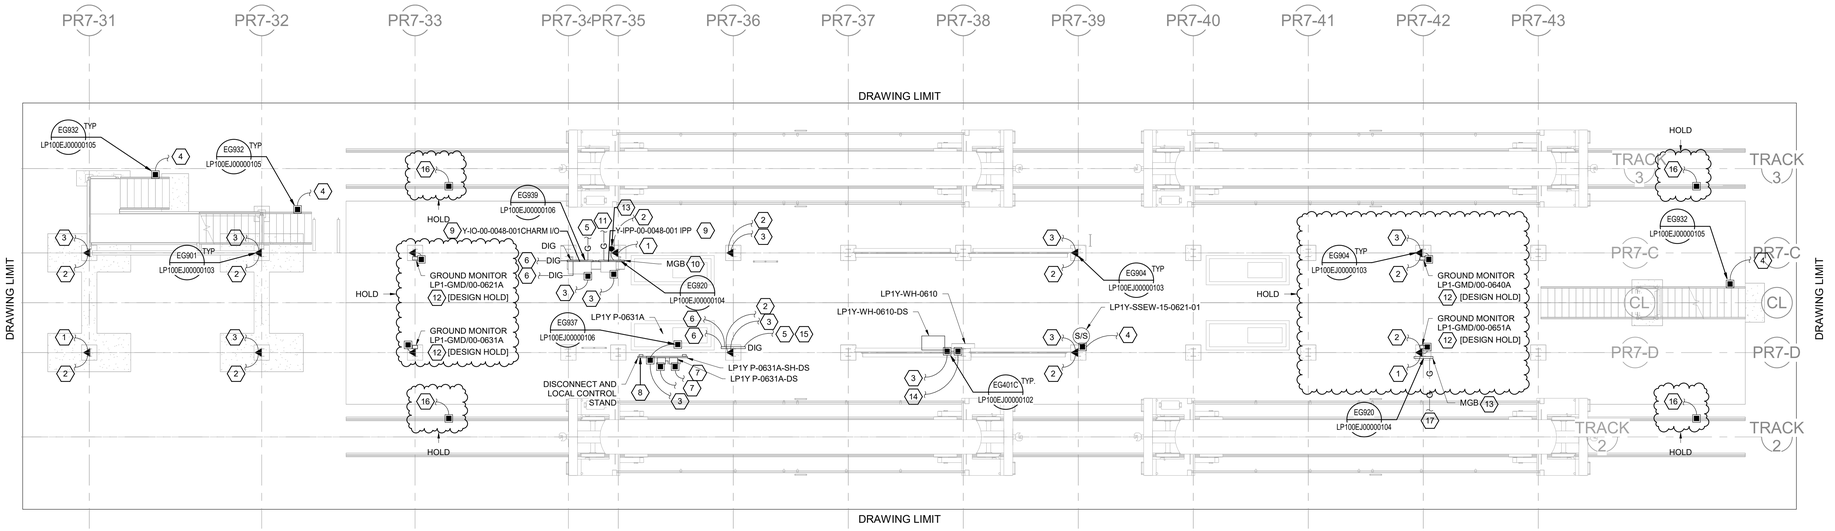

1 GROUNDING PLAN - ABOVE GROUND GROUND LEVEL

SCALE: 1/8" = 1'-0" 0 4' 8' 16'

REFERENCE DRAWINGS & DOCUMENTS


DOCUMENT NUMBER	DOCUMENT TITLE
LP1Y-EP-00000113	ELECTRICAL CABLE TRAY AND GROUNDING PLAN TANK FARM, EAST - WEST PIPERACK TFS00L101
LP1Y-EP-00000160	ELECTRICAL CABLE TRAY AND GROUNDING PLAN TANK FARM, E-HOUSE 48
LP1Y-EP-0009A001	ELECTRICAL CABLE TRAY AND GROUNDING PLAN GROUND LEVEL - RAIL UNLOADING RACK
LP1Y-EP-00000114	ELECTRICAL CABLE TRAY AND GROUNDING PLAN TANK FARM, EAST - WEST PIPERACK TFS00L102
LP1Y-EP-00U00027	ELECTRICAL UNDERGROUND GROUNDING PLAN TANK FARM, EAST - WEST PIPERACK
LP1Y-EP-00000324	ELECTRICAL ABOVEGROUND GROUNDING PLAN TANK FARM, EAST - WEST PIPERACK
LP1Y-CS-00000001	CIVIL SITE PLAN OVERALL
B1LG-00-K004-00010	OVERALL CIVIL PLANS - PHASE 2
LP1Y-EP-0009B001	ELECTRICAL CABLE TRAY AND GROUNDING PLAN PLATFORM LEVEL - RAIL UNLOADING RACK
LP1Y-SF-0009253	PLATFORM FRAMING PLAN - RAIL UNLOADING RACK
LP1Y-SF-0009254	CABLE TRAY SUPPORT FRAMING PLAN - RAIL UNLOADING RACK
LP1Y-265-EP-00000402	ELECTRICAL TYPICAL POWER DETAILS BUILDING Y TFS/CUB
LP1Y-EP-00090005	ELECTRICAL ABOVE GROUND GROUNDING PLAN - PLATFORM LEVEL - RAIL UNLOADING RACK
LP1Y-EP-00090006	ELECTRICAL UNDERGROUND GROUNDING PLAN -RAIL UNLOADING RACK

SHEET KEY NOTE:

1. INSTALLATION CONTRACTOR SHALL UNCOIL THE #4/0 GROUND CONDUCTOR PROVIDED FOR THE UFER GROUNDING AND CONNECT TO STEEL COLUMN AS PER INSTALLATION DETAIL.
2. RUN #4/0 AWG GREEN INSULATED GROUND CONDUCTOR AND CONNECT TO GROUND LOOP ROUTED OUTSIDE THE FLANGE OF CABLE TRAY USING APPROPRIATE CONNECTIONS. REFER TO CABLE TRAY AND GROUNDING PLAN
3. INSTALLATION CONTRACTOR SHALL UNCOIL THE #4/0 AWG GROUND CONDUCTOR AND CONNECT TO EQUIPMENT OR STEEL STRUCTURE AS PER INSTALLATION DETAIL. REFER TO UNDERGROUND GROUNDING PLAN.
4. INSTALLATION CONTRACTOR SHALL UNCOIL THE #2 AWG GROUND CONDUCTOR AND CONNECT TO EQUIPMENT OR STAIRS AS PER INSTALLATION DETAIL. REFER TO UNDERGROUND GROUNDING PLAN.
5. INSTALLATION CONTRACTOR SHALL UNCOIL THE #4/0 AWG GROUND CONDUCTOR AND CONNECT TO DIG GROUND BAR AS PER INSTALLATION DETAIL. REFER TO UNDERGROUND GROUNDING PLAN.
6. INSTALLATION CONTRACTOR SHALL ROUTE #1/0 AWG GREEN/YELLOW INSULATED DIG GROUND CONDUCTOR IN LOWER AUXILIARY CABLE TRAY, AND FIELD ROUTE AS REQUIRED AVOIDING ANY POWER CABLE TRAYS TO NEAREST DIG GROUND BAR AT E-HOUSE #48. CABLE ROUTE SHALL BE LIMITED TO A MAX LENGTH OF 300 FEET. SEE E-HOUSE #48 GROUNDING PLAN FOR MORE DETAILS.
7. BOND EQUIPMENT RACK OR FRAME TO #4/0 AWG CONDUCTOR IN CABLE TRAY.
8. INSTALLATION CONTRACTOR TO BOND CONTROL STATION STAND TO MOTOR FRAME USING #2 AWG GREEN INSULATED GROUND CONDUCTOR.
9. SEE DETAIL 2 ON SHEET LP1Y-EP-00090006 FOR CHARMS CABINET GROUNDING DETAIL.
10. SEE DETAIL 3 ON SHEET LP1Y-EP-00090006 FOR GROUNDING TO UFER DETAIL.
11. INSTALLATION CONTRACTOR SHALL ROUTE #1/0 AWG GREEN INSULATED SAFETY/PE GROUND CONDUCTOR IN POWER CABLE TRAY, AND FIELD ROUTE AS REQUIRED TO MAIN GROUND BAR AT E-HOUSE #48. SEE E-HOUSE #48 GROUNDING PLAN FOR MORE DETAILS.
12. GROUND MONITORING SYSTEM FOR LOADING ARM. [DESIGN HOLD]. CONTRACTOR SHALL CONNECT EQUIPMENT TO ASSOCIATED GROUNDING CONNECTION ON THE STRUCTURAL BEAM NEXT TO THE GROUND MONITOR PANEL. — HOLD
13. CONNECT #4/0 AWG GREEN INSULATED GROUND CONDUCTOR FROM GROUND CONDUCTOR PROVIDED FROM THE UFER CONNECTION USING HYGROUND C-TAP COMPRESSION CONNECTOR AND CONNECT TO THE MAIN GROUND BAR.
14. INSTALLATION CONTRACTOR SHALL ROUTE #1/0 AWG GREEN/YELLOW INSULATED DIG GROUND CONDUCTOR FROM WATER HEATER DISCONNECT TO DIG GROUND BAR NEXT TO PUMP LP1Y P-0631A.
15. INSTALLATION CONTRACTOR SHALL ROUTE #1/0 AWG GREEN/YELLOW INSULATED DIG GROUND CONDUCTOR IN LOWER AUXILIARY CABLE TRAY AND FIELD ROUTE AS REQUIRED AVOIDING ANY POWER CABLE TRAYS TO DIG GROUND BAR AT CHARMS CABINET Y-IO-00-0048-001. MAX LENGTH OF 300 FEET.
16. INSTALLATION CONTRACTOR SHALL UNCOIL THE #4/0 AWG GROUND CONDUCTOR AND CONNECT TO THE RAIL SPUR GROUNDING CONNECTION POINTS. [DESIGN ON HOLD] — HOLD
17. INSTALLATION CONTRACTOR SHALL ROUTE #1/0 AWG GREEN INSULATED SAFETY/PE GROUND CONDUCTORS IN POWER CABLE TRAY, AND FIELD ROUTE AS REQUIRED TO MAIN GROUND BAR AT CHARMS CABINET Y-IO-00-0048-001.

GENERAL NOTES:

1. THE ELECTRICAL INSTALLATION SHALL COMPLY WITH THE 2009 EDITION OF THE INDIANA ELECTRICAL CODE AND THE 2023 NATIONAL ELECTRICAL CODE. IF THERE ARE DISCREPANCIES BETWEEN THE 2009 INDIANA ELECTRICAL CODE AND 2023 NEC, THE MOST STRINGENT REQUIREMENT SHALL APPLY.
2. ALL DIMENSIONS AND ELEVATIONS ARE IN FEET AND INCHES UNLESS NOTED OTHERWISE.
3. REFER TO CIVIL DRAWING B1LG-00-K004-00010 AND RAIL UNLOADING RACK STRUCTURAL DRAWINGS FOR FINISHED GRADE ELEVATION. ELEVATIONS SHOWN ARE PLANT COORDINATES. GEODETIC ELEVATION926'-9 3/5" IS EQUAL TO PLANT COORDINATE ELEVATION 100'-0".
4. THE MAIN GROUND LOOP SHALL BE #4/0 AWG BARE STRANDED COPPER CABLE AND SHALL BE BURIED 2'-6" MINIMUM BELOW FINISHED GRADE.
5. GROUND CABLES PENETRATING THROUGH FLOOR SLABS SHALL BE INSTALLED IN A 1-1/4" SCHEDULE 40 PVC CONDUIT SLEEVE PER DETAIL EG903 THAT EXTENDS 4" ABOVE FINISHED FLOOR AND GROUND CABLE SHALL EXTEND 10'-0" ABOVE FINISHED FLOOR FOR CONNECTION TO EQUIPMENT OR GROUND BUS BARS.
6. LOCATION OF RODS, TEST WELLS, GROUND CONDUCTORS AND EQUIPMENT GROUNDS ARE SHOWN DIAGRAMATICALLY. EXACT LOCATIONS SHALL BE DETERMINED IN THE FIELD.
7. CONSTRUCTION SHALL COORDINATE THE GROUNDING SYSTEM ROUTING TO AVOID UNDERGROUND AND ABOVEGROUND OBSTRUCTIONS PRIOR TO ANY EXCAVATION OR INSTALLATION WORK FOR THE GROUNDING SYSTEM.
8. ISOLATED, SENSITIVE ELECTRONIC GROUNDING ELECTRODE SYSTEMS SHALL BE INSTALLED AS INDICATED ON THE DRAWINGS AND SHALL BE BONDED TO OTHER GROUNDING ELECTRODES ON THE PREMISES AT ONE LOCATION.
9. GROUND CONDUCTORS EXPOSED OR ENCASED IN CONCRETE SHALL BE INSTALLED IN SCHEDULE 40 PVC CONDUIT WITH NON METALLIC BUSHINGS AT BOTH ENDS.
10. UFER GROUND WILL HAVE BARE GROUND WIRES ENCASED IN CONCRETE.
11. GROUND ROD SHALL BE INSTALLED APPROX. 60FT. (MAX) APART.
12. THE GROUNDING SYSTEM SHALL HAVE A RESISTANCE TO GROUND OF 1 Ω OR LESS.
13. CONTRACTOR SHALL USE THE INSTALLATION DETAILS AS SHOWN IN THE ELECTRICAL GROUNDING DETAILS LP100-EJ-00000100 SERIES DRAWINGS. WHERE INSTALLATION DETAILS ARE NOT SHOWN OR CLOSEST DETAIL IS SHOWN, CONTRACTOR TO VERIFY AND USE APPROPRIATE INSTALLATION PER PROJECT SPECIFICATIONS, DETAILS, FLUOR STANDARDS, AND NEC STANDARDS.
14. INSTALLATION CONTRACTOR SHALL COORDINATE WITH LIGHTNING PROTECTION CONTRACTOR.
15. REFER TO PDWB1LG-98-K060 FOR LIGHTNING PROTECTION DESIGN.
16. COORDINATION & REFER TO K036 RAIL SPUR GROUNDING SCOPE OF WORK [DESIGN ON HOLD]. — HOLD

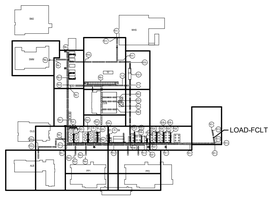

SITE - KEYPLAN

HANSON PROFESSIONAL SERVICES, INC.
www.hanson-inc.com
Offices Nationwide
11931 Wickchester Lane, Suite 370
Houston, TX 77043
(346) 297-1720

REV	DATE	DES	ENG	CHK	APP	PM APP
1	17-APR-26	MGL	AJT	RDN	AJT	SS

Lilly

ELECTRICAL ABOVE GROUND GROUNDING PLAN - GROUND LEVEL

RAIL UNLOADING RACK

REV	ZONE	PROJECT NUMBER / DESCRIPTION	CHANGE CONTROL	DATE
1	ALL	ISSUED FOR REVIEW	NA	17-APR-26

REVISIONS

CONFIDENTIAL INFORMATION


THIS DRAWING AND THE IDEAS AND DESIGNS SHOWN THEREON ARE THE EXCLUSIVE PROPERTY OF ELI LILLY AND COMPANY AND ARE NOT TO BE USED, REPRODUCED OR DISCLOSED, EITHER IN WHOLE OR IN PART, WITHOUT THE WRITTEN CONSENT OF ELI LILLY AND COMPANY.

SYSTEM TYPE: NA		EDIFICE/BUILDING: Y	LEVEL/FLOOR: 0
SUB DISCIPLINE:	LOCATION CODE: LP1	LOCATION/GRID: COL C-D / 33-43	CCI CODE: YELLOW
			PROJECT NAME: LP1-306-1181
CRITICAL QUALITY	ENTERPRISE GROUP: API	DRAWING INTENTION	DRAWING SCALE: As indicated
CRITICAL BUSINESS	EQUIPMENT CLASSIFICATION: NA	ALTERNATE DOCUMENT ID: NA	MERIDIAN REV: 0B
CRITICAL HSE	VENDOR: NA	DOCUMENT ID	LP1Y-EP-00090001
NON-CRITICAL	ENGINEERING AGENCY DOC ID: NA		

4/20/2026 11:32:26 AM Autodesk Docs://250007 - Hanson Fluor Lily\LP1(Y-TFS-EI)-000-00-00-HNS.rvt

IF YOU ARE USING A PRINTED COPY OF THIS DOCUMENT, IT IS AN UNCONTROLLED PRINT. CONFIRM WITH THE OFFICIAL "ELECTRONIC RECORD" DOCUMENT IN THE GLOBAL ENGINEERING CONTENT MANAGEMENT SYSTEM.

IF YOU ARE USING A PRINTED COPY OF THIS DOCUMENT, IT IS AN UNCONTROLLED PRINT. CONFIRM WITH THE OFFICIAL "ELECTRONIC RECORD" DOCUMENT IN THE GLOBAL ENGINEERING CONTENT MANAGEMENT SYSTEM.

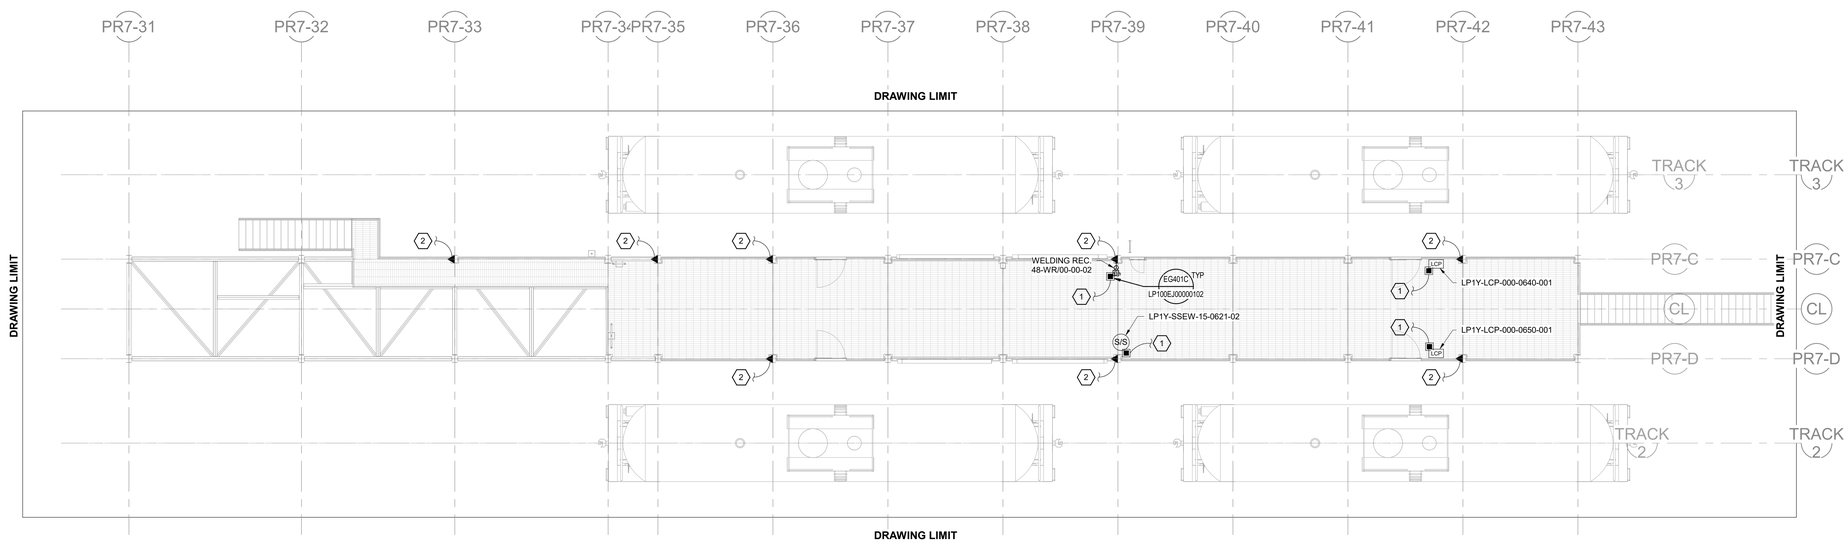

1 GROUNDING PLAN - ABOVE GROUND - PLATFORM LEVEL

SCALE: 1/8" = 1'-0" 0 4' 8' 16'

REFERENCE DRAWINGS & DOCUMENTS


DOCUMENT NUMBER	DOCUMENT TITLE
LP1Y-EP-00000113	ELECTRICAL CABLE TRAY AND GROUNDING PLAN TANK FARM, EAST - WEST PIPERACK TFS00L101
LP1Y-EP-00000160	ELECTRICAL CABLE TRAY AND GROUNDING PLAN TANK FARM, E-HOUSE 48
LP1Y-EP-0009A001	ELECTRICAL CABLE TRAY AND GROUNDING PLAN GROUND LEVEL - RAIL UNLOADING RACK
LP1Y-EP-00000114	ELECTRICAL CABLE TRAY AND GROUNDING PLAN TANK FARM, EAST - WEST PIPERACK TFS00L102
LP1Y-EP-00U00027	ELECTRICAL UNDERGROUND GROUNDING PLAN TANK FARM, EAST - WEST PIPERACK
LP1Y-EP-00000324	ELECTRICAL ABOVEGROUND GROUNDING PLAN TANK FARM, EAST - WEST PIPERACK
LP1Y-CS-00000001	CIVIL SITE PLAN OVERALL
B1LG-00-K004-00010	OVERALL CIVIL PLANS - PHASE 2
LP1Y-EP-0009B001	ELECTRICAL CABLE TRAY AND GROUNDING PLAN PLATFORM LEVEL - RAIL UNLOADING RACK
LP1Y-SF-0009253	PLATFORM FRAMING PLAN - RAIL UNLOADING RACK
LP1Y-SF-0009254	CABLE TRAY SUPPORT FRAMING PLAN - RAIL UNLOADING RACK
LP1Y-265-EP-00000402	ELECTRICAL TYPICAL POWER DETAILS BUILDING Y TFS/CUB
LP1Y-EP-00090001	ELECTRICAL ABOVE GROUND GROUNDING PLAN - GROUND LEVEL - RAIL UNLOADING RACK
LP1Y-EP-00090006	ELECTRICAL UNDERGROUND GROUNDING PLAN -RAIL UNLOADING RACK

SHEET KEY NOTE:

1. RUN #2 AWG GREEN INSULATED GROUND CONDUCTOR FROM EQUIPMENT TO GROUND LOOP ROUTED OUTSIDE THE FLANGE OF THE CABLE TRAY USING APPROPRIATE CONNECTIONS. REFER TO CABLE TRAY AND GROUNDING PLAN.
2. RUN #4/0 AWG GREEN INSULATED GROUND CONDUCTOR AND CONNECT TO GROUND LOOP ROUTED OUTSIDE THE FLANGE OF CABLE TRAY USING APPROPRIATE CONNECTIONS. REFER TO CABLE TRAY AND GROUNDING PLAN.

GENERAL NOTES:

1. THE ELECTRICAL INSTALLATION SHALL COMPLY WITH THE 2009 EDITION OF THE INDIANA ELECTRICAL CODE AND THE 2023 NATIONAL ELECTRICAL CODE. IF THERE ARE DISCREPANCIES BETWEEN THE 2009 INDIANA ELECTRICAL CODE AND 2023 NEC, THE MOST STRINGENT REQUIREMENT SHALL APPLY.
2. ALL DIMENSIONS AND ELEVATIONS ARE IN FEET AND INCHES UNLESS NOTED OTHERWISE.
3. REFER TO CIVIL DRAWING B1LG-00-K004-00010 AND RAIL UNLOADING RACK STRUCTURAL DRAWINGS FOR FINISHED GRADE ELEVATION. ELEVATIONS SHOWN ARE PLANT COORDINATES. GEODETIC ELEVATION926'-9 3/5" IS EQUAL TO PLANT COORDINATE ELEVATION 100'-0".
4. LOCATION OF RODS, TEST WELLS, GROUND CONDUCTORS AND EQUIPMENT GROUNDS ARE SHOWN DIAGRAMATICALLY. EXACT LOCATIONS SHALL BE DETERMINED IN THE FIELD.
5. CONSTRUCTION SHALL COORDINATE THE GROUNDING SYSTEM ROUTING TO AVOID UNDERGROUND AND ABOVEGROUND OBSTRUCTIONS PRIOR TO ANY EXCAVATION OR INSTALLATION WORK FOR THE GROUNDING SYSTEM.
6. ISOLATED, SENSITIVE ELECTRONIC GROUNDING ELECTRODE SYSTEMS SHALL BE INSTALLED AS INDICATED ON THE DRAWINGS AND SHALL BE BONDED TO OTHER GROUNDING ELECTRODES ON THE PREMISES AT ONE LOCATION.
7. CONTRACTOR SHALL USE THE INSTALLATION DETAILS AS SHOWN IN THE ELECTRICAL GROUNDING DETAILS LP100-EJ-00000100 SERIES DRAWINGS. WHERE INSTALLATION DETAILS ARE NOT SHOWN OR CLOSEST DETAIL IS SHOWN, CONTRACTOR TO VERIFY AND USE APPROPRIATE INSTALLATION PER PROJECT SPECIFICATIONS, DETAILS, FLUOR STANDARDS, AND NEC STANDARDS.
8. INSTALLATION CONTRACTOR SHALL COORDINATE WITH LIGHTNING PROTECTION CONTRACTOR
9. REFER TO PO# B1LG-98-K060 FOR LIGHTNING PROTECTION DESIGN.
10. COORDINATION & REFER TO K036 RAIL SPUR GROUNDING SCOPE OF WORK [DESIGN ON HOLD]. — HOLD

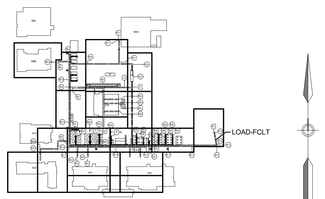

SITE - KEYPLAN

HANSON PROFESSIONAL SERVICES, INC.
www.hanson-inc.com
Offices Nationwide
11931 Wickchester Lane, Suite 370
Houston, TX 77043
(346) 297-1720

REV	DATE	DES	ENG	CHK	APP	PM APP
1	17-APR-26	MGL	AJT	RN	AJT	SS

ELECTRICAL ABOVE GROUND GROUNDING PLAN - PLATFORM LEVEL

RAIL UNLOADING RACK

REV	ZONE	PROJECT NUMBER / DESCRIPTION	CHANGE CONTROL	DATE
1	ALL	ISSUED FOR REVIEW	NA	17-APR-26

REVISIONS


CONFIDENTIAL INFORMATION
THIS DRAWING AND THE IDEAS AND DESIGNS SHOWN THEREON ARE THE EXCLUSIVE PROPERTY OF ELI LILLY AND COMPANY AND ARE NOT TO BE USED, REPRODUCED OR DISCLOSED, EITHER IN WHOLE OR IN PART, WITHOUT THE WRITTEN CONSENT OF ELI LILLY AND COMPANY.

SYSTEM TYPE: NA		EDIFICE/BUILDING: Y	LEVEL/FLOOR: 1
SUB DISCIPLINE	LOCATION CODE: LP1	LOCATION/GRID: COL C-D / 33-43	CCI CODE: YELLOW
			PROJECT NAME: LP1-306-1181
CRITICAL QUALITY	ENTERPRISE GROUP: API	DRAWING INTENTION	DRAWING SCALE: As indicated
CRITICAL BUSINESS	EQUIPMENT CLASSIFICATION: NA	ALTERNATE DOCUMENT ID: NA	MERIDIAN REV: 0B
CRITICAL HSE	VENDOR: NA	DOCUMENT ID	LP1Y-EP-00090005
NON-CRITICAL	ENGINEERING AGENCY DOC ID: NA		

IF YOU ARE USING A PRINTED COPY OF THIS DOCUMENT, IT IS AN UNCONTROLLED PRINT. CONFIRM WITH THE OFFICIAL "ELECTRONIC RECORD" DOCUMENT IN THE GLOBAL ENGINEERING CONTENT MANAGEMENT SYSTEM.

IF YOU ARE USING A PRINTED COPY OF THIS DOCUMENT, IT IS AN UNCONTROLLED PRINT. CONFIRM WITH THE OFFICIAL "ELECTRONIC RECORD" DOCUMENT IN THE GLOBAL ENGINEERING CONTENT MANAGEMENT SYSTEM.

4/20/2026 8:49:33 AM Autodesk Docs://250007 - Hanson-Fluor Lilly/LP1Y-TFS-ED-000-000-00-HNS.rvt

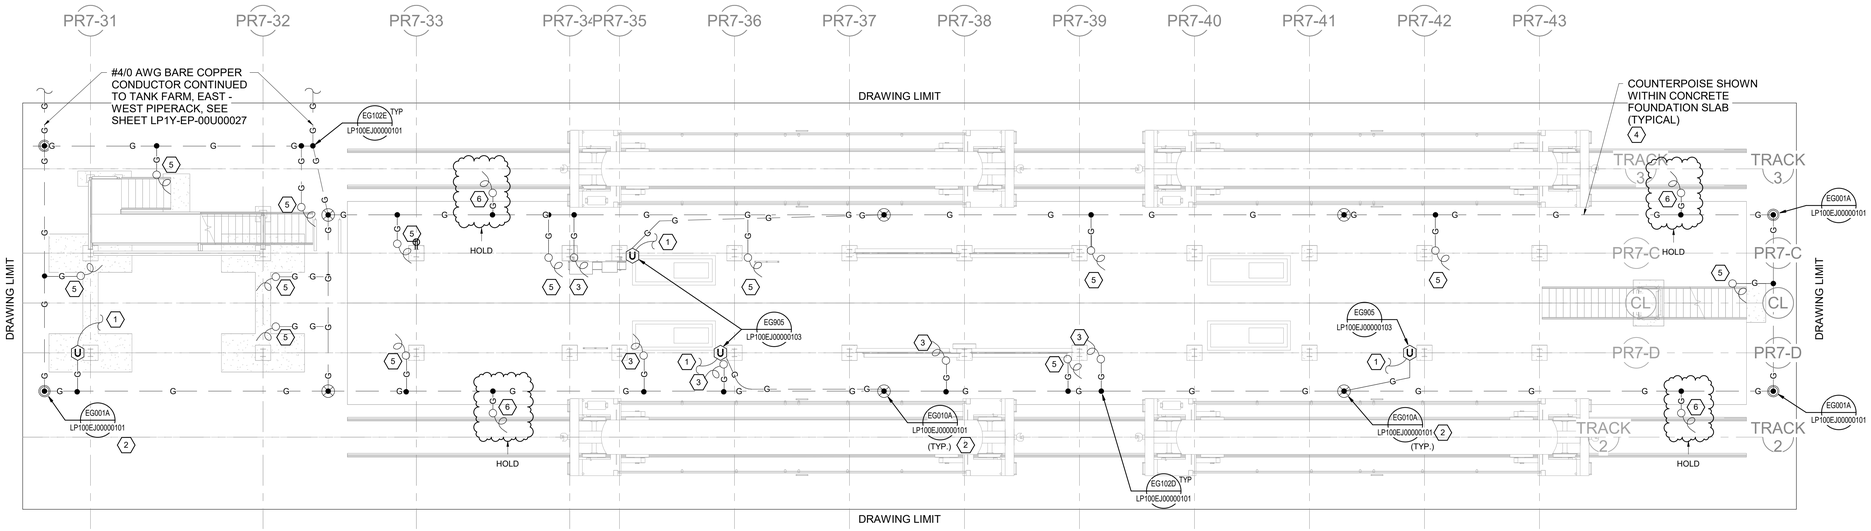


1 GROUNDING PLAN - UNDERGROUND

SCALE: 1/8" = 1'-0" 0 4' 8' 16'

REFERENCE DRAWINGS & DOCUMENTS

DOCUMENT NUMBER	DOCUMENT TITLE
LP1Y-EP-00000113	ELECTRICAL CABLE TRAY AND GROUNDING PLAN TANK FARM, EAST - WEST PIPERACK TFS00L101
LP1Y-EP-00000160	ELECTRICAL CABLE TRAY AND GROUNDING PLAN TANK FARM, E-HOUSE 48
LP1Y-EP-0009A001	ELECTRICAL CABLE TRAY AND GROUNDING PLAN GROUND LEVEL - RAIL UNLOADING RACK
LP1Y-EP-00000114	ELECTRICAL CABLE TRAY AND GROUNDING PLAN TANK FARM, EAST - WEST PIPERACK TFS00L102
LP1Y-EP-00U00027	ELECTRICAL UNDERGROUND GROUNDING PLAN TANK FARM, EAST - WEST PIPERACK
LP1Y-EP-00000324	ELECTRICAL ABOVEGROUND GROUNDING PLAN TANK FARM, EAST - WEST PIPERACK
LP1Y-CS-00000001	CIVIL SITE PLAN OVERALL
B1LG-00-K004-00010	OVERALL CIVIL PLANS - PHASE 2
LP1Y-EP-0009B001	ELECTRICAL CABLE TRAY AND GROUNDING PLAN PLATFORM LEVEL - RAIL UNLOADING RACK
LP1Y-SF-0009253	PLATFORM FRAMING PLAN - RAIL UNLOADING RACK
LP1Y-SF-0009254	CABLE TRAY SUPPORT FRAMING PLAN - RAIL UNLOADING RACK
LP1Y-265-EP-00000402	ELECTRICAL TYPICAL POWER DETAILS BUILDING Y TFS/CUB
LP1Y-EP-00090005	ELECTRICAL ABOVE GROUND GROUNDING PLAN - PLATFORM LEVEL - RAIL UNLOADING RACK
LP1Y-EP-00090001	ELECTRICAL ABOVE GROUND GROUNDING PLAN - GROUND LEVEL - RAIL UNLOADING RACK

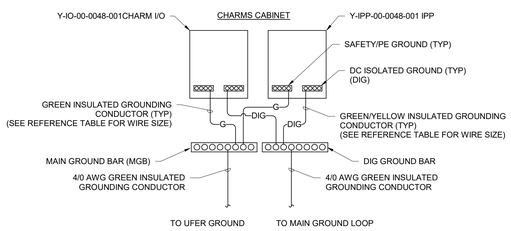


RECOMMENDED WIRE SIZES (CHARMS CABINET)

MAX WIRE LENGTH	WIRE SIZE
100'	2 AWG
300'	1/0 AWG

2 CHARMS CABINET GROUNDING DETAIL

NTS

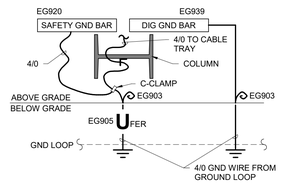

3 GROUNDING TO UFER DETAIL

NTS

SHEET KEY NOTE:


1. INSTALLATION CONTRACTOR SHALL COIL AND PROTECT 10' #4/0 AWG GREEN INSULATED COPPER STRANDED GROUND CONDUCTOR FOR CONNECTION TO STEEL COLUMN.
2. GROUND ROD SHALL BE INSTALLED FOR EACH UFER GROUND CONNECTION AS SHOWN, AND ADDITIONAL GROUND RODS IN BETWEEN APPROX. 60 FT. (MAX.) APART. CONTRACTOR TO ADD ADDITIONAL CONNECTIONS TO GROUND RODS AS REQUIRED.
3. INSTALLATION CONTRACTOR SHALL COIL AND PROTECT #4/0 AWG GREEN INSULATED COPPER STRANDED GROUND CONDUCTOR FOR EQUIPMENT GROUNDING.
4. 4/0 AWG BARE COPPER STRANDED GROUND CONDUCTOR INSTALLED WITHIN CONCRETE SLAB AS A UFER GROUND COUNTERPOISE.
5. INSTALLATION CONTRACTOR SHALL COIL AND PROTECT #4/0 AWG GREEN INSULATED COPPER STRANDED GROUND CONDUCTOR FOR STEEL STRUCTURE OR STAIRWAY STRUCTURE GROUNDING.
6. INSTALLATION CONTRACTOR SHALL COIL AND PROTECT #4/0 AWG GREEN INSULATED COPPER STRANDED GROUND CONDUCTOR FOR K036 RAIL SPUR GROUNDING CONNECTION POINTS. [DESIGN ON HOLD].

HOLD

GENERAL NOTES:

1. THE ELECTRICAL INSTALLATION SHALL COMPLY WITH THE 2009 EDITION OF THE INDIANA ELECTRICAL CODE AND THE 2023 NATIONAL ELECTRICAL CODE. IF THERE ARE DISCREPANCIES BETWEEN THE 2009 INDIANA ELECTRICAL CODE AND 2023 NEC, THE MOST STRINGENT REQUIREMENT SHALL APPLY.
2. ALL DIMENSIONS AND ELEVATIONS ARE IN FEET AND INCHES UNLESS NOTED OTHERWISE.
3. REFER TO CIVIL DRAWING B1LG-00-K004-00010 AND RAIL UNLOADING RACK STRUCTURAL DRAWINGS FOR FINISHED GRADE ELEVATION. ELEVATIONS SHOWN ARE PLANT COORDINATES. GEODETIC ELEVATION926'-9 3/5" IS EQUAL TO PLANT COORDINATE ELEVATION 100'-0".
4. THE MAIN GROUND LOOP SHALL BE #4/0 AWG BARE STRANDED COPPER CABLE AND SHALL BE BURIED 2'-6" MINIMUM BELOW FINISHED GRADE.
5. GROUND CABLES PENETRATING THROUGH FLOOR SLABS SHALL BE INSTALLED IN A 1-1/4" SCHEDULE 40 PVC CONDUIT SLEEVE PER DETAIL EG903 THAT EXTENDS 4" ABOVE FINISHED FLOOR AND GROUND CABLE SHALL EXTEND 10'-0" ABOVE FINISHED FLOOR FOR CONNECTION TO EQUIPMENT OR GROUND BUS BARS.
6. LOCATION OF RODS, TEST WELLS, GROUND CONDUCTORS AND EQUIPMENT GROUNDS ARE SHOWN DIAGRAMATICALLY. EXACT LOCATIONS SHALL BE DETERMINED IN THE FIELD.
7. CONSTRUCTION SHALL COORDINATE THE GROUNDING SYSTEM ROUTING TO AVOID UNDERGROUND AND ABOVEGROUND OBSTRUCTIONS PRIOR TO ANY EXCAVATION OR INSTALLATION WORK FOR THE GROUNDING SYSTEM.
8. ISOLATED, SENSITIVE ELECTRONIC GROUNDING ELECTRODE SYSTEMS SHALL BE INSTALLED AS INDICATED ON THE DRAWINGS AND SHALL BE BONDED TO OTHER GROUNDING ELECTRODES ON THE PREMISES AT ONE LOCATION.
9. GROUND CONDUCTORS EXPOSED OR ENCASED IN CONCRETE SHALL BE INSTALLED IN SCHEDULE 40 PVC CONDUIT WITH NON METALLIC BUSHINGS AT BOTH ENDS.
10. UFER GROUND WILL HAVE BARE GROUND WIRES ENCASED IN CONCRETE.
11. GROUND ROD SHALL BE INSTALLED APPROX. 60FT. (MAX) APART.
12. THE GROUNDING SYSTEM SHALL HAVE A RESISTANCE TO GROUND OF 1 Ω OR LESS.
13. CONTRACTOR SHALL USE THE INSTALLATION DETAILS AS SHOWN IN THE ELECTRICAL GROUNDING DETAILS LP100-EJ-00000100 SERIES DRAWINGS. WHERE INSTALLATION DETAILS ARE NOT SHOWN OR CLOSEST DETAIL IS SHOWN, CONTRACTOR TO VERIFY AND USE APPROPRIATE INSTALLATION PER PROJECT SPECIFICATIONS, DETAILS, FLUOR STANDARDS, AND NEC STANDARDS.
14. INSTALLATION CONTRACTOR SHALL COORDINATE WITH LIGHTNING PROTECTION CONTRACTOR.
15. REFER TO DWG B1LG-98-K060 FOR LIGHTNING PROTECTION DESIGN.
16. COORDINATION & REFER TO K036 RAIL SPUR GROUNDING SCOPE OF WORK [DESIGN ON HOLD].

HOLD

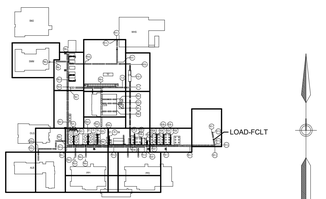

SITE - KEYPLAN

REV	ZONE	PROJECT NUMBER / DESCRIPTION	CHANGE CONTROL	DATE
B	ALL	ISSUED FOR REVIEW	NA	17-APR-2026
A	ALL	ISSUED FOR REVIEW	NA	02-MAR-2026

REVISIONS

CONFIDENTIAL INFORMATION

THIS DRAWING AND THE IDEAS AND DESIGNS SHOWN THEREON ARE THE EXCLUSIVE PROPERTY OF ELI LILLY AND COMPANY AND ARE NOT TO BE USED, REPRODUCED OR DISCLOSED, EITHER IN WHOLE OR IN PART, WITHOUT THE WRITTEN CONSENT OF ELI LILLY AND COMPANY.

HANSON PROFESSIONAL SERVICES, INC.
www.hanson-inc.com
Offices Nationwide
11931 Wickchester Lane, Suite 370
Houston, TX 77043
(346) 297-1720

REV	DATE	DES	ENG	CHK	APP	PM APP
1	17-APR-2026	ML	AT	BM	RN	SS
A	02-MAR-2026	MGL	AJT	RDN	AJT	SS

Lilly

ELECTRICAL UNDERGROUND GROUNDING PLAN

RAIL UNLOADING RACK

SYSTEM TYPE: NA		EDIFICE/BUILDING: Y	LEVEL/FLOOR: 0
SUB DISCIPLINE: LP1	LOCATION CODE	LOCATION/GRID: COL C-D / 33-43	CCI CODE: YELLOW
CRITICAL QUALITY		ENTERPRISE GROUP: API	PROJECT NAME: LP1-306-1181
CRITICAL BUSINESS		EQUIPMENT CLASSIFICATION: NA	DRAWING INTENTION
CRITICAL HSE		VENDOR: NA	DRAWING SCALE: As indicated
NON-CRITICAL		ENGINEERING AGENCY DOC ID: NA	ALTERNATE DOCUMENT ID: NA
			MERIDIAN REV: 0B
			DOCUMENT ID: LP1Y-EP-00090006

IF YOU ARE USING A PRINTED COPY OF THIS DOCUMENT, IT IS AN UNCONTROLLED PRINT. CONFIRM WITH THE OFFICIAL "ELECTRONIC RECORD" DOCUMENT IN THE GLOBAL ENGINEERING CONTENT MANAGEMENT SYSTEM.


IF YOU ARE USING A PRINTED COPY OF THIS DOCUMENT, IT IS AN UNCONTROLLED PRINT. CONFIRM WITH THE OFFICIAL "ELECTRONIC RECORD" DOCUMENT IN THE GLOBAL ENGINEERING CONTENT MANAGEMENT SYSTEM.

4/20/2026 12:28:01 PM Autodesk Docs://250007 - Hanson-Fluor Lilly/LP1Y-TFS-EG-000-000-00-HNS.rvt

A1 - DATA COMPLETE - NO COMMENTS - DO NOT RESUBMIT


Authorization to proceed does not relieve Contractor/Supplier of its responsibility or liability under the Contract and or Purchase Order.

By: Ricardo DaCosta dac54131 April 20, 2026

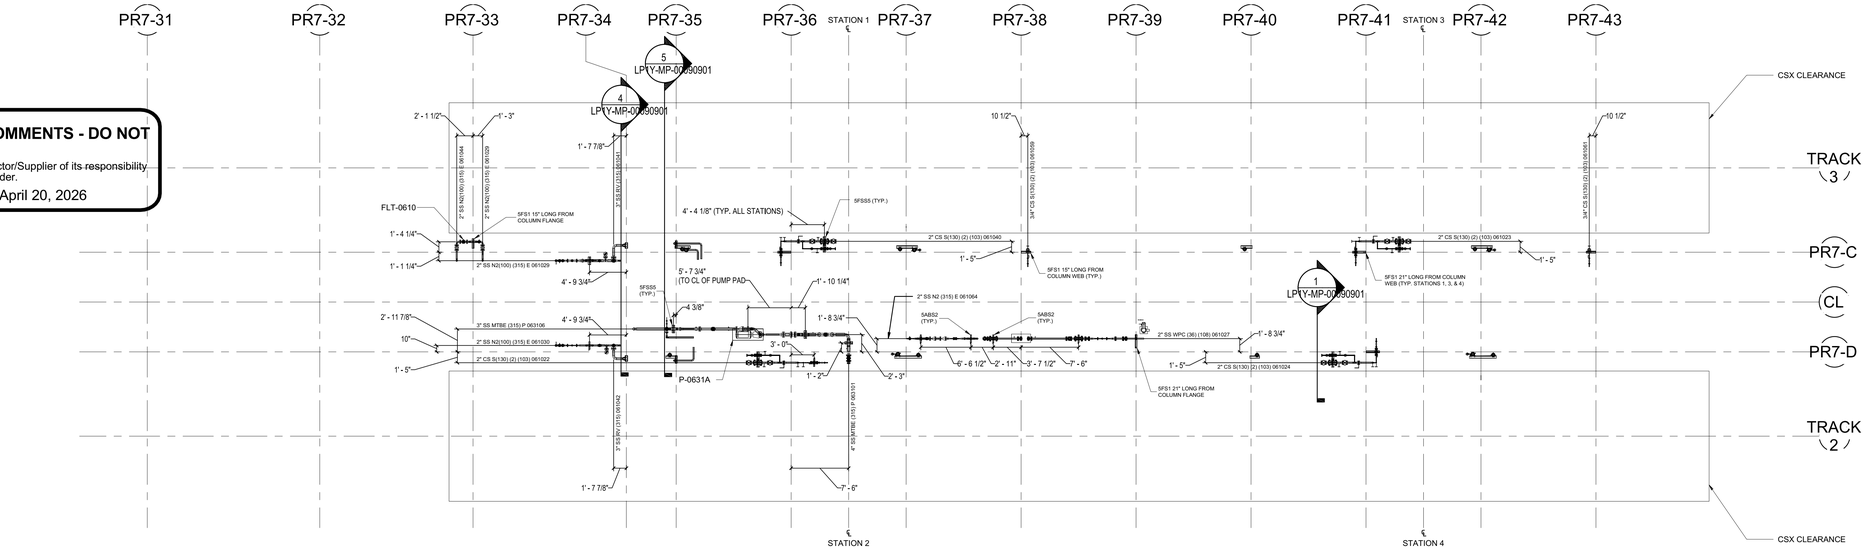


1 GROUND LEVEL PLAN

SCALE: 1/8" = 1'-0" 0 4' 8' 16'

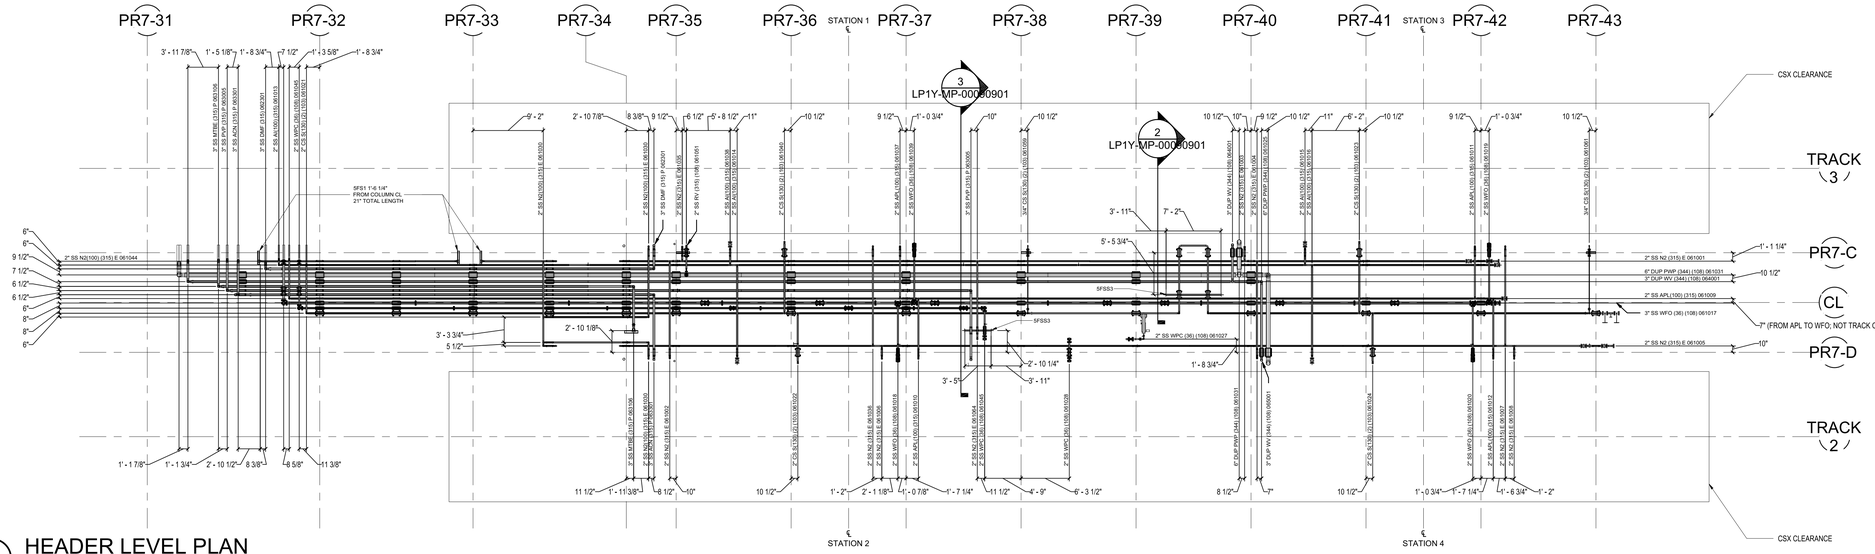

2 HEADER LEVEL PLAN

SCALE: 1/8" = 1'-0" 0 4' 8' 16'

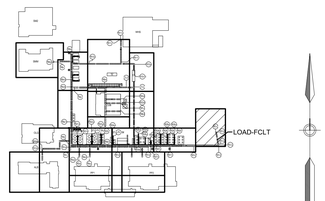

SITE - KEYPLAN

HANSON™

HANSON PROFESSIONAL SERVICES, INC.
www.hanson-inc.com
Offices Nationwide

11531 Wickchester Lane, Suite 370
Houston, TX 77043
(346) 297-1720

REV	DATE	DES	ENG	CHK	APP	PM APP
1	10-APR-26	DRW	MDW	DQR	MDW	SS

Lilly

MECHANICAL PIPING PLAN - BELOW PLATFORM

RAIL UNLOADING RACK

REV	ZONE	PROJECT NUMBER / DESCRIPTION	CHANGE CONTROL	DATE
1	ALL	ISSUE FOR REVIEW	NA	10-APR-26

REVISIONS

CONFIDENTIAL INFORMATION

THIS DRAWING AND THE IDEAS AND DESIGNS SHOWN THEREON ARE THE EXCLUSIVE PROPERTY OF ELI LILLY AND COMPANY AND ARE NOT TO BE USED, REPRODUCED OR DISCLOSED, EITHER IN WHOLE OR IN PART, WITHOUT THE WRITTEN CONSENT OF ELI LILLY AND COMPANY.

SYSTEM TYPE: NA		EDIFICE/BUILDING: Y	LEVEL/FLOOR: 0
SUB DISCIPLINE:	LOCATION CODE: LP1	LOCATION/GRID: COL C-D / 33-43	CCI CODE: YELLOW
CRITICAL QUALITY:		ENTERPRISE GROUP: API	DRAWING INTENTION:
CRITICAL BUSINESS:		EQUIPMENT CLASSIFICATION: NA	ALTERNATE DOCUMENT ID: NA
CRITICAL HSE:		VENDOR: NA	DOCUMENT ID: LP1Y-MP-00090001
NON-CRITICAL:		ENGINEERING AGENCY DOC ID: NA	

PROJECT NAME: LP1-306-1181

DRAWING SCALE: 1/8" = 1'-0"


MERIDIAN REV

4/5/2026 10:38:33 PM Autodesk Docs://250007 - Hanson-Fluor Lilly/LP1/DY-TFS-ED-000-000-00-HNS.rvt

IF YOU ARE USING A PRINTED COPY OF THIS DOCUMENT, IT IS AN UNCONTROLLED PRINT. CONFIRM WITH THE OFFICIAL "ELECTRONIC RECORD" DOCUMENT IN THE GLOBAL ENGINEERING CONTENT MANAGEMENT SYSTEM.

IF YOU ARE USING A PRINTED COPY OF THIS DOCUMENT, IT IS AN UNCONTROLLED PRINT. CONFIRM WITH THE OFFICIAL "ELECTRONIC RECORD" DOCUMENT IN THE GLOBAL ENGINEERING CONTENT MANAGEMENT SYSTEM.

BTLG-00-K215-00314-1_LP1Y-MP-00090002.pdf

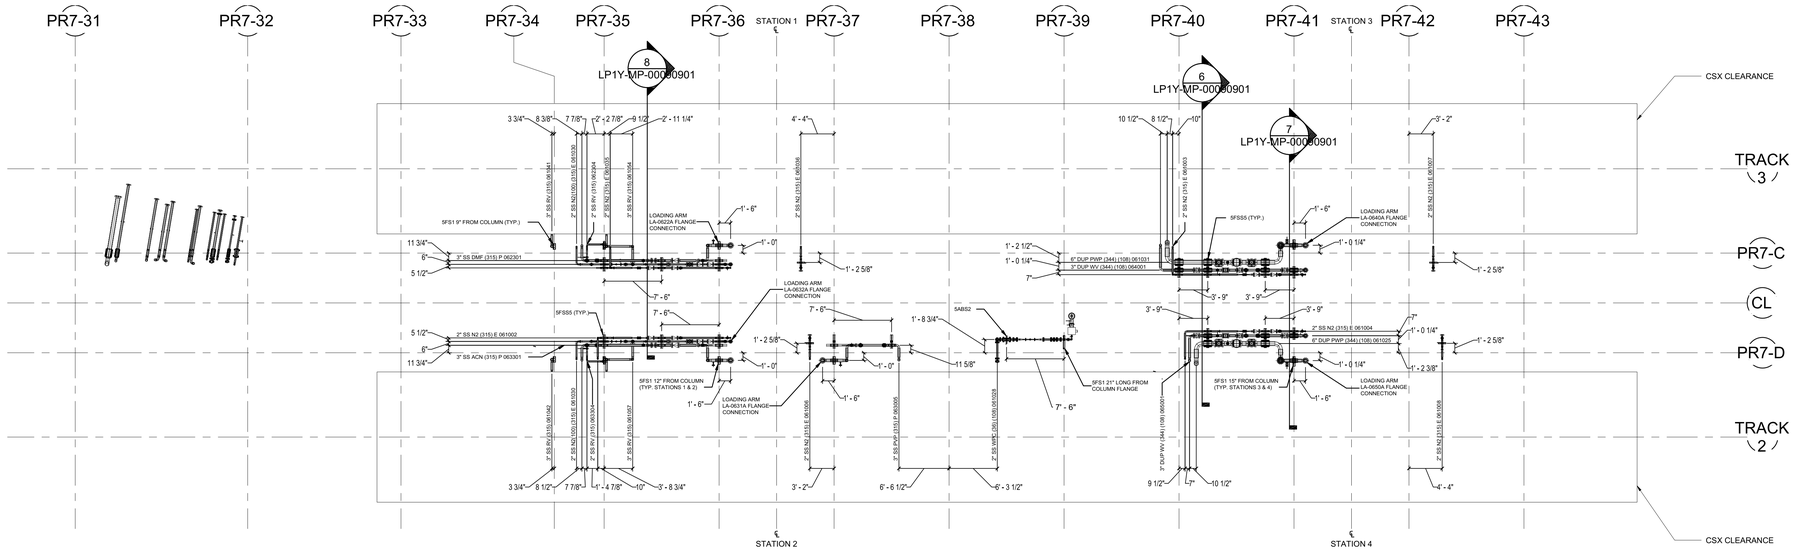

1 PLATFORM LEVEL PLAN


SCALE: 1/8" = 1'-0"

0 4' 8' 16'

A1 - DATA COMPLETE - NO COMMENTS - DO NOT RESUBMIT

Authorization to proceed does not relieve Contractor/Supplier of its responsibility or liability under the Contract and or Purchase Order.

By: Ricardo DaCosta dac54131 April 20, 2026

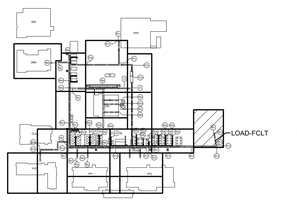

SITE - KEYPLAN

REV	ZONE	PROJECT NUMBER / DESCRIPTION	CHANGE CONTROL	DATE
ALL		ISSUE FOR REVIEW	NA	10-APR-26

REVISIONS

CONFIDENTIAL INFORMATION

THIS DRAWING AND THE IDEAS AND DESIGNS SHOWN THEREON ARE THE EXCLUSIVE PROPERTY OF ELI LILLY AND COMPANY AND ARE NOT TO BE USED, REPRODUCED OR DISCLOSED, EITHER IN WHOLE OR IN PART, WITHOUT THE WRITTEN CONSENT OF ELI LILLY AND COMPANY.

HANSON PROFESSIONAL SERVICES, INC.
www.hanson-inc.com
Offices Nationwide

11931 Wickchester Lane, Suite 370
Houston, TX 77043
(346) 297-1720

REV	DATE	DES	ENG	CHK	APP	PM APP
	10-APR-26	DRW MDW	DQR MDW	MDW	SS	

Lilly

MECHANICAL PIPING PLAN - ABOVE PLATFORM

RAIL UNLOADING RACK


SYSTEM TYPE: NA			EDIFICE/BUILDING: Y	LEVEL/FLOOR: 0
SUB DISCIPLINE: LP1	LOCATION CODE:	LOCATION/GRID: COL C-D / 33-43	CCI CODE: YELLOW	PROJECT NAME: LP1-306-1181
CRITICAL QUALITY:		ENTERPRISE GROUP: API	DRAWING INTENTION:	DRAWING SCALE: 1/8" = 1'-0"
CRITICAL BUSINESS:		EQUIPMENT CLASSIFICATION: NA	ALTERNATE DOCUMENT ID: NA	MERIDIAN REV
CRITICAL HSE:		VENDOR: NA	DOCUMENT ID: LP1Y-MP-00090002	
NON-CRITICAL:		ENGINEERING AGENCY DOC ID: NA		

IF YOU ARE USING A PRINTED COPY OF THIS DOCUMENT, IT IS AN UNCONTROLLED PRINT. CONFIRM WITH THE OFFICIAL "ELECTRONIC RECORD" DOCUMENT IN THE GLOBAL ENGINEERING CONTENT MANAGEMENT SYSTEM.

4/7/2026 12:55:55 PM Autodesk Docs://250007 - Hanson-Fluor Lilly/LP1Y-ITFS-EO-000-00-00-HNS.rvt


IF YOU ARE USING A PRINTED COPY OF THIS DOCUMENT, IT IS AN UNCONTROLLED PRINT. CONFIRM WITH THE OFFICIAL "ELECTRONIC RECORD" DOCUMENT IN THE GLOBAL ENGINEERING CONTENT MANAGEMENT SYSTEM.

RTLG-00-K215-00315-1_LP1Y-MP-00090501.pdf

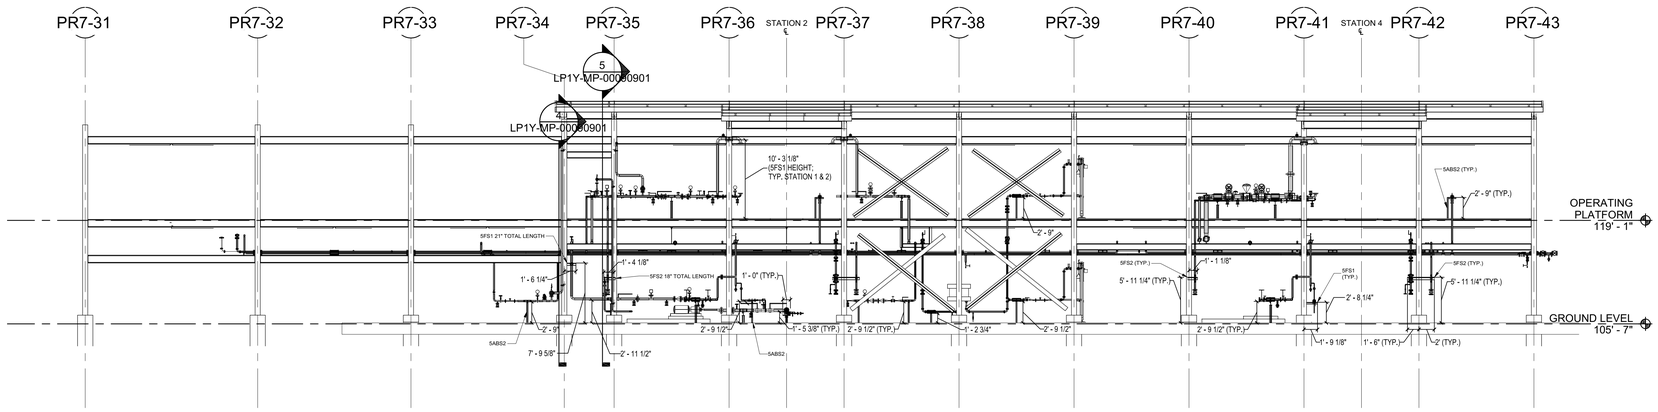

1 PIPE RACK ELEVATION LOOKING WEST (STATION 2 & 4)

SCALE: 1/8" = 1'-0" 0 4' 8' 16'

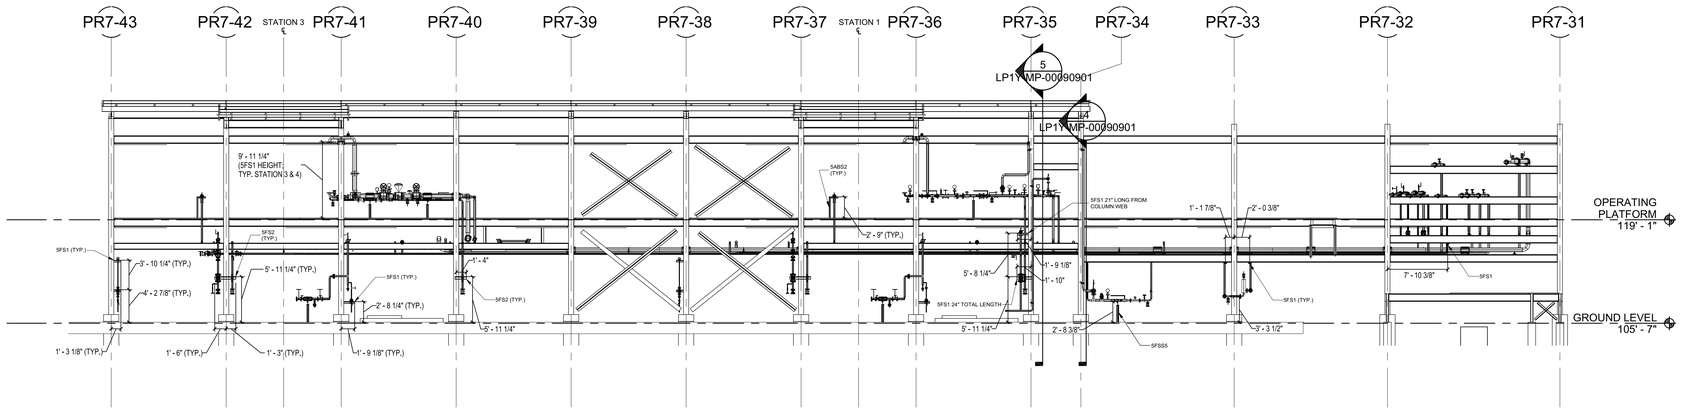


2 PIPE RACK ELEVATION LOOKING EAST (STATION 1 & 3)

SCALE: 1/8" = 1'-0" 0 4' 8' 16'

A1 - DATA COMPLETE - NO COMMENTS - DO NOT RESUBMIT

Authorization to proceed does not relieve Contractor/Supplier of its responsibility or liability under the Contract and or Purchase Order.

By: Ricardo DaCosta dac54131 April 20, 2026

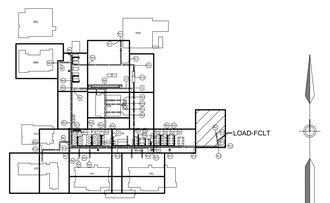

SITE - KEYPLAN

REV	ZONE	PROJECT NUMBER / DESCRIPTION	CHANGE CONTROL	DATE
A	ALL	ISSUE FOR REVIEW	NA	10-APR-26

REVISIONS

CONFIDENTIAL INFORMATION

THIS DRAWING AND THE IDEAS AND DESIGNS SHOWN THEREON ARE THE EXCLUSIVE PROPERTY OF ELI LILLY AND COMPANY AND ARE NOT TO BE USED, REPRODUCED OR DISCLOSED, EITHER IN WHOLE OR IN PART, WITHOUT THE WRITTEN CONSENT OF ELI LILLY AND COMPANY.

HANSON™
HANSON PROFESSIONAL SERVICES, INC.
www.hanson-inc.com
Offices Nationwide
11931 Wickchester Lane, Suite 370
Houston, TX 77043
(346) 297-1720

REV	DATE	DES	ENG	CHK	APP	PM APP
A	10-APR-26	DRW MDW	DQR MDW			6S

Lilly

MECHANICAL PIPING ELEVATIONS

RAIL UNLOADING RACK


SYSTEM TYPE: NA			EDIFICE/BUILDING: Y	LEVEL/FLOOR: 0
SUB DISCIPLINE:	LOCATION CODE: LP1	LOCATION/GRID: COL C-D / 33-43	CCI CODE: YELLOW	PROJECT NAME: LP1-306-1181
CRITICAL QUALITY:		ENTERPRISE GROUP: API	DRAWING INTENTION	DRAWING SCALE: 1/8" = 1'-0"
CRITICAL BUSINESS:		EQUIPMENT CLASSIFICATION: NA	ALTERNATE DOCUMENT ID: NA	MERIDIAN REV
CRITICAL HSE:		VENDOR: NA	DOCUMENT ID: LP1Y-MP-00090501	
NON-CRITICAL:		ENGINEERING AGENCY DOC ID: NA		

IF YOU ARE USING A PRINTED COPY OF THIS DOCUMENT, IT IS AN UNCONTROLLED PRINT. CONFIRM WITH THE OFFICIAL "ELECTRONIC RECORD" DOCUMENT IN THE GLOBAL ENGINEERING CONTENT MANAGEMENT SYSTEM.


4/8/2026 4:31:20 PM Autodesk Docs://2500007 - Hanson-Fluor Lilly/LP1Y-TFS-ED-000-000-00-HNS.rvt

IF YOU ARE USING A PRINTED COPY OF THIS DOCUMENT, IT IS AN UNCONTROLLED PRINT. CONFIRM WITH THE OFFICIAL "ELECTRONIC RECORD" DOCUMENT IN THE GLOBAL ENGINEERING CONTENT MANAGEMENT SYSTEM.


RTLG-00-K215-00316-1_LP1Y-MP-00090901.pdf

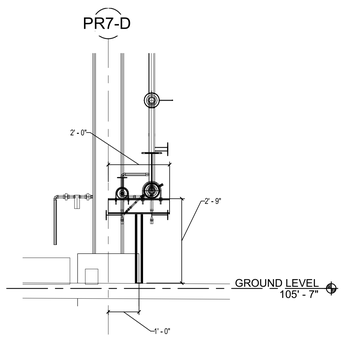


1 STEAM BASE SUPPORT (TYP.)
SCALE: 1/2" = 1'-0"

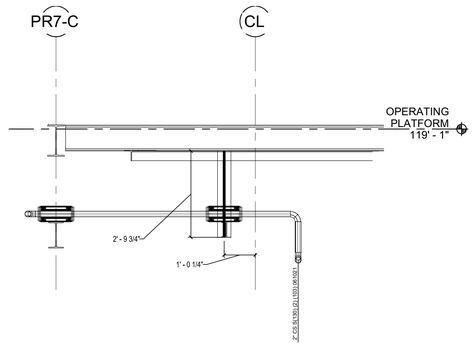


2 EXPANSION LOOP TRAPEZE SUPPORT
SCALE: 1/2" = 1'-0"

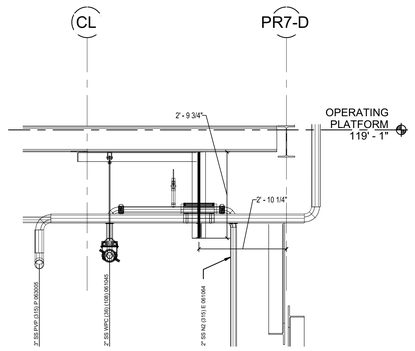


3 MULTI-LINE TRAPEZE SUPPORT
SCALE: 1/2" = 1'-0"

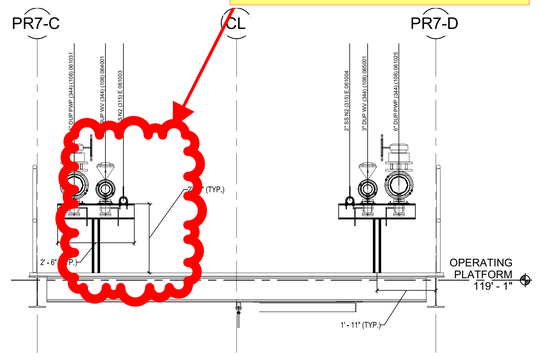


6 WASTE BASE SUPPORTS
SCALE: 1/2" = 1'-0"

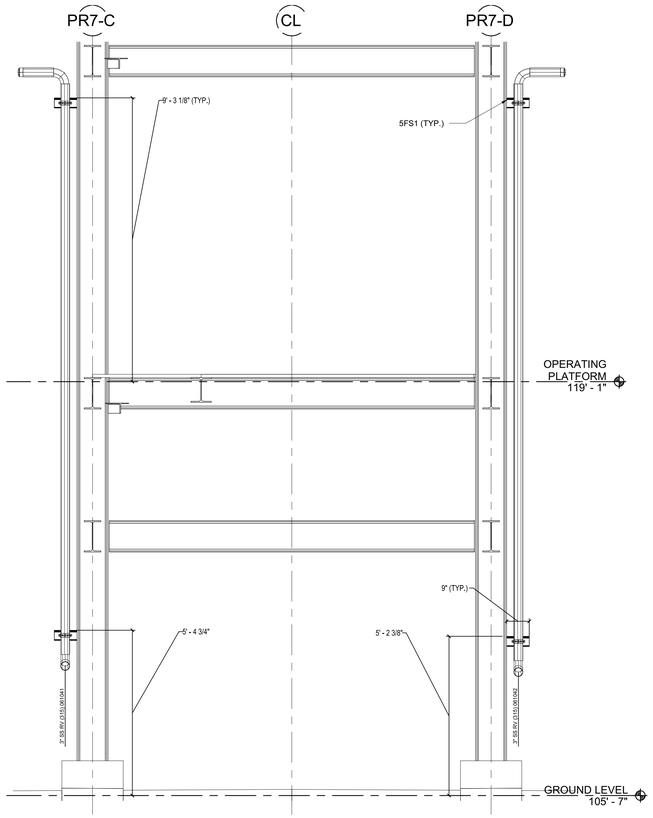


4 RELIEF VENT SUPPORTS
SCALE: 1/2" = 1'-0"

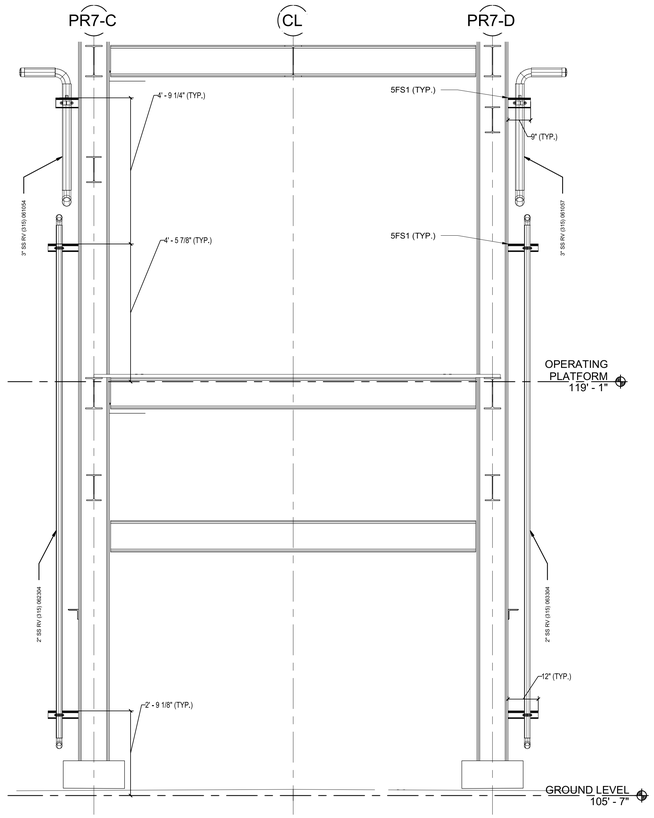

5 RELIEF VENT SUPPORTS CONT.
SCALE: 1/2" = 1'-0"

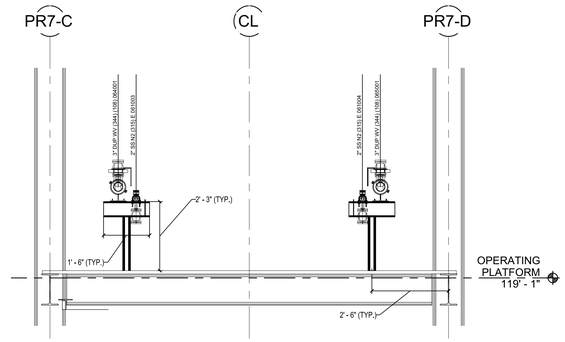

7 WASTE BASE SUPPORTS CONT.
SCALE: 1/2" = 1'-0"

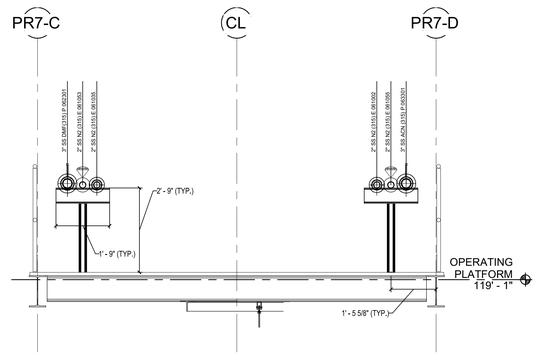

8 PRODUCT BASE SUPPORTS
SCALE: 1/2" = 1'-0"


NO COMMENT

REVIEWED
By:,sau76490,April 20, 2026

B1 - DATA COMPLETE - WITH COMMENTS - PROCEED - RESUBMIT

Authorization to proceed does not relieve Contractor/Supplier of its responsibility or liability under the Contract and or Purchase Order.

By: Ricardo DaCosta dac54131 April 20, 2026

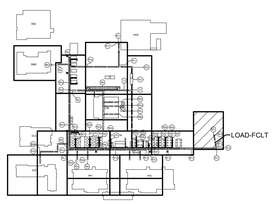

SITE - KEYPLAN

HANSON™
HANSON PROFESSIONAL SERVICES, INC.
www.hanson-inc.com
Offices Nationwide
11931 Wickchester Lane, Suite 370
Houston, TX 77043
(346) 297-1720

REV	DATE	DES	ENG	CHK	APP	PM APP
10-APR-26/DRW	MDW	DOR	MDW		SS	

Lilly

MECHANICAL PIPING SECTIONS

RAIL UNLOADING RACK

REV	ZONE	PROJECT NUMBER / DESCRIPTION	CHANGE CONTROL	DATE
ALL		ISSUE FOR REVIEW	NA	10-APR-26

REVISIONS

CONFIDENTIAL INFORMATION

THIS DRAWING AND THE IDEAS AND DESIGNS SHOWN THEREON ARE THE EXCLUSIVE PROPERTY OF ELI LILLY AND COMPANY AND ARE NOT TO BE USED, REPRODUCED OR DISCLOSED, EITHER IN WHOLE OR IN PART, WITHOUT THE WRITTEN CONSENT OF ELI LILLY AND COMPANY.

SYSTEM TYPE: NA		EDIFICE/BUILDING: Y	LEVEL/FLOOR: 0
SUB DISCIPLINE: LP1	LOCATION CODE: COL	LOCATION/GRID: COL C-D / 33-43	CCI CODE: YELLOW	PROJECT NAME: LP1-306-1181
CRITICAL QUALITY		ENTERPRISE GROUP: API	DRAWING INTENTION	DRAWING SCALE: 1/2" = 1'-0"
CRITICAL BUSINESS		EQUIPMENT CLASSIFICATION: NA	ALTERNATE DOCUMENT ID: NA	MERIDIAN REV
CRITICAL HSE		VENDOR: NA	DOCUMENT ID: LP1Y-MP-00090901	
NON-CRITICAL		ENGINEERING AGENCY DOC ID: NA		

IF YOU ARE USING A PRINTED COPY OF THIS DOCUMENT, IT IS AN UNCONTROLLED PRINT. CONFIRM WITH THE OFFICIAL "ELECTRONIC RECORD" DOCUMENT IN THE GLOBAL ENGINEERING CONTENT MANAGEMENT SYSTEM.

4/8/2026 2:59:44 PM Autodesk Docs://290007 - Hanson-Fluor Lilly/LP1Y-ITFS-E0-000-000-00-HNS.rvt

IF YOU ARE USING A PRINTED COPY OF THIS DOCUMENT, IT IS AN UNCONTROLLED PRINT. CONFIRM WITH THE OFFICIAL "ELECTRONIC RECORD" DOCUMENT IN THE GLOBAL ENGINEERING CONTENT MANAGEMENT SYSTEM.

ABBREVIATIONS

ABBREVIATION	DESCRIPTION
AB	ANCHOR BOLT
ABV	ABOVE
ACC	ACCESS
ACI	AMERICAN CONCRETE INSTITUTE
ADDL	ADDITIONAL
ADJ	ADJACENT
AE	ARCHITECT ENGINEER
AFF	ABOVE FINISH FLOOR
AGG	AGGREGATE
AHU	AIR HANDLING UNIT
AISC	AMERICAN INSTITUTE OF STEEL CONSTRUCTION
ALT	ALTERNATE
ANCH	ANCHOR
ANSI	AMERICAN NATIONAL STANDARDS INSTITUTE
APPROX	APPROXIMATE (LY)
ARCH	ARCHITECT (URAL)
ASCE	AMERICAN SOCIETY OF CIVIL ENGINEERS
ASTM	AMERICAN SOCIETY FOR TESTING AND MATERIALS
AWS	AMERICAN WELDING SOCIETY
B/B	BACK TO BACK
BC	BOTTOM CHORD, BOLT CIRCLE
BEL	BELOW
BET	BETWEEN
BEV	BEVELED
BLDG	BUILDING
BLK	BLOCK
BM	BEAM
B/FTG	BOTTOM OF FOOTING
BOT	BOTTOM
B/	BOTTOM OF
B PL	BASE PLATE
BRCG	BRACING
BRG	BEARING
BS	BOTH SIDES
BSMT	BASEMENT
C	CHANNEL
CB	CATCH BASIN
C/C	CENTER TO CENTER
CF	CUBIC FOOT
CG	CENTER OF GRAVITY
CHAM	CHAMFER
CHKD	CHECKERED
CHKD PL	CHECKERED PLATE
CIP	CAST IN PLACE
CIRC	CIRCUMFERENCE, CIRCUMFERENTIAL
CJ	CONTROL JOINT
CL	CENTER LINE
CLR	CLEAR (ANCE)
CMP	CORRUGATED METAL PIPE
CMU	CONCRETE MASONRY UNIT
COL	COLUMN
COMP	COMPRESSION, COMPRESSIVE
CONC	CONCRETE
CONN	CONNECT (ION), (ED), (ING)
CONST	CONSTRUCT (ION), (ED)
CONT	CONTINUE, CONTINUOUS
CONTR	CONTRACTOR
COORD	COORDINATE (S)
CRSI	CONCRETE REINFORCING STEEL INSTITUTE
CTR	CENTER
CU	CUBIC
CY	CUBIC YARD
D	DEPTH, DEEP
DB	DIAGONAL BRACE
DBL	DOUBLE
DEFL	DEFLECTION
DEG	DEGREE (S)
DEL	DELETE (D)
DEMO	DEMOLISH, DEMOLITION
DET	DETAIL
DIA	DIAMETER
DIAG	DIAGONAL
DIM	DIMENSION (ED)
DISCH	DISCHARGE
DIST	DISTANCE
DL	DEAD LOAD
DN	DOWN
DR	DRAIN
DO	DITTO
DTI	DIRECT TENSION INDICATOR
DWG	DRAWING
DWL	DOWEL (ED)
E	EAST, MODULUS OF ELASTICITY, ANCHOR BOLT EMBEDMENT
EA	EACH
EF	EACH FACE
EJ	EXPANSION JOINT
EL	ELEVATION (HEIGHT)
ELEC	ELECTRICAL
ELEV	ELEVATION (VIEW)
EMB	EMBED, EMBEDDED, EMBEDMENT
ENCL	ENCLOSURE, ENCLOSED
ENGR	ENGINEER (ING)
EOD	EDGE OF DECK
EOP	EDGE OF PLATE
EOR	ENGINEER OF RECORD
EOS	EDGE OF SLAB
EQ	EQUAL
EQUIP	EQUIPMENT
EST	ESTIMATE (D)
EW	EACH WAY
E/W	EAST/WEST
EXB	EXPANSION BOLT
EXIST OR (E)	EXISTING
EXP	EXPANSION
EXT	EXTERNAL, EXTERIOR

ABBREVIATION	DESCRIPTION
FAB	FABRICATOR, FABRICATE
FB	FLAT BAR
FD	FLOOR DRAIN
FDN	FOUNDATION
FF	FINISH FLOOR
FIN	FINISH (ED)
FLG	FLANGE
FLR	FLOOR (ING)
F/	FACE OF
F/C	FACE OF CONCRETE
FP	FIREPROOF (ED), (ING)
FRM	FRAME (D), (ING)
FRMG	FRAMING
FS	FAR SIDE
FT	FOOT, FEET
FTG	FOOTING
FUT	FUTURE
FY	YIELD STRESS
GA	GAUGE, GAGE
GALV	GALVANIZED
GB	GRADE BEAM
GC	GENERAL CONTRACTOR
GL	GIRT LINE
GR	GUARDRAIL
GRTG	GRATING
HB	HORIZONTAL BRACING
HD	HUB DRAIN
HEX	HEXAGONAL
HEX HD	HEX HEAD
HGR	HANGER
HLS	HOLES
HORIZ	HORIZONTAL
HP	HIGH POINT
HR	HANDRAIL
HS	HIGH STRENGTH
HSA	HEADED STUD ANCHOR
HSB	HIGH STRENGTH BOLT
HSS	HOLLOW STRUCTURAL SECTION
HT	HEIGHT
HVAC	HEATING/VENTILATING/AIR CONDITIONING
IBC	INTERNATIONAL BUILDING CODE
ID	INSIDE DIAMETER
IE	INVERT ELEVATION
IN	INCH (ES)
INCL	INCLUDE (D), INCLUSIVE
INFO	INFORMATION
INT	INTERIOR, INTERMEDIATE
INV	INVERT
JF	JOINT FILLER
JST	JOIST
JT	JOINT
K	KIP (S)
KB	KNEE BRACE
KPL	KICKPLATE
KSF	KIPS PER SQUARE FOOT
KSI	KIPS PER SQUARE INCH
L	ANGLE, LENGTH
LAB	LABORATORY
LAD	LADDER
LB	POUNDS
Ld	DEVELOPMENT LENGTH
LDG	LANDING
LG	LONG
LGTH	LENGTH
LL	LIVE LOAD
LIN	LINEAR
LLH	LONG LEG HORIZONTAL
LLV	LONG LEG VERTICAL
LF	LINEAR FOOT
LP	LOW POINT
LRFD	LOAD & RESISTANCE FACTOR DESIGN
LVL	LEVEL (ING)
M	MOMENT
MANUF	MANUFACTURER (ING), ('S)
MATL	MATERIAL (S)
MAX	MAXIMUM
MB	MACHINE BOLT
MC	MOMENT CONNECTION, MISCELLANEOUS CHANNEL
MECH	MECHANICAL
MEM	MEMBER
MFR	MANUFACTURE (R), (ED)
MEZZ	MEZZANINE
MH	MAN HOLE
MID	MID, MIDDLE
MIN	MINIMUM, MINUTE
MISC	MISCELLANEOUS
MOD	MODULE
MONO	MONORAIL
MPS	MISCELLANEOUS PIPE SUPPORTS
MSL	MEAN SEA LEVEL
N	NORTH
(N)	NEW
NF	NEAR FACE
NIC	NOT IN CONTRACT
NO	NUMBER
NOM	NOMINAL
NS	NEAR SIDE
N/S	NORTH/SOUTH
NTS	NOT TO SCALE

ABBREVIATION	DESCRIPTION
OA	OVERALL
OC	ON CENTER (S)
OD	OUTSIDE DIAMETER
OF	OUTSIDE FACE
OH	OVERHEAD
O/O	OUT TO OUT
OPNG	OPENING
OPP	OPPOSITE
OPP HD	OPPOSITE HAND
OSL	OUTSTANDING LEG
OSHA	OCCUPATIONAL SAFETY & HEALTH ADMINISTRATION
P OR PROJ	PROJECTION
PAR	PARALLEL
PC	PIECE
PCA	PORTLAND CEMENT ASSOCIATION
PCF	POUNDS PER CUBIC FOOT
PCI	POUNDS PER CUBIC INCH
PCS	PIECES
PERIM	PERIMETER
PL	PLATE
PLATF	PLATFORM
PLCS	PLACES
PLF	POUNDS PER LINEAR FOOT
PR	PAIR
PS	PIPE SUPPORT
PSF	POUNDS PER SQUARE FOOT
PSI	POUNDS PER SQUARE INCH
PT	POINT
PVC	POLYVINYL CHLORIDE
PVMT	PAVEMENT
QTY	QUANTITY
R	RISER
RAD	RADIUS, RADIAL (LY)
RD	ROOF DRAIN
RECT	RECTANGULAR
REF	REFERENCE
REINF	REINFORCE (D), (ING), (MENT)
REM	REMOVE (ABLE)
REQD	REQUIRED
REV	REVISE, REVISION, REVISED
RM	ROOM
RO	ROUGH OPENING
S	SOUTH
SC	SLIP CRITICAL
SCHD	SCHEDULE (D)
SDI	STEEL DECK INSTITUTE
SECT	SECTION
SF	SQUARE FOOT, SQUARE FEET
SFRS	SEISMIC FORCE RESISTING SYSTEM
SHT	SHEET
SI	SQUARE INCH
SIM	SIMILAR
SL	SLOPE
SLRS	SEISMIC LOAD RESISTING SYSTEM
SLV	SLEEVE
SOG	SLAB ON GRADE
SP	SPACE, SPACING
SPEC	SPECIFICATION
SPL	SPLICE (S)
SPS	SPECIAL PIPE SUPPORT
SQ	SQUARE
SS	STAINLESS STEEL
STD	STANDARD
STIFF	STIFFENER (S)
STL	STEEL
STAG	STAGGERED
STR	STRUCTURE
STRU	STRUCTURAL
SUPT	SUPPORT
SUSP	SUSPENDED
SYM	SYMMETRY, SYMMETRICAL
T	TREAD
T&B	TOP AND BOTTOM
TC	TOP CHORD
TEMP	TEMPORARY, TEMPERATURE
TF	TRANSFER FORCE
THD	THREAD (ED)
THK	THICK (NESS)
THRU	THROUGH
TL	TOTAL LOAD
T/C	TOP OF CONCRETE
T/G	TOP OF GROUT OR GRATING
T/	TOP OF
T/STL	TOP OF STEEL
TYP	TYPICAL
UL	UNDERWRITERS LABORATORIES
UNC	UNIFIED NATIONAL COARSE
UNO	UNLESS NOTED OTHERWISE
V	SHEAR FORCE, VELOCITY
VB	VAPOR BARRIER, VERTICAL BRACING
VERT	VERTICAL
W	WIDTH, WIDE, WEST, WIDE FLANGE
W/	WITH
WL	WIND LOAD
W/O	WITHOUT
WP	WORK POINT
WS	WATER STOP
WT	WEIGHT
W/W	WALL TO WALL
WWF	WELDED WIRE FABRIC/REINFORCING

GENERAL NOTES

1. STRUCTURAL CONSTRUCTION DOCUMENTS SHALL BE USED WITH OTHER CONSTRUCTION DOCUMENTS INCLUDING, M/E/P AND SITE DOCUMENTS. COORDINATE WITH THESE DOCUMENTS FOR LOCATIONS AND DIMENSIONS OF OPENINGS, CHASES, INSERTS, REGLETS, SLEEVES, DEPRESSIONS, ETC. NOT INDICATED ON THE STRUCTURAL DOCUMENTS. ALL DIMENSIONS AND CONDITIONS, EXISTING AND NEW, SHALL BE FIELD VERIFIED. DIMENSIONS AND NOTES SUPERCEDE SCALE REFERENCES. THE ENGINEER OF RECORD SHALL BE NOTIFIED OF DISCREPANCIES PRIOR TO PROCEEDING WITH THE AFFECTED PORTION OF THE WORK.
2. DIMENSIONS SHOWN TO EXISTING CONSTRUCTION ARE PLUS OR MINUS REGARDLESS OF WHETHER SHOWN AS PLUS OR MINUS ON THE DRAWING. THE CONTRACTOR SHALL VERIFY THAT ALL DIMENSIONS AND EXISTING CONDITIONS ARE AS SHOWN ON THE DRAWING BEFORE STARTING CONSTRUCTION AND/OR FABRICATION. ANY DEVIATION IN DIMENSIONS AND/OR ELEVATIONS FROM THE CONTRACT DRAWINGS SHALL BE BROUGHT TO THE IMMEDIATE ATTENTION OF THE ENGINEER OF RECORD FOR REVIEW AND APPROVAL PRIOR TO PROCEEDING.
3. CONTRACTOR TO INVESTIGATE ACTUAL LOCATIONS OF UNDERGROUND LINES AND UTILITIES BEFORE EXCAVATION AND ANY LINES ENCOUNTERED WITHIN OR IN THE VICINITY OF THE NEW FOUNDATION TO BE INFORMED TO THE CONSTRUCTION MANAGER IMMEDIATELY.
4. ALL FOUNDATIONS AND STRUCTURES ARE DESIGNED FOR IN-PLACE LOADS, THE CONTRACTOR SHALL TAKE ALL NECESSARY PRECAUTIONS AND PROVIDE ADEQUATE TEMPORARY SHORING AND BRACING DURING CONSTRUCTION AND EQUIPMENT ERECTION PHASES SO AS NOT TO UNDERMINE EXISTING FOUNDATIONS.
5. DURING CONSTRUCTION, TEMPORARY ERECTION BRACING, SHORING AND/OR SUPPORTS MUST BE PROVIDED AS REQUIRED TO ENSURE STRUCTURAL STABILITY UNTIL ALL DECK AND LATERAL FORCE RESISTING ELEMENTS AND CONNECTIONS ARE INSTALLED.
6. THE CONTRACTOR IS RESPONSIBLE FOR LIMITING THE AMOUNT OF CONSTRUCTION LOAD IMPOSED ON THE STRUCTURE. CONSTRUCTION LOADS SHALL NOT EXCEED THE SPECIFIED DESIGN LIVE LOADS. CONCRETE SLABS AND TOPPINGS SHALL NOT BE LOADED UNTIL THE CONCRETE HAS REACHED AT LEAST 75% OF THE SPECIFIED DESIGN COMPRESSIVE STRENGTH.
7. THE CONTRACTOR'S CONSTRUCTION SEQUENCES SHALL ALLOW FOR THE EFFECTS OF THERMAL MOVEMENTS DURING THE CONSTRUCTION PERIODS PRIOR TO THE BUILDING BEING ENCLOSED AND TEMPERATURE CONTROLLED. NEGATIVE EFFECTS OF SUCH THERMAL MOVEMENTS SUCH AS MATERIAL CRACKING, FROST HEAVE, ETC. SHALL BE CORRECTED BY THE CONTRACTOR AT NO ADDITIONAL COST TO THE OWNER.
8. APPLICABLE FEDERAL, STATE AND MUNICIPAL REGULATIONS SHALL BE FOLLOWED, INCLUDING THE UNITED STATES DEPARTMENT OF LABOR OCCUPATIONAL SAFETY AND HEALTH ADMINISTRATION (OSHA).
9. SEE CIVIL DRAWING LP100-CS-90000001 FOR PROJECT COORDINATE AND PROJECT ELEVATION SYSTEM ORIGIN AND CONVERSION METHODOLOGY FROM DATUM (NAVD88). PROJECT DATUM 100'-0" = 926.80'.
10. SPECIAL INSPECTIONS SHALL BE PERFORMED AS REQUIRED BY THE ENGINEER ON RECORD. FOR SPECIAL INSPECTION CRITERIA REFER TO DRAWINGS LP1Y-SF-0009P004 THRU LP1Y-SF-0009P006.

DESIGN CRITERIA NOTES

D1. BUILDING CODE AND STANDARDS

2014 INDIANA BUILDING CODE
2012 INTERNATIONAL BUILDING CODE (IBC) WITH AMENDMENTS AND INDIANA BUILDING CODE 2014 AMENDMENTS
ASCE STANDARD 7-10 MINIMUM DESIGN LOADS FOR BUILDINGS AND OTHER STRUCTURES
AISC STEEL MANUAL, 14TH EDITION
ACI 318-11 BUILDING CODE REQUIREMENTS FOR STRUCTURAL CONCRETE

D2. REFER TO "STRUCTURE DESIGN CRITERIA TABLE" FOR LOADS AND RELATED PARAMETERS


D3. FOUNDATION DESIGN

1. THE FOLLOWING DESIGN CRITERIA ARE BASED ON THE SOIL DATA AND RECOMMENDATIONS LISTED IN "REPORT OF GEOTECHNICAL EXPLORATION, LEBANON PLANT 1 (LP1) PROJECT, TANK FARM AND PIPE RACKS " BY S&ME, DATED JANUARY 2, 2024
2. NET ALLOWABLE SOIL BEARING PRESSURE: 2500 PSF AT LIGHTLY LOADED SHALLOW FOOTINGS
3. MINIMUM DEPTH OF FOUNDATION BELOW GRADE = 3'-0" (PROTECTION AGAINST MOISTURE FLUCTUATION)
4. GROUND WATER TABLE VARIES WIDELY ACROSS THE SITE. REFER TO THE APPROPRIATE ASSOCIATED GEOTECHNICAL REPORT PREPARED BY S&ME, AS LISTED ABOVE, FOR GROUND WATER TABLE. FROST LINE ELEVATION WILL VARY BASED ON FINISHED GRADING ELEVATION.

1

D4. DEFERRED SUBMITTALS:

1. METAL ROOF SYSTEMS - STRUCTURAL CALCULATIONS AND SHOP DRAWINGS SHALL BE STAMPED AND SEALED BY A LICENSED ENGINEER IN THE STATE OF INDIANA AND SHALL BE SUBMITTED TO THE ENGINEER OF RECORD FOR REVIEW AND COORDINATION PRIOR TO FABRICATION.
2. STEEL CONNECTION DESIGN AND DETAILING - SHOP DRAWINGS SHALL BE SUBMITTED TO THE ENGINEER OF RECORD FOR REVIEW AND COORDINATION PRIOR TO FABRICATION.

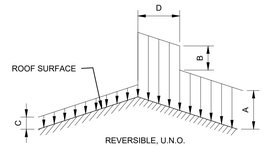

LOCATION	A (PSF)	B (PSF)	C (PSF)	D (FT)
FULL WIDTH CANOPY AT GANGWAYS	18.1	6.6	5.4	12.1
CANOPY AT ALL OTHER BAYS	24.1	N/A	5.4	N/A


UNBALANCED SNOW LOAD DIAGRAM
6

STRUCTURE DESIGN CRITERIA TABLE

BUILDING NUMBER	LP1Y
BUILDING NAME	RAIL UNLOADING RACK
STEEL DESIGN PHILOSOPHY:	LRFD
RISK CATEGORY	IV
DEAD LOAD:	
PLATFORM GRATING	10 psf
MISC MEP LOADS	15 psf
GUARDRAIL W/ TOE PLATE	15 lbs/ft
LADDER W/O CAGE	11 lbs/ft
PIPING/CABLE TRAYS	40 psf
SMALL PIPING	20 psf
METAL ROOF	3 psf
GANGWAY	1000 lbs
STAIRS	15 psf
LIVE LOAD	
PLATFORM LIVE LOAD	150 psf
GANGWAY LIVE LOAD	500 lbs
STAIR LIVE LOAD	100 psf
HANDRAIL LIVE LOAD	50 plf
ROOF LIVE LOAD	40 psf
MIN. ROOF LIVE LOAD	20 psf
SNOW LOAD	
GROUND SNOW LOAD, Pg	20 psf
FLAT ROOF LOAD, Pf	18.1 psf
EXPOSURE FACTOR, Ce	0.9
SNOW IMPORTANCE FACTOR, Is	1.2
THERMAL FACTOR, Ct	1.2
RAIN ON SNOW SURCHARGE	N/A
ICE LOAD	
ICE THICKNESS	1 inches
CONCURRENT TEMP.	55 °F
GUST SPEED	40 mph
IMPORTANCE FACTOR	1.25
THERMAL EXPANSION/CONTRACTION EFFECTS	
ΔT	100 °F
WIND LOAD	
BASIC WIND SPEED, V	120 mph
EXPOSURE CATEGORY	C
BUILDING ENCLOSURE	OPEN
WIND DIRECTIONALITY FACTOR, Kd	0.85
TOPOGRAPHIC FACTOR, Kzt	1.0
GUST EFFECT FACTOR, G	0.85
INTERNAL PRESSURE COEFFICIENT, GCpi	±0.0
WIND BASE SHEAR, E-W DIRECTION*	25 KIPS HORIZ 32 KIPS VERT. (DOWNWARD)
WIND BASE SHEAR, N-S DIRECTION**	41 KIPS HORIZ 34 KIPS VERT. (UPLIFT)
SEISMIC LOAD	
SEISMIC IMPORTANCE FACTOR, IE	1.5
SITE CLASS	C
SITE SPECIFIC RESPONSE ACCELERATION, Ss	0.151
SITE SPECIFIC RESPONSE ACCELERATION, S1	0.083
SPECTRAL RESPONSE ACCELERATION, Sds	0.121
SPECTRAL RESPONSE ACCELERATION, Sd1	0.094
SEISMIC DESIGN CATEGORY	C
LONG PERIOD TRANSITION PERIOD, TL	12 SEC
SEISMIC FORCE RESISTING SYSTEM (SFRS), E-W DIRECTION*	MOMENT FRAME***
SEISMIC FORCE RESISTING SYSTEM (SFRS), N-S DIRECTION**	BRACED FRAME***
RESPONSE MODIFICATION COEFFICIENT, E-W DIRECTION*, R	3
RESPONSE MODIFICATION COEFFICIENT, N-S DIRECTION**, R	3
SEISMIC RESPONSE COEFFICIENT, E-W DIRECTION*, Cs	0.0604
SEISMIC RESPONSE COEFFICIENT, N-S DIRECTION**, Cs	0.0604
SEISMIC BASE SHEAR, E-W DIRECTION**	20.3 KIPS
SEISMIC BASE SHEAR, N-S DIRECTION**	20.3 KIPS
ANALYSIS PROCEDURE USED	ELF****

*E-W DIRECTION IS TRANSVERSE TO RACK LENGTH.
**N-S DIRECTION IS LONGITUDINAL TO RACK LENGTH.
***STEEL SYSTEMS NOT SPECIFICALLY DETAILED FOR SEISMIC RESISTANCE.
****EQUIVALENT LATERAL FORCE PROCEDURE

Sheet List		
Sheet Number	Sheet Name	Sheet Issue Date
cLP1Y-SF-0009P257	FOUNDATION JOINT PLAN	07-JAN-2026
cLP1Y-SF-0009P950	FOUNDATION DETAILS	20-FEB-2026
LP1Y-SF-0009P001	STRUCTURAL DESIGN CRITERIA AND GENERAL NOTES	20-FEB-2026
LP1Y-SF-0009P002	STRUCTURAL STEEL NOTES	20-FEB-2026
LP1Y-SF-0009P003	STRUCTURAL CONC CRITERIA AND REINF DETAILS	20-FEB-2026
LP1Y-SF-0009P004	STRUCTURAL SPECIAL INSPECTION SHEET	20-FEB-2026
LP1Y-SF-0009P005	STRUCTURAL SPECIAL INSPECTION SHEET	20-FEB-2026
LP1Y-SF-0009P006	STRUCTURAL SPECIAL INSPECTION SHEET	20-FEB-2026
LP1Y-SF-0009P250	GENERAL ARRANGEMENT PLAN	20-FEB-2026
LP1Y-SF-0009P251	FOUNDATION PLAN	20-FEB-2026
LP1Y-SF-0009P252	PIPE SUPPORT FRAMING PLAN	20-FEB-2026
LP1Y-SF-0009P253	PLATFORM FRAMING PLAN	20-FEB-2026
LP1Y-SF-0009P254	CABLE TRAY SUPPORT FRAMING PLAN	20-FEB-2026
LP1Y-SF-0009P255	ROOF FRAMING PLAN	20-FEB-2026
LP1Y-SF-0009P256	STAIR PLAN	20-FEB-2026
LP1Y-SF-0009P900	UNLOADING RACK SECTIONS	20-FEB-2026
LP1Y-SF-0009P901	UNLOADING RACK SECTIONS	20-FEB-2026
LP1Y-SF-0009P902	GUARDRAIL AND LADDER SECTIONS	20-FEB-2026
LP1Y-SF-0009P951	FOUNDATION DETAILS	20-FEB-2026
LP1Y-SF-0009P953	STRUCTURAL STEEL FRAMING AND BRACE DETAILS	20-FEB-2026
LP1Y-SF-0009P955	STRUCTURAL GRATING DETAILS	20-FEB-2026
LP1Y-SF-0009P956	STRUCTURAL STAIR AND HANDRAIL DETAILS	20-FEB-2026
LP1Y-SF-0009P957	STRUCTURAL GUARDRAIL DETAILS	20-FEB-2026
LP1Y-SF-0009P958	STRUCTURAL LADDER DETAILS	20-FEB-2026

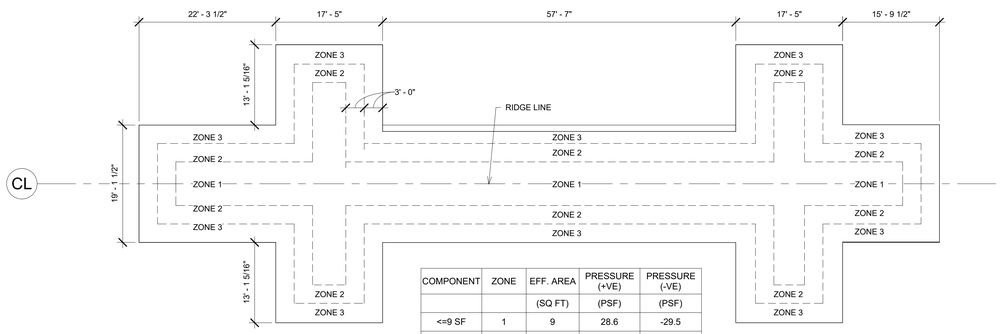

COMPONENT	ZONE	EFF. AREA (SQ FT)	PRESSURE (+VE) (PSF)	PRESSURE (-VE) (PSF)
<=9 SF	1	9	28.6	-29.5
18 SF	1	18	28.6	-29.5
>36 SF	1	36.1	28.6	-29.5
<=9 SF	2	9	43.8	-44.6
18 SF	2	18	43.8	-44.6
>36 SF	2	36.1	28.6	-29.5
<=9 SF	3	9	57.2	-88.4
18 SF	3	18	43.8	-44.6
>36 SF	3	36.1	28.6	-29.5

COMPONENTS AND CLADDING WIND LOADS
5

RYNE M. FIORITO
REGISTERED
PE12100177
STATE OF INDIANA
PROFESSIONAL ENGINEER

A1- DATA COMPLETE - NO COMMENTS - DO NOT RESUBMIT
Authorization to proceed does not relieve Contractor/Supplier of its responsibility or liability under the Contract and or Purchase Order.
By dac54131 at Apr 06, 2026

HANSON PROFESSIONAL SERVICES, INC.
www.hanson-inc.com
Offices Nationwide
11931 Wickchester Lane, Suite 370
Houston, TX 77043
(346) 297-1720

REV	DATE	DES	ENG	CHK	APP	PM APP
3	03-APR-2026	RKN	SJS	FCB	RMF	SS
2	20-FEB-2026	RKN	SJS	FCB	RMF	SS
1	07-JAN-2026	RKN	SJS	FCB	FCB	SS
B	14-NOV-2025	RKN	SJS	FCB	FCB	SS
A	10-OCT-2025	RKN	SJS	FCB	RMF	SS

Lilly

STRUCTURAL DESIGN CRITERIA AND GENERAL NOTES

RAIL UNLOADING RACK

REV	ZONE	PROJECT NUMBER / DESCRIPTION	CHANGE CONTROL	DATE
1		ISSUED FOR CONSTRUCTION		03-APR-2026
0		ISSUED FOR CONSTRUCTION		20-FEB-2026
C		ISSUED FOR REVIEW		07-JAN-2026
B		ISSUED FOR REVIEW		14-NOV-2025
A		ISSUED FOR REVIEW		10-OCT-2025

REVISIONS

CONFIDENTIAL INFORMATION
THIS DRAWING AND THE IDEAS AND DESIGNS SHOWN THEREON ARE THE EXCLUSIVE PROPERTY OF ELI LILLY AND COMPANY AND ARE NOT TO BE USED, REPRODUCED OR DISCLOSED, EITHER IN WHOLE OR IN PART, WITHOUT THE WRITTEN CONSENT OF ELI LILLY AND COMPANY.

SYSTEM TYPE: NA		EDIFICE/BUILDING: UNLOADING RACK	LEVEL/FLOOR: NA
SUB DISCIPLINE: SF	LOCATION CODE: LP1	LOCATION/GRID: NA	CCI CODE: YELLOW
CRITICAL QUALITY:		ENTERPRISE GROUP: API	DRAWING INTENTION:
CRITICAL BUSINESS:		EQUIPMENT CLASSIFICATION: NA	ALTERNATE DOCUMENT ID: NA
CRITICAL HSE:		VENDOR: NA	MERIDIAN REV: 1
NON-CRITICAL:		ENGINEERING AGENCY DOC ID: NA	DOCUMENT ID: LP1Y-SF-0009P001

PROJECT NAME: RAIL UNLOADING RACK
DRAWING SCALE: NONE

IF YOU ARE USING A PRINTED COPY OF THIS DOCUMENT, IT IS AN UNCONTROLLED PRINT. CONFIRM WITH THE OFFICIAL "ELECTRONIC RECORD" DOCUMENT IN THE GLOBAL ENGINEERING CONTENT MANAGEMENT SYSTEM.

IF YOU ARE USING A PRINTED COPY OF THIS DOCUMENT, IT IS AN UNCONTROLLED PRINT. CONFIRM WITH THE OFFICIAL "ELECTRONIC RECORD" DOCUMENT IN THE GLOBAL ENGINEERING CONTENT MANAGEMENT SYSTEM.

STRUCTURAL STEEL NOTES

S1. STRUCTURAL STEEL DESIGN, FABRICATION AND ERECTION SHALL BE IN CONFORMANCE WITH THE FOLLOWING CODES AND SPECIFICATIONS, UNLESS NOTED OTHERWISE:

AISC (AMERICAN INSTITUTE OF STEEL CONSTRUCTION) STEEL CONSTRUCTION MANUAL, FOURTEENTH EDITION, 2011 STEEL DESIGN PHILOSOPHY = LRFD. REFER TO STRUCTURE DESIGN CRITERIA TABLE ON LP1Y-SF-0009P001.
AISC 360-10, SPECIFICATION FOR STRUCTURAL STEEL BUILDINGS.
AISC 341-10, SEISMIC PROVISIONS FOR STRUCTURAL STEEL BUILDINGS.
AISC 303 CODE OF STANDARD PRACTICE FOR STEEL BUILDINGS AND BRIDGES.
AISC SPECIFICATION FOR STRUCTURAL STEEL JOINTS USING ASTM A325 OR A490 BOLTS

S2. ALL NEW STRUCTURAL STEEL MATERIAL SHALL CONFORM TO THE FOLLOWING STANDARDS, UNLESS NOTED OTHERWISE. ALL EXISTING STRUCTURAL STEEL MATERIAL SHALL CONFORM TO THE STANDARDS SHOWN ON THE ORIGINAL DESIGN DOCUMENTS.

STRUCTURAL STEEL	
W, WT	ASTM A992, GRADE 50
HP, PLATES, BARS,	ASTM A572, GRADE 50
S, L, ,T, C	ASTM A572, GRADE 50 OR ASTM A992, GRADE 50
STRUCTURAL TUBING	ASTM A500, GRADE C OR ASTM A1085
STRUCTURAL PIPE	ASTM A53, TYPE E OR S, GRADE B OR ASTM A500 GRADE B
ANCHOR BOLTS	ASTM F1554 GRADE 36 UNO
HIGH STRENGTH BOLTS	ASTM F3125: GRADE A325, TYPE 1 OR GRADE A490, TYPE 1; AS REQUIRED BY CONNECTION DESIGN
HIGH STRENGTH NUTS	ASTM A563, GRADE DH, GALV
UNFINISHED BOLTS (MACHINE BOLTS)	ASTM A307, GRADE A
UNFINISHED NUTS	ASTM A563, GRADE A
WELDING ELECTRODES	AWS D1.1, E70XX SERIES
STEEL GRATING BEARING BARS	ASTM A1011
STEEL FLOOR PLATE	ASTM A786 OR A36
DIRECT TENSION INDICATING WASHERS (DTIS)	ASTM F959 VISUAL SELF-INDICATING DTI
HARDENED WASHERS	ASTM F436 (GALV FOR A325 ASSEMBLIES: PLAIN UNCOATED FOR A490 BOLT ASSEMBLIES)
HEADED STUD ANCHORS	ASTM A108 OR A29 OR ASSW TYPE A (Fu = 61 KSI MIN)

S3. ALL A325 STRUCTURAL FASTENERS, WASHERS AND NUTS SHALL BE SUPPLIED ZINC COATED BY MECHANICAL GALVANIZING TO ASTM B695. MECHANICAL GALVANIZED BOLTS SHALL HAVE THE NUTS TAPPED OVERSIZE AFTER GALVANIZING. NUTS MUST BE SUPPLIED LUBRICATED WITH A VISUALLY IDENTIFIABLE WAX TYPE LUBRICANT SUCH AS CASTROL STICK WAX OR APPROVED SUBSTITUTE (REFER TO ASTM A563, SECTION 4.8).

DIRECT TENSION INDICATING WASHERS (DTI'S) SUPPLIED WITH A325 ASSEMBLIES SHALL BE MECHANICALLY GALVANIZED TO A CLASS 50 FINISH.

S4. ALL WELDING SHALL BE IN CONFORMANCE WITH THE AMERICAN WELDING SOCIETY
AWS D1.1 - STRUCTURAL WELDING CODE
AWS D1.8 - SEISMIC WELDING CODE.

S5. SHOP CONNECTIONS SHALL NORMALLY BE WELDED USING ELECTRODES WITH A MINIMUM TENSILE STRENGTH OF 70 KSI. WELDS FOR MOMENT CONNECTIONS AND DEMAND CRITICAL WELDS SHALL UTILIZE FILLER MATERIAL HAVE A NOTCH TOUGHNESS AS NOTED IN S3 PER AWS.

S6. BOLTED CONNECTIONS FOR PRIMARY GRAVITY STRUCTURAL MEMBERS SHALL BE MADE WITH MINIMUM 3/4" DIAMETER HIGH STRENGTH BOLTS CONFORMING TO ASTM A325N IN BEARING TYPE CONNECTIONS WITH THREADS INCLUDED IN THE SHEAR PLANE. THE CONNECTIONS SHALL USE SNUG TIGHTENED BOLTS UNLESS NOTED OTHERWISE. THE ONLY INSPECTION REQUIRED IS THAT THE PLIES OF THE CONNECTION ARE SNUG, UNLESS NOTED OTHERWISE. THE DESIGN AND ASSEMBLY OF HIGH STRENGTH BOLTED CONNECTIONS SHALL BE IN ACCORDANCE WITH AISC SPECIFICATION FOR STRUCTURAL JOINTS USING ASTM A325 OR A490 BOLTS. HIGH STRENGTH BOLTED CONNECTIONS SHALL BE INDICATED CLEARLY ON THE ERECTION DRAWINGS. SINGLE ANGLE BEAM CONNECTIONS AND SINGLE PLATE CONNECTIONS ARE ACCEPTABLE IN LOCATIONS WHERE CONNECTION DESIGN FORCES PERMIT.

S7. CONNECTIONS SHALL BE DESIGNED, OR VERIFIED IN THE CASE OF EXISTING CONNECTIONS, IN ACCORDANCE WITH AISC "SPECIFICATION FOR STRUCTURAL STEEL BUILDINGS" AND TABLES 10-1, 10-2, 10-3, & 10-10 OF THE AISC MANUAL OF STEEL CONSTRUCTION FOR THE LOADS GIVEN ON THE DRAWINGS. IF NO LOADS ARE GIVEN, THE MINIMUM BEAM CONNECTION SHALL BE DETERMINED FROM PART 3 "UNIFORM LOAD CONSTANTS" FOR THE MEMBER SIZE AND SPAN INDICATED. ALL CONNECTIONS THAT ARE NOT DETAILED ON DESIGN DRAWINGS SHALL BE SHOP WELDED AND FIELD BOLTED IN ACCORDANCE WITH TABLES 10-1, 10-2 & 10-3 OF THE AISC MANUAL OF STEEL CONSTRUCTION. ALL CONNECTIONS OF GIRDERS TO COLUMN WEBS SHALL BE DESIGNED AND FABRICATED TO EXTEND BEYOND THE FLANGES OF THE COLUMN. SEE DETAIL 13 / LP1Y-SF-0009P953.

S8. CONNECTIONS THAT ARE PART OF THE LATERAL FORCE RESISTING SYSTEM INCLUDING VERTICAL AND HORIZONTAL BRACE SYSTEMS, BRACE LINE BEAMS ACTING AS A CHORD AND DRAG STRUTS AND MOMENT CONNECTIONS AND WHERE INDICATED ON DRAWINGS SHALL USE PRE-TENSIONED (FULLY TIGHTENED BOLTS). HIGH STRENGTH BOLTS OF MINIMUM 3/4" DIAMETER CONFORMING TO THE REQUIREMENTS OF ASTM A325 SHALL BE USED. THESE BOLTS SHALL BE TENSIONED TO THE VALUES SHOWN IN TABLE J3.1 OF PART 16 OF THE AISC STEEL CONSTRUCTION MANUAL, FOURTEENTH EDITION USING DIRECT TENSION INDICATING DEVICES (ASTM F959 VISUAL SELF-INDICATING DTI, TYPE TO BE SUBMITTED TO EOR FOR REVIEW AND APPROVAL) OR TENSION CONTROL BOLTS (TWIST-OFF-BOLTS). REFER TO STEEL SHOP DRAWINGS FOR SYSTEM USED. CONNECTION MATERIAL SUBJECTED TO TENSION FORCES SHALL BE CHECKED FOR PRYING ACTION. SEE DETAIL 13 / LP1Y-SF-0009P953.

ALL A325 BOLTS FOR THESE CONNECTIONS SHALL BE INSTALLED USING DIRECT TENSION INDICATORS (DTI'S) MADE TO ASTM F959 LATEST REVISION OR TENSION CONTROL BOLTS (TWIST-OFF-BOLTS) MADE TO ASTM F3125 LATEST REVISION WHERE SPECIFIED ON THE DESIGN DRAWINGS. REFER TO STEEL SHOP DRAWINGS FOR SYSTEM USED IN EACH STRUCTURE. DTI'S AND TWIST-OFF-BOLTS SHALL BE INSTALLED AND INSPECTED ON THE BOLTS PER THE MANUFACTURERS INSTRUCTIONS, OR TO THE PROVISIONS CONTAINED IN THE RESEARCH COUNCIL ON STRUCTURAL CONNECTIONS (RCSC) "SPECIFICATION FOR STRUCTURAL JOINTS USING A325 BOLTS".

FIELD TESTING OF DTI AND TWIST-OFF-BOLT COMPONENTS PRIOR TO INSTALLATION AND DTI AND TWIST-OFF-BOLT JOINT INSTALLATIONS SHALL BE PERFORMED IN ACCORDANCE WITH RCSC SPECIFICATION FOR STRUCTURAL JOINTS USING A325 BOLTS PER SECTION 8.2.

DTI'S SHALL BE ASTM F959 STANDARD DIRECT TENSION INDICATORS UTILIZING ASTM F959 VISUAL SELF-INDICATING DTI MANUFACTURER AND TYPE TO BE SUBMITTED TO EOR FOR REVIEW AND APPROVAL.
TWIST-OFF-BOLTS SHALL BE ASTM F3125 TWIST-OFF-BOLTS UTILIZING ASTM F3125 TWIST-OFF-BOLTS MANUFACTURER WITH TYPE TO BE SUBMITTED TO EOR FOR REVIEW AND APPROVAL.

WHERE DIRECT TENSION INDICATORS OR TWIST-OFF BOLTS ARE USED, IT IS SUGGESTED THAT A REPRESENTATIVE FROM THE MANUFACTURER BE CONTACTED TO PROVIDE JOB SITE SEMINARS ON THE PROPER INSTALLATION AND INSPECTION OF DIRECT TENSION INDICATOR OR TWIST-OFF-BOLT DEVICES.

SLIP-CRITICAL CONNECTIONS, JOINTS AND FASTENERS SHALL MEET THE REQUIREMENTS BELOW:
ALL BOLTS SHALL BE PRETENSIONED HIGH-STRENGTH BOLTS. ALL FAYING SURFACES SHALL BE PREPARED AS REQUIRED FOR CLASS B OR BETTER SLIP-CRITICAL JOINTS. BOLTED JOINTS SHALL NOT BE DESIGNED TO SHARE LOAD IN COMBINATION WITH WELDS ON THE SAME FAYING SURFACE. THE BEARING STRENGTH OF BOLTED JOINTS SHALL BE PROVIDED USING EITHER STANDARD HOLES OR SHORT-SLOTTED HOLES WITH THE SLOT PERPENDICULAR TO THE LINE OF FORCE.

S9. BOLTED CONNECTIONS FOR SECONDARY MEMBERS (SUCH AS ROOF PURLINS, GIRTS AND STAIR FRAMING) MAY BE MADE WITH 3/4" DIAMETER MACHINE BOLTS CONFORMING TO ASTM A307, GRADE A. BOLTS FOR STAIR BRACING, STAIR TREADS, AND TOE PLATES MAY BE 5/8" DIAMETER CONFORMING TO ASTM A307, GRADE A. NUTS FOR A307 BOLTS SHALL BE ASTM A563, GRADE A, UNLESS NOTED OTHERWISE.

S10. ALL BOLT HOLES FOR EQUIPMENT SUPPORTED ON STRUCTURAL STEEL SHALL BE FIELD DRILLED UNLESS NOTED OTHERWISE.

S11. ALL BOLTED CONNECTIONS SHALL HAVE A MINIMUM OF 2 ROWS OF BOLTS UNLESS NOTED OTHERWISE.

S12. COLUMN SPLICES SHALL CONFORM TO DETAILS IN THE AISC STEEL CONSTRUCTION MANUAL,TABLE 14-3 CASE I, II, VI OR VII.

S13. SHOP DRAWINGS AND WEIGHT LISTS SHALL BE PREPARED BY THE FABRICATOR IN ACCORDANCE WITH AISC SPECIFICATIONS. SHOP DRAWINGS SHALL BE APPROVED BY ENGINEER BEFORE FABRICATION IS STARTED. APPROVAL SHALL NOT RELIEVE THE FABRICATOR OF THEIR RESPONSIBILITY FOR STRUCTURAL ADEQUACY OR FIT UP IN THE FIELD.

S14. AXIAL FORCES AND TRANSFER FORCES ARE DESIGNATED BY (+) FOR TENSION AND (-) FOR COMPRESSION ON THE DESIGN DRAWINGS. THESE FORCES VARY LEVEL OF FACTORING BASED ON NODE. ALL CONNECTION FORCES SHOWN ARE LRFD DESIGN PHILOSOPHY. CONNECTIONS FOR BEAM/GIRDERS RESISTING THESE AXIAL LOADS SHALL BE DESIGNED FOR THE AXIAL LOAD IN ADDITION TO THE SHEAR LOAD. UNLESS OTHERWISE NOTED ON THE DESIGN DRAWINGS, BEAM CONNECTIONS SHALL USE THE FOLLOWING AXIAL LOADS FOR DESIGN:

ALL INFILL BEAMS (NOT ON COLUMN LINES): AXIAL TRANSFER LOAD OF 3KIPS. THIS LOAD NEED NOT BE ASSUMED TO ACT CONCURRENTLY WITH VERTICAL LOADS. THIS AXIAL LOAD MAY BE RESISTED BY BOLT BEARING, EVEN IF HORIZONTAL SHORT SLOTS ARE USED IN THE SHEAR TAB CONNECTIONS.

BEAM AND GIRDER CONNECTIONS ON COLUMN LINES BUT NOT AT BRACED LINES: AXIAL TRANSFER LOAD OF 10KIPS. THIS LOAD IS TO BE CHECKED CONCURRENTLY WITH VERTICAL LOADS, AND IS TO BE RESISTED WITH SLIP CRITICAL BOLTS. THE VERTICAL LOADS IN THESE CONNECTIONS MAY BE RESISTED BY BOLT BEARING.

BEAM AND GIRDER CONNECTIONS AT BRACED LINES: TRANSFER LOAD SHOWN ON DESIGN DRAWINGS. THIS LOAD IS TO BE CHECKED CONCURRENTLY WITH VERTICAL LOADS, AND IS TO BE RESISTED WITH SLIP CRITICAL BOLTS OR WELDS. THE VERTICAL LOADS IN THESE CONNECTIONS MAY BE RESISTED BY BOLT BEARING.

S15. BEAM VERTICAL SHEAR CONNECTION LOADS THAT REQUIRE ADDITIONAL FORCES TO THOSE DISCUSSED IN THESE NOTES AND SHOWN ON THE DESIGN DRAWINGS WILL BE PROVIDED TO THE CONNECTION ENGINEER FOR ALL APPLICABLE BEAMS AND GIRDER IN A SPECIFICATION OR TABLE.

S16. ALL HORIZONTAL AND VERTICAL BRACING MEMBERS SHALL HAVE THEIR CONNECTIONS DESIGNED BY THE FABRICATOR FOR THE FORCES SHOWN ON THE DRAWINGS, IN ACCORDANCE WITH THE STANDARD DRAWINGS. ALL FORCES ARE LFRD DESIGN PHILOSOPHY FOR CONNECTION DESIGN.

FORCES ARE DENOTED AS (+) FOR TENSION AND (-) FOR COMPRESSION. WHERE FORCES ARE NOT SHOWN, PROVIDE MINIMUM CONNECTION PER STANDARD DRAWINGS.

S17. MINIMUM GUSSET PLATE THICKNESS SHALL BE 3/8".

S18. WORK POINTS FOR BRACING CONNECTIONS SHALL BE CONCENTRIC WITH THE CENTERLINE OF THE COLUMN UNLESS OTHERWISE SHOWN OR NOTED. WHERE THIS IS NOT POSSIBLE, CONNECTIONS SHALL BE DESIGNED BY THE FABRICATOR TO ACCOUNT FOR THE RESULTING ECCENTRICITIES.

S19. ALL STRUCTURAL STEEL NOT ENCASED WITH FIREPROOFING SHALL BE HOT-DIPPED GALVANIZED PER SPECIFICATION LP100-215-EMS-05120. UNCOATED BOLT ASSEMBLIES SHALL BE FULLY COATED TO MATCH THE CONNECTED STEEL.

S20. ALL EXTERIOR PLATFORM AND WALKWAYS SHALL GENERALLY BE COVERED BY SERRATED GALVANIZED GRATING WITH 1 1/4" BY 3/16", BEARING BARS AT 1 3/16" ON CENTER UNLESS NOTED OTHERWISE. THE WEIGHT OF REMOVABLE FLOORING SECTIONS SHALL NOT EXCEED 150 POUNDS. ALL EDGES OF GRATING TO BE BANDED.

S21. DIMENSIONS NOTED PLUS (+) OR MINUS (-) FOLLOWING MEMBER SIZES IN PLAN VIEW ARE FROM TOP OF STEEL ELEVATION, UNLESS NOTED OTHERWISE ON PLAN.

S22. ALL OPENINGS IN GRATING OVER 10" DIAMETER SHALL BE BANDED BY FABRICATOR. FIELD LOCATE AND CUT 10" DIAMETER AND SMALLER OPENINGS IN GRATING, UNLESS NOTED OTHERWISE. HOLES 10" DIAMETER AND SMALLER SHALL HAVE SLEEVE ATTACHED PER STANDARD DRAWINGS.

S23. ALL METAL ROOF AND FLOOR DECKING SHALL BE GALVANIZED, UNLESS NOTED OTHERWISE.

S24. DURING THE FINAL PLACING OF SOLID WEB STRUCTURAL MEMBERS, THE LOAD SHALL NOT BE RELEASED FROM THE HOISTING LINE UNTIL THE MEMBERS ARE SECURED WITH AT LEAST TWO BOLTS PER CONNECTION EXCEPT FOR DIAGONAL BRACING. SOLID WEB STRUCTURAL MEMBERS USED AS DIAGONAL BRACING SHALL BE SECURED BY AT LEAST ONE BOLT PER CONNECTION. BOLT MUST BE THE SAME SIZE AND STRENGTH AS SHOWN ON THE ERECTION DRAWING AND DRAWN UP WRENCH TIGHT. FOR REFERENCE, REFER TO OSHA REGULATION 1926.756.

S25. ALL COLUMNS SHALL BE ANCHORED BY A MINIMUM OF (4) ANCHOR BOLTS. EACH COLUMN SPLICE AND COLUMN ANCHOR BOLT ASSEMBLY INCLUDING THE WELDING TO THE BASE PLATE, SHALL BE DESIGNED TO RESIST 300 POUNDS ECCENTRIC LOAD LOCATED 18" FROM THE COLUMN FACE IN EACH DIRECTION AT THE TOP OF THE COLUMN SHAFT. FOR REFERENCE, REFER TO OSHA REGULATION 1926.755.

S26. ALL COLUMN ENDS AT SPLICES, BASE PLATES AND CAP PLATES SHALL BE MILLED FOR FULL BEARING.

S27. ALL TUBE STEEL BEAMS, BRACES, POSTS AND HANGERS SHALL HAVE THEIR OPEN ENDS CLOSED WITH A 1/8" CAP PLATE WELDED ALL AROUND (UNO).

S28. ALL LADDERS, GUARDRAIL AND TOE PLATE SHALL BE PAINTED AS FOLLOWS:
EXCEPT FOR STAINLESS STEEL, GALVANIZED OR ALUMINUM SYSTEMS, WHICH ARE UNPAINTED;

EXTERIOR EQUIPMENT LADDERS AND RAILS: ALL EXTERIOR STEEL IS GALVANIZED.
PIPE RACK RAILS AND LADDERS: PAINTED GRAY PER PROJECT SPECIFICATION LP1-220-EMS-09902.

COLD-FORMED METAL FRAMING

1. PROVIDE ACCESSORIES OF MANUFACTURER'S STANDARD THICKNESS AND CONFIGURATION, UNLESS OTHERWISE INDICATED, AS FOLLOWS:
   1. BRACING, BRIDGING, AND SOLID BLOCKING
   2. WEB STIFFENERS
   3. ANCHOR CLIPS
   4. END CLIPS
   5. FOUNDATION CLIPS
   6. GUSSET PLATES
   7. STUD KICKERS, KNEE BRACES, AND GIRTS
   8. HOLE REINFORCING PLATES
   9. BACKER PLATE
   10. EXPANSION ANCHORS
   11. POWER-ACTUATED ANCHORS
2. INSTALL FRAMING MEMBERS IN ONE-PIECE LENGTHS.
3. FASTEN COLD-FORMED METAL FRAMING MEMBERS BY WELDING, SCREW FASTENING, CLINCH FASTENING, OR RIVETING AS STANDARD WITH FABRICATOR. WIRE TYING OF FRAMING MEMBERS IS NOT PERMITTED.
4. INSTALL MISCELLANEOUS FRAMING AND CONNECTIONS, INCLUDING SUPPLEMENTARY FRAMING, WEB STIFFENERS, CLIP ANGLES, CONTINUOUS ANGLES, ANCHORS, AND FASTENERS, TO PROVIDE A COMPLETE AND STABLE SYSTEM.
5. COLD FORMED METAL FRAMING DESIGN, FABRICATION AND ERECTION SHALL BE IN CONFORMANCE WITH THE FOLLOWING CODES AND STANDARDS UNLESS NOTED OTHERWISE.
   1. AISI S100 - "NORTH AMERICAN SPECIFICATION FOR THE DESIGN OF COLD-FORMED STEEL STRUCTURAL MEMBERS."
   2. AISI S200 - "NORTH AMERICAN STANDARD FOR COLD-FORMED STEEL FRAMING - GENERAL PROVISIONS."
   3. AISI S201 - "NORTH AMERICAN STANDARD FOR COLD-FORMED STEEL FRAMING - PRODUCT STANDARD."
   4. AISI S202 - "CODE OF STANDARD PRACTICE FOR COLD-FORMED STEEL STRUCTURAL FRAMING."
   5. AISI S240 - "NORTH AMERICAN STANDARD FOR COLD-FORMED STEEL STRUCTURAL FRAMING."
   6. ASCE 7 - MINIMUM DESIGN LOADS FOR BUILDINGS AND OTHER STRUCTURES.
   7. ASTM A 653 - SPECIFICATION FOR STEEL SHEET, ZINC-COATED (GALVANIZED) OR ZINC-IRON ALLOY-COATED (GALVANNEALED) BY THE HOT-DIP PROCESS.
6. PREINSTALLATION MEETING: PRIOR TO ERECTION OF FRAMING, CONDUCT PREINSTALLATION MEETING AT SITE ATTENDED BY OWNER, ARCHITECT, GENERAL CONTRACTOR, MANUFACTURER'S TECHNICAL REPRESENTATIVE, INSPECTION AGENCY AND RELATED TRADE CONTRACTORS.
7. SUBMITTALS
   A. PRODUCT DATA: FOR EACH TYPE OF PRODUCT.
   B. SHOP DRAWINGS:
      A. INCLUDE LAYOUT, SPACINGS, SIZES, THICKNESSES, AND TYPES OF COLD-FORMED STEEL FRAMING; FABRICATION; AND FASTENING AND ANCHORAGE DETAILS, INCLUDING MECHANICAL FASTENERS.
      B. INDICATE REINFORCING CHANNELS, OPENING FRAMING, SUPPLEMENTAL FRAMING, STRAPPING, BRACING, BRIDGING, SPLICES, ACCESSORIES, CONNECTION DETAILS, AND ATTACHMENT TO ADJOINING WORK.
      C. DELEGATED-DESIGN SUBMITTAL: FOR COLD-FORMED STEEL FRAMING.
8. QUALITY ASSURANCE
   A. TESTING AGENCY QUALIFICATIONS: QUALIFIED ACCORDING TO ASTM E 329 FOR TESTING INDICATED.
   B. PRODUCT TEST REPORTS: FOR EACH LISTED PRODUCT, FOR TESTS PERFORMED BY **MANUFACTURER AND WITNESSED BY A QUALIFIED TESTING AGENCY**.
      a. STEEL SHEET.
      b. POWER-ACTUATED ANCHORS.
      c. MECHANICAL FASTENERS.
      d. VERTICAL DEFLECTION CLIPS.
      e. HORIZONTAL DRIFT DEFLECTION CLIPS
      F. MISCELLANEOUS STRUCTURAL CLIPS AND ACCESSORIES
   C. PRODUCT TESTS: MILL CERTIFICATES OR DATA FROM A QUALIFIED INDEPENDENT TESTING AGENCY **, OR IN-HOUSE TESTING WITH CALIBRATED TEST EQUIPMENT,** INDICATING STEEL SHEET COMPLIES WITH REQUIREMENTS, INCLUDING BASE-METAL THICKNESS, YIELD STRENGTH, TENSILE STRENGTH, TOTAL ELONGATION, CHEMICAL REQUIREMENTS, AND METALLIC-COATING THICKNESS.
9. PRODUCTS
   A. PERFORMANCE REQUIREMENTS
      a. DELEGATED DESIGN: ENGAGE A QUALIFIED PROFESSIONAL ENGINEER LICENSED IN THE STATE OF INDIANA TO DESIGN COLD-FORMED STEEL FRAMING.
      b. ~~STRUCTURAL PERFORMANCE: PROVIDE COLD-FORMED STEEL FRAMING CAPABLE OF WITHSTANDING DESIGN LOADS WITHIN LIMITS AND UNDER CONDITIONS~~ INDICATED.
      c. DESIGN LOADS: AS INDICATED ON DRAWINGS. DEFLECTION LIMITS: DESIGN FRAMING SYSTEMS TO WITHSTAND DESIGN LOADS WITHOUT DEFLECTIONS GREATER THAN THE FOLLOWING:
         • ROOF RAFTER FRAMING: VERTICAL DEFLECTION OF 1/240 OF THE HORIZONTALLY PROJECTED SPAN FOR LIVE LOADS.
      d. DESIGN FRAMING SYSTEMS TO PROVIDE FOR MOVEMENT OF FRAMING MEMBERS WITHOUT DAMAGE OR OVERSTRESSING, SHEATHING FAILURE, CONNECTION FAILURE, UNDUE STRESS ON FASTENERS AND ANCHORS, OR OTHER DETRIMENTAL EFFECTS WHEN SUBJECT TO A MAXIMUM AMBIENT TEMPERATURE CHANGE OF 120 DEG F
      e. DESIGN FRAMING SYSTEM TO MAINTAIN CLEARANCES AT OPENINGS, TO ALLOW FOR CONSTRUCTION TOLERANCES, AND TO ACCOMMODATE LIVE LOAD DEFLECTION OF PRIMARY BUILDING STRUCTURE AS FOLLOWS: UPWARD AND DOWNWARD MOVEMENT OF 1 INCH
      f. COLD-FORMED STEEL FRAMING STANDARDS: UNLESS MORE STRINGENT REQUIREMENTS ARE INDICATED, FRAMING SHALL COMPLY WITH AISI S100, AISI S200, AND THE FOLLOWING: FIRE-RESISTANCE RATINGS: COMPLY WITH ASTM E 119; TESTING BY A QUALIFIED TESTING AGENCY. IDENTIFY PRODUCTS WITH APPROPRIATE MARKINGS OF APPLICABLE TESTING AGENCY. INDICATE DESIGN DESIGNATIONS FROM UL'S "FIRE RESISTANCE DIRECTORY" OR FROM THE LISTINGS OF ANOTHER QUALIFIED TESTING AGENCY ACCEPTABLE TO AUTHORITIES HAVING JURISDICTION.
10. COLD FORMED STEEL FRAMING MATERIALS
    A. STEEL SHEET: ASTM A 1003/A 1003M, STRUCTURAL GRADE, TYPE H, METALLIC COATED, OF GRADE AND COATING DESIGNATION AS FOLLOWS:
       a. GRADE: AS REQUIRED FOR STRUCTURAL PERFORMANCE.
       B. COATING: G90 GALVANIZED.
    B. STEEL SHEET FOR [VERTICAL DEFLECTION] [DRIFT] CLIPS: ASTM A 653/A 653M, STRUCTURAL STEEL, ZINC COATED, OF GRADE AND COATING AS FOLLOWS:
       a. GRADE: AS REQUIRED BY STRUCTURAL PERFORMANCE.
       B. COATING: G90
11. ROOF-PURLIN FRAMING
    A. STEEL RAFTERS: MANUFACTURER'S STANDARD C-SHAPED OR Z-SHAPED STEEL SECTIONS, OF WEB DEPTHS INDICATED, WITH STIFFENED FLANGES, AND AS FOLLOWS:
       A. MINIMUM BASE-METAL THICKNESS: 0.0329, MINIMUM
       B. FLANGE WIDTH: 1-5/8 INCHES, MINIMUM.
    B. FRAMING ACCESSORIES: FABRICATE STEEL-FRAMING ACCESSORIES FROM ASTM A 1003/A 1003M, STRUCTURAL GRADE, TYPE H, METALLIC COATED STEEL SHEET, OF SAME GRADE AND COATING DESIGNATION USED FOR FRAMING MEMBERS.
    C. PROVIDE ACCESSORIES OF MANUFACTURER'S STANDARD THICKNESS AND CONFIGURATION, UNLESS OTHERWISE INDICATED, AS FOLLOWS:
       A. SUPPLEMENTARY FRAMING.
       B. BRACING, BRIDGING, AND SOLID BLOCKING.
       C. WEB STIFFENERS.
       D. ANCHOR CLIPS.
       E. END CLIPS.
       F. ANCHORS, CLIPS, AND FASTENERS
       G. STEEL SHAPES AND CLIPS: ASTM A 36/A 36M, ZINC COATED BY HOT-DIP PROCESS ACCORDING TO ASTM A 123/A 123M.
       H. POWER-ACTUATED ANCHORS: FASTENER SYSTEMS WITH WORKING CAPACITY GREATER THAN OR EQUAL TO THE DESIGN LOAD, ACCORDING TO AN EVALUATION REPORT ACCEPTABLE TO AUTHORITIES HAVING JURISDICTION, BASED ON ICC-ES AC70.
       I. MECHANICAL FASTENERS: ASTM C 1513, CORROSION-RESISTANT-COATED, SELF-DRILLING, SELF-TAPPING, STEEL DRILL SCREWS.
12. MISCELLANEOUS MATERIALS
    A. GALVANIZING REPAIR PAINT: **ASTM A 780 OR SSPC-PAINT 20**.
    B. SHIMS: LOAD-BEARING, HIGH-DENSITY, MULTIMONOMER, NONLEACHING PLASTIC; OR COLD-FORMED STEEL OF SAME GRADE AND METALLIC COATING AS FRAMING MEMBERS SUPPORTED BY SHIMS.
13. FABRICATION
    A. FABRICATE COLD-FORMED STEEL FRAMING AND ACCESSORIES PLUMB, SQUARE, AND TRUE TO LINE, AND WITH CONNECTIONS SECURELY FASTENED, ACCORDING TO REFERENCED AISI'S SPECIFICATIONS AND STANDARDS, MANUFACTURER'S WRITTEN INSTRUCTIONS, AND REQUIREMENTS IN THIS SECTION.
       A. FABRICATE FRAMING ASSEMBLIES USING JIGS OR TEMPLATES.
       B. CUT FRAMING MEMBERS BY SAWING OR SHEARING; DO NOT TORCH CUT.
       C. FASTEN COLD-FORMED STEEL FRAMING MEMBERS BY SCREW FASTENING, CLINCH FASTENING, PNEUMATIC PIN FASTENING, OR RIVETING AS STANDARD WITH FABRICATOR. WIRE TYING OF FRAMING MEMBERS IS NOT PERMITTED. LOCATE MECHANICAL FASTENERS AND INSTALL ACCORDING TO SHOP DRAWINGS, WITH SCREWS PENETRATING JOINED MEMBERS BY NO FEWER THAN THREE EXPOSED SCREW THREADS.
       D. FASTEN OTHER MATERIALS TO COLD-FORMED STEEL FRAMING BY BOLTING, PNEUMATIC PIN FASTENING, OR SCREW FASTENING, ACCORDING TO SHOP DRAWINGS.
    B. REINFORCE ASSEMBLIES AS REQUIRED FOR FRAMING ASSEMBLIES TO WITHSTAND HANDLING, DELIVERY, AND ERECTION STRESSES. LIFT FABRICATED ASSEMBLIES BY MEANS THAT PREVENT DAMAGE OR PERMANENT DISTORTION.
    C. TOLERANCES: FABRICATE ASSEMBLIES LEVEL, PLUMB, AND TRUE TO LINE TO A MAXIMUM ALLOWABLE VARIATION OF 1/8 INCH IN 10 FEET (1:960) AND AS FOLLOWS:
       A. SPACING: SPACE INDIVIDUAL FRAMING MEMBERS NO MORE THAN PLUS OR MINUS 1/8 INCH FROM PLAN LOCATION. CUMULATIVE ERROR SHALL NOT EXCEED MINIMUM FASTENING REQUIREMENTS OF SHEATHING OR OTHER FINISHING MATERIALS.
       B. SQUARENESS: FABRICATE EACH COLD-FORMED STEEL FRAMING ASSEMBLY TO A MAXIMUM OUT-OF-SQUARE TOLERANCE OF 1/8 INCH.
14. EXAMINATION
    A. EXAMINE SUBSTRATES, AREAS, CONDITIONS, AND ABUTTING STRUCTURAL FRAMING FOR COMPLIANCE WITH REQUIREMENTS FOR INSTALLATION TOLERANCES AND OTHER CONDITIONS AFFECTING PERFORMANCE OF THE WORK.
    B. PROCEED WITH INSTALLATION ONLY AFTER UNSATISFACTORY CONDITIONS HAVE BEEN CORRECTED.
15. INSTALLATION, GENERAL
    A. COLD-FORMED STEEL FRAMING MAY BE SHOP OR FIELD FABRICATED FOR INSTALLATION, OR IT MAY BE FIELD ASSEMBLED.
    B. INSTALL COLD-FORMED STEEL FRAMING ACCORDING TO AISI S200, AISI S202, AND MANUFACTURER'S WRITTEN INSTRUCTIONS UNLESS MORE STRINGENT REQUIREMENTS ARE INDICATED.
    C. INSTALL SHOP- OR FIELD-FABRICATED, COLD-FORMED FRAMING AND SECURELY ANCHOR TO SUPPORTING STRUCTURE.
    D. INSTALL COLD-FORMED STEEL FRAMING AND ACCESSORIES PLUMB, SQUARE, AND TRUE TO LINE, AND WITH CONNECTIONS SECURELY FASTENED.
       A. CUT FRAMING MEMBERS BY SAWING OR SHEARING; DO NOT TORCH CUT.
       B. FASTEN COLD-FORMED STEEL FRAMING MEMBERS BY WELDING, SCREW FASTENING, CLINCH FASTENING, OR RIVETING. WIRE TYING OF FRAMING MEMBERS IS NOT PERMITTED. LOCATE MECHANICAL FASTENERS, INSTALL ACCORDING TO SHOP DRAWINGS, AND COMPLY WITH REQUIREMENTS FOR SPACING, EDGE DISTANCES, AND SCREW PENETRATION.
    E. INSTALL FRAMING MEMBERS IN ONE-PIECE LENGTHS UNLESS SPLICE CONNECTIONS ARE INDICATED FOR TRACK OR TENSION MEMBERS.
    F. INSTALL TEMPORARY BRACING AND SUPPORTS TO SECURE FRAMING AND SUPPORT LOADS EQUAL TO THOSE FOR WHICH STRUCTURE WAS DESIGNED. MAINTAIN BRACES AND SUPPORTS IN PLACE, UNDISTURBED, UNTIL ENTIRE INTEGRATED SUPPORTING STRUCTURE HAS BEEN COMPLETED AND PERMANENT CONNECTIONS TO FRAMING ARE SECURED.
16. ROOF PURLIN INSTALLATION
    A. INSTALL PERIMETER JOIST TRACK SIZED TO MATCH PURLINS. ALIGN AND SECURELY ANCHOR OR FASTEN TRACK TO SUPPORTING STRUCTURE AT CORNERS, ENDS, AND SPACINGS INDICATED ON SHOP DRAWINGS].
    B. INSTALL PURLINS BEARING ON SUPPORTING FRAME, LEVEL, STRAIGHT, AND PLUMB; ADJUST TO FINAL POSITION, BRACE, AND REINFORCE. FASTEN PURLINS TO BOTH FLANGES OF JOIST TRACK.
       A. INSTALL PURLINS OVER SUPPORTING FRAME WITH A MINIMUM END BEARING OF 1-1/2 INCHES.
       B. REINFORCE WEBS AND BEARING POINTS OF PURLINS WITH WEB STIFFENERS, END CLIPS, JOIST HANGERS, STEEL CLIP ANGLES, OR STEEL-STUD SECTIONS.
    C. SPACE PURLINS AS FOLLOWS:
       A. PURLIN SPACING: AS INDICATED ON DRAWINGS
    D. INSTALL PURLIN REINFORCEMENT AT INTERIOR SUPPORTS WITH SINGLE, SHORT LENGTH OF PURLIN SECTION LOCATED DIRECTLY OVER INTERIOR SUPPORT, WITH LAPPED PURLINS OF EQUAL LENGTH TO PURLIN REINFORCEMENT.
       A. INSTALL WEB STIFFENERS TO TRANSFER AXIAL LOADS OF WALLS ABOVE.
    E. INSTALL BRIDGING AT INTERVALS INDICATED ON SHOP DRAWINGS. FASTEN BRIDGING AT EACH PURLIN INTERSECTION AS FOLLOWS:
       A. JOIST-TRACK SOLID BRIDGING: JOIST-TRACK SOLID BLOCKING OF WIDTH AND THICKNESS INDICATED, SECURED TO PURLIN WEBS.
       B. COMBINATION BRIDGING: COMBINATION OF FLAT, TA

CONCRETE MATERIAL CRITERIA

C1. CONCRETE DESIGN AND CONSTRUCTION SHALL CONFORM TO THE LATEST EDITION OF THE FOLLOWING CODES AND SPECIFICATIONS, UNLESS NOTED OTHERWISE:

ACI (AMERICAN CONCRETE INSTITUTE) 318-11 BUILDING CODE REQUIREMENTS FOR REINFORCED CONCRETE.

C2. CONCRETE STRUCTURAL MATERIAL SHALL CONFORM TO THE FOLLOWING STANDARDS, UNLESS NOTED OTHERWISE:

28-DAY CONCRETE STRENGTH f'c = 5000 PSI SLAB ON GRADE
f'c = 5000 PSI FOUNDATIONS

SLAB ON GRADE, PIERS, STAIR LANDINGS, ALL OTHER CONCRETE NOT INCLUDED IN PILE CAPS AND TIE BEAMS:

CONCRETE EXPOSURE CLASSES	F3, S0, P1, C2
MAXIMUM W/CM RATIO	0.40
MAXIMUM NOM. AGG. SIZE	1 1/2"
AIR CONTENT RATIO	5.5% ± 1.5%
MAXIMUM CI- CONTENT	0.15 (WATER-SOLUBLE CHLORIDE ION CONTENT)

PILE CAPS AND TIE BEAMS:
CONCRETE EXPOSURE CLASSES F0, S0, P0, C1

REINFORCING STEEL	ASTM A615, GRADE 60 DEFORMED BARS
WELDED WIRE FABRIC	ASTM A185
WELDED REINFORCING STEEL	ASTM A706, GRADE 60

C3. SLEEVES, EMBEDS, OPENINGS AND OTHER WORK AFFECTING CONCRETE WORK SHALL BE COORDINATED WITH CIVIL, PLUMBING, PIPING, ELECTRICAL, MECHANICAL, AND FIRE PROTECTION DESIGN DRAWINGS PRIOR TO PLACING CONCRETE.

C4. EXPOSED CORNERS OF CONCRETE SHALL HAVE A 3/4" CHAMFER (UNLESS NOTED OTHERWISE).

C5. PRIOR TO PLACING CONCRETE, ALL REINFORCING STEEL SHALL BE FREE OF RUST, SCALE, OR ANY FOREIGN MATERIAL.

C6. ALL ANCHOR BOLTS AND EQUIPMENT OPENINGS SHALL BE CHECKED AGAINST CERTIFIED VENDOR DRAWINGS BEFORE PLACING CONCRETE.

C7. REFER TO PROJECT SPECIFICATION LP100-215-EMS-03001 FOR ADDITIONAL REQUIREMENTS.

FOUNDATION NOTES

F1. FOR FOUNDATION CRITERIA, REFER TO SPECIFICATION LP100-215-EMS-05001, STRUCTURAL ENGINEERING CRITERIA & GEOTECHNICAL REPORT PREPARED BY S&ME FOR THE TANK FARM AND PIPE RACKS (DOCUMENT # B1LG-00-K003-00158 DATED JANUARY 2ND, 2024).

F2. EARTHWORK AND FILL MATERIALS SHALL CONFORM TO PROJECT SPECIFICATIONS:

SPEC NO	DESCRIPTION
B1LG-00-K004-00005	EARTHWORK
B1LG-00-K004-00006	DEWATERING

F3. ALL STRUCTURAL FILL SHALL BE SELECT GRANULAR MATERIAL FREE FROM ROOTS, TRASH, WOOD SCRAPS AND OTHER EXTRANEOUS MATERIALS. PLACE FILL IN LIFTS AND COMPACTED PER PROJECT SPECIFICATIONS.

F4. A 2" TO 4" (NOMINAL) CONCRETE MUD MAT SHALL BE INSTALLED AT FOOTING, MAT, AND SLAB ON GRADE BEARING ELEVATIONS UNDER ANY OF THE FOLLOWING CONDITIONS:

A. WHEN INSTRUCTED BY THE GEOTECHNICAL ENGINEER.
B. WHEN WET WEATHER CONDITIONS ARE ANTICIPATED.
C. WHEN OVERNIGHT AND/OR PROLONGED EXPOSURE OF THE EXCAVATED AREA IS ANTICIPATED (TO PREVENT DRYING AND CRACKING OF THE SUBGRADE).
D. WHEN IT IS EXPECTED THAT CONSTRUCTION ACTIVITIES WILL LOOSEN OR DISTURB THE BEARING SURFACE.

F5. FOOTING ELEVATIONS SHALL NOT BE RAISED OR LOWERED WITHOUT THE APPROVAL OF THE STRUCTURAL ENGINEER.

F6. SUBSTRUCTURE EXCAVATIONS SHALL BE INSPECTED BY A QUALIFIED SOILS ENGINEER TO VERIFY THAT SUITABLE BEARING SOILS ARE PRESENT. SOFT AREAS OR UNSUITABLE MATERIALS SHALL BE REPAIRED AS PER GEOTECHNICAL ENGINEER SPECIFICATIONS.

F7. ALL ELECTRICAL CONDUITS, GROUNDING LOOPS, DUCT BANKS, UNDERGROUND PIPING, ETC. SHALL BE IN PLACE PRIOR TO POURING CONCRETE.

F8. ANCHOR BOLTS SHALL NOT BE REPAIRED, REPLACED OR FIELD MODIFIED WITHOUT THE APPROVAL OF THE PROJECT STRUCTURAL ENGINEER OF RECORD. FOR REFERENCE SEE OSHA REGULATION 1926.755..

GROUTING NOTES

G1. CONCRETE SURFACES TO BE IN CONTACT WITH GROUT SHALL BE FREE OF LAITANCE AND GREASE, OIL AND OTHER CONTAMINANTS.

G2. CONCRETE SURFACES SHALL BE PREPARED BY MECHANICAL MEANS SUCH THAT COARSE AGGREGATE IS EXPOSED. EXPOSED SURFACES SHALL HAVE A DEGREE OF ROUGHNESS EQUIVALENT TO 1/4" AMPLITUDE. PREPARED SURFACES SHALL THEN BE BLOWN FREE OF FRAGMENTS AND DUST.

G3. ALL BASE PLATES SHALL BE SET TO FINAL ALIGNMENT USING SHIMS.

G4. PLACE SHIMS A MINIMUM OF 1" FROM THE EDGE OF THE BASE PLATE TO FULLY ENCASE SHIM IN GROUT AFTER FINAL ALIGNMENT IS SET.

G5. PRIOR TO GROUT PLACEMENT PRESOAK THE PREPARED CONCRETE FOR A MINIMUM OF 8 HOURS WITH POTABLE WATER. CONCRETE SHALL BE FREE OF STANDING WATER AT TIME OF PLACEMENT.

G6. BASEPLATE SURFACES TO BE IN CONTACT WITH GROUT SHALL BE FREE OF OIL, GREASE, RUST AND OTHER CONTAMINANTS.

G7. FORMWORK SHALL BE CONSTRUCTED SUCH THAT GROUT IS PLACED ACROSS THE SHORTEST DIMENSION.

G8. A HEADBOX SHALL BE CONSTRUCTED ACCORDING TO THE GROUT MANUFACTURER'S REQUIREMENTS. HEADBOX SHALL BE USED FOR INSTALLATION OF GROUT.

G9. THE CLEARANCE BETWEEN FORMWORK AND BASEPLATE SHALL BE 3 TO 5 INCHES TO ALLOW FOR A HEADBOX.

G10. FORMWORK SHALL EXTEND A MINIMUM OF ONE INCH ABOVE THE BOTTOM OF THE BASEPLATE. FINISHED GROUT SURFACE @ EDGE OF BASE PLATE SHALL NOT PROJECT ABOVE BOTTOM OF BASE PLATE.

G11. ALL FORMWORK SHALL BE COATED WITH FORM RELEASE AGENT (WITH CARE NOT TO CONTAMINATE THE GROUTING SURFACES).

G12. CONDITION AND MAINTAIN ALL MATERIALS AND SURFACES THAT WILL BE IN CONTACT WITH GROUT TO BETWEEN 40 AND 90 DEGREES F.

G13. PROVIDE AN ADEQUATE NUMBER OF MORTAR MIXERS FOR UNINTERRUPTED PLACEMENT. DO NOT EXCEED 1/2 OF THE CAPACITY OF MORTAR MIXER.

G14. DO NOT RETEMPER THE GROUT MIX BY ADDING ADDITIONAL WATER.

G15. MIXING AND PLACEMENT: GROUT MANUFACTURER SHALL BE PRESENT FOR PRE-PLACEMENT MEETINGS AND DURING THE INITIAL MIXING AND PLACEMENT AT NO COST TO THE CONTRACTOR, ENGINEER OR OWNER. GROUT MANUFACTURER SHALL BE GIVEN A 72 HOUR NOTICE PRIOR TO THE PRE-PLACEMENT MEETING OR THE INITIAL PLACEMENT.

G16. GROUT CUBES SHALL BE TAKEN ACCORDING TO THE REQUIREMENTS OF ASTM C109. GROUT MOLDS SHALL BE BRASS.

G17. NON-SHRINK NONMETALLIC PREPACKAGED GROUT SHALL BE FIVE STAR FLUID GROUT 100. EPOXY GROUT SHALL BE ESCOWELD EPOXY GROUT OR MASTERFLOW 648.

GROUT TESTING:

GT1. A MINIMUM OF NINE (9) 2" GROUT CUBES (3 SETS OF 3 CUBES) SHALL BE MADE FOR COMPRESSIVE STRENGTH TESTING USING BRASS GROUT MOLDS. GROUT CUBES SHALL BE TAKEN DIRECTLY FROM THE MIXER.

GT2. GROUT CUBES ARE TO BE INITIALLY CURED FOR A PERIOD OF 24 HOURS UNDER SIMILAR CONDITIONS AS THE GROUT POURED THAT DAY PRIOR TO TRANSPORT TO THE LABORATORY FOR TESTING. GROUT CUBES ARE TO BE STORED IN A PROTECTIVE CONTAINER TO PREVENT EXPOSURE TO EXCESSIVELY HOT OR COLD TEMPERATURES.

GT3. GROUT CUBES SHALL BE TESTED BY THE OWNER'S TESTING LABORATORY TO VERIFY THE DESIGN GROUT STRENGTH HAS BEEN ACHIEVED IN ACCORDANCE WITH APPLICABLE PROVISIONS OF ASTM C109. TEST ONE CUBE SET AT 7 DAYS, ONE SET AT 28 DAYS, AND THE THIRD SET AT THE DISCRETION OF THE CONSTRUCTION MANAGER.

POST INSTALLED ANCHOR NOTES

P1. POST-INSTALLED ANCHORS SHALL ONLY BE USED WHERE SPECIFIED ON THE CONSTRUCTION DOCUMENTS. THE CONTRACTOR SHALL OBTAIN APPROVAL FROM THE ENGINEER PRIOR TO INSTALLING POST-INSTALLED ANCHORS IN PLACE OF MISSING OR MISPLACED CAST-IN-PLACE ANCHORS. CARE SHALL BE TAKEN IN PLACING POST-INSTALLED ANCHORS TO AVOID CONFLICTS WITH EXISTING REINFORCING. HOLES SHALL BE DRILLED AND CLEANED IN ACCORDANCE WITH THE MANUFACTURER'S WRITTEN INSTRUCTIONS.

A. ANCHORAGE TO CONCRETE
  i) ADHESIVE ANCHORS FOR CRACKED AND UNCRACKED CONCRETE USE:
    1) HILTI HIT-RE 500-SD INJECTION ADHESIVE ANCHORING SYSTEM PER ICC ESR-3187 FOR SLOW CURE APPLICATIONS

B. MECHANICAL ANCHORS
  i) EXPANSION ANCHORS FOR UNCRACKED CONCRETE
    1) KWIK BOLT 3 GALVANIZED ANCHOR PER ICC ESR-2302 FOR CONCRETE.
  ii) EXPANSION ANCHORS FOR MASONRY
    1) PER ICC ESR-1385 FOR MASONRY

P2. SUBSTITUTION REQUESTS, FOR PRODUCTS OTHER THAN THOSE SPECIFIED ABOVE SHALL BE SUBMITTED BY THE CONTRACTOR TO THE ENGINEER ALONG WITH PRODUCT ICC-ESR REPORT, MANUFACTURER'S WRITTEN INSTALLATION INSTRUCTIONS, AND CALCULATIONS PREPARED, SIGNED & SEALED BY AN ENGINEER REGISTERED IN THE LOCATION THE PROJECT IS LOCATED. THE CALCULATIONS SHALL DEMONSTRATE THAT THE SUBSTITUTED PRODUCT IS CAPABLE OF ACHIEVING THE EQUIVALENT MINIMUM PERFORMANCE VALUES OF THE SPECIFIED PRODUCT USING THE APPROPRIATE DESIGN PROCEDURE AND/OR STANDARD(S) AS REQUIRED BY THE BUILDING CODE.

P3. INSTALL ANCHORS PER THE MANUFACTURER INSTRUCTIONS, AS INCLUDED IN THE ANCHOR PACKAGING.

P4. ALL INSTALLERS SHALL BE CERTIFIED BY THE MANUFACTURER FOR INSTALLATION OF THE SPECIFIED ANCHOR SYSTEM OR THE CONTRACTOR SHALL ARRANGE AN ANCHOR MANUFACTURERS REPRESENTATIVE TO PROVIDE ONSITE INSTALLATION TRAINING FOR ALL OF THEIR ANCHORING PRODUCTS SPECIFIED. THE STRUCTURAL ENGINEER OF RECORD MUST RECEIVE DOCUMENTED CONFIRMATION THAT ALL OF THE CONTRACTOR'S PERSONNEL WHO INSTALL ANCHORS ARE TRAINED PRIOR TO THE COMMENCEMENT OF INSTALLING ANCHORS.

P5. ANCHOR CAPACITY IS DEPENDANT UPON SPACING BETWEEN ADJACENT ANCHORS AND PROXIMITY OF ANCHORS TO EDGE OF CONCRETE. INSTALL ANCHORS IN ACCORDANCE WITH SPACING AND EDGE CLEARANCES INDICATED ON THE DRAWINGS.

P6. EXISTING REINFORCING BARS IN THE CONCRETE STRUCTURE MAY CONFLICT WITH SPECIFIC ANCHOR LOCATIONS. UNLESS NOTED ON THE DRAWINGS THAT THE BARS CAN BE CUT, THE CONTRACTOR SHALL REVIEW THE EXISTING STRUCTURAL DRAWINGS AND SHALL UNDERTAKE TO LOCATE THE POSITION OF THE REINFORCING BARS AT THE LOCATIONS OF THE CONCRETE ANCHORS, BY HILTI FERROSCAN, GPR, X-RAY, CHIPPING OR OTHER ACCEPTABLE MEANS.

SOIL FILL NOTES

FILL PLACEMENT AND COMPACTION


1. UNDERCUT AREAS AND/OR AREAS REQUIRING FILL, SHALL BE RAISED TO THE DESIGN SUBGRADE ELEVATION WITH MATERIALS WITH THE FOLLOWING MINIMUM REQUIREMENTS:
   A. FILL SHALL BE FREE OF DELETERIOUS MATERIALS AND ROCK FRAGMENTS GREATER THAN 4 IN. IN DIAMETER.
   B. UNIFORMLY SPREAD IN 6- TO 8-IN. THICK LOOSE LIFTS;
   C. COMPACTED AT LEAST 98 PERCENT OF THE SOIL'S MAXIMUM DRY DENSITY WITHIN THE STRUCTURE PAD, OTHER STRUCTURAL AREAS, AND ALL PARKING/DRIVE AREAS AND 95% OF SOILS MAXIMUM DRY DENSITY WITHIN NON-STRUCTURAL AREAS, AS DETERMINED BY A LABORATORY STANDARD PROCTOR COMPACTION TEST (ASTM D-698); AND,
   D. THE MOISTURE CONTENT SHALL BE CONTROLLED AT PLUS TO MINUS 2 PERCENT OF OPTIMUM.
2. OBSERVATION OF THE FILL PLACEMENT AND IN-PLACE DENSITY TESTING SHALL BE PERFORMED ON STRUCTURAL SOIL FILL AS A CHECK THAT THE PREVIOUSLY RECOMMENDED COMPACTION CRITERIA HAVE BEEN ACHIEVED. THIS ALLOWS THE ENGINEER TO MONITOR THE QUALITY OF THE FILL CONSTRUCTION AND ASSESS THAT THE DESIGN CRITERION IS BEING ACHIEVED IN THE FIELD. TESTS SHALL BE PERFORMED AT VERTICAL INTERVALS OF 8-INCHES OR LESS (THE MAXIMUM RECOMMENDED LIFT THICKNESS) AS THE FILL IS BEING PLACED.

USE OF EXCAVATED SOILS AS FILL


BASED ON THE RESULTS OF THE EXPLORATION AND LABORATORY TESTING, THE ON-SITE SOILS ARE ADEQUATE FOR USE AS STRUCTURAL SOIL FILL. THE MOISTURE CONTENT OF THESE SOILS WILL FLUCTUATE WITH PREVAILING WEATHER CONDITIONS PRIOR TO AND AT THE TIME OF GRADING. IF THE SOILS ARE STOCKPILED, THEY SHALL BE PROTECTED FROM PRECIPITATION. SOME MOISTURE ADJUSTMENT (WETTING OR DRYING) COULD BE REQUIRED TO ACHIEVE THE RECOMMENDED DEGREE OF COMPACTION AT THE TIME OF PLACEMENT. PRIOR TO USE AS FILL, NATURAL SOILS SHALL BE EVALUATED BY THE GEOTECHNICAL ENGINEER TO ASSESS THE ADEQUACY FOR USE. SOILS CONTAINING ORGANIC MATTER SHALL NOT BE USED IN STRUCTURAL FILL AREAS. ORGANIC LADEN SOILS SHALL BE WASTED OFF-SITE OR PLACED IN ANY NON-STRUCTURAL GREEN AREAS.

USE OF IMPORTED SOILS AS FILL

IMPORTED FILL USED FOR SITE GRADING SHALL CONSIST OF A CLEAN (FREE OF ORGANICS AND DEBRIS), LOW PLASTICITY SOIL (LIQUID LIMIT LESS THAN 50, PLASTICITY INDEX LESS THAN 25) WITH MOIST (TOTAL) UNIT WEIGHT OF AT LEAST 100 PCF AND BE EVALUATED BY A GEOTECHNICAL ENGINEER PRIOR TO USE. DEPENDING ON SUBGRADE STABILITY AND THE AMOUNT OF BORROW MATERIAL NEEDED, CRUSHED STONE, SUCH AS INDOT NO. 53 CRUSHED LIMESTONE (#53), COULD BE REQUIRED.

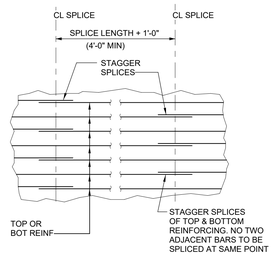

TYPICAL REINFORCEMENT SPLICE DETAIL

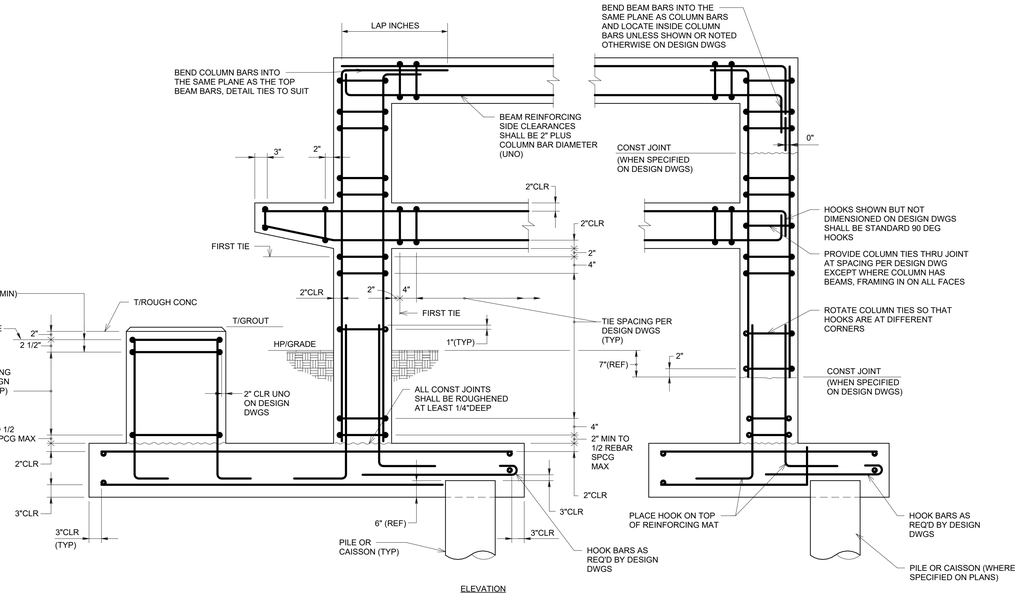

ELEVATION


TYPICAL REINFORCEMENT CLEARANCES AND PLACEMENT DETAILS

TENSION LAP SPLICE LENGTHS (INCHES) CLASS B (ACI 318-11)

BAR SIZE	MIN CONC COVER TO OUTSIDE OF BAR	MIN C/C BAR SPA	TOP HORIZ. BARS PLACED OVER 12" OF FRESH CONCRETE	ALL OTHER BARS
#3	1"	2"	13"	12"
	1 1/2"	2"	13"	12"
	2"	2"	13"	12"
#4	1"	2 1/2"	18"	14"
	1 1/2"	2 1/2"	18"	14"
	2"	2 1/2"	18"	14"
#5	1"	2 3/4"	26"	20"
	1 1/2"	3 1/4"	22"	17"
	2"	3 1/4"	22"	17"
#6	1"	2 3/4"	36"	28"
	1 1/2"	3 3/4"	26"	20"
	2"	3 3/4"	26"	20"
#7	1"	3"	58"	45"
	1 1/2"	4"	43"	33"
	2"	4 1/2"	38"	29"
#8	1"	3"	72"	56"
	1 1/2"	4"	54"	42"
	2"	5"	44"	34"
#9	1"	3 1/4"	88"	65"
	1 1/2"	4 1/4"	67"	52"
	2"	5 1/4"	54"	42"
#10	1"	3 1/2"	107"	82"
	1 1/2"	4 1/2"	82"	63"
	2"	5 1/2"	66"	51"
#11	1"	3 1/2"	126"	97"
	1 1/2"	4 1/2"	97"	75"
	2"	5 1/2"	80"	61"

NOTES:
1. CONCRETE - NORMAL WEIGHT
2. REINFORCING - GRADE 60
3. FOR CLASS A SPLICE LENGTHS AND COMPRESSION SPLICE LENGTHS REFER TO PLANS AND DETAILS
4. FOR RESTRICTIONS SEE ACI 318

STANDARD HOOK DETAILS

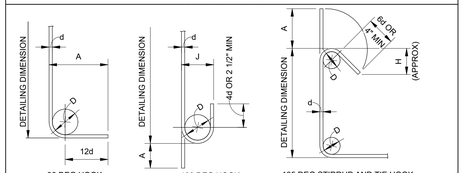

BAR SIZE	90 DEG HOOKS D	90 DEG HOOKS A	180 DEG HOOKS J	180 DEG HOOKS A	135 DEG HOOKS BAR SIZE	135 DEG HOOKS D	135 DEG HOOKS A	135 DEG HOOKS H (APPROX)
#3	2 1/4"	6"	3"	5"	#3	1 1/2"	4"	2 1/2"
#4	3"	8"	4"	6"	#4	2"	4 1/2"	3"
#5	3 3/4"	10"	5"	7"	#5	2 1/2"	5 1/2"	3 3/4"
#6	4 1/2"	1'-0"	6"	8"	#6	4 1/2"	8"	4 1/2"
#7	5 1/4"	1'-2"	7"	10"	#7	5 1/4"	9"	5 1/4"
#8	6"	1'-4"	8"	11"	#8	6"	10 1/2"	6"
#9	9 1/2"	1'-7"	11 3/4"	1'-3"	-	-	-	-
#10	10 3/4"	1'-10"	1'-1 1/4"	1'-5"	-	-	-	-
#11	1'-0"	2'-0"	1'-2 3/4"	1'-7"	-	-	-	-

NOTES:

1. FOR GENERAL NOTES, DESIGN CRITERIA, AND STANDARDS, REFER TO DRAWING LP1Y-SF-0009P001.

RYNE M. FIORITO REGISTERED PE12100177 STATE OF INDIANA PROFESSIONAL ENGINEER

A1- DATA COMPLETE - NO COMMENTS - DO NOT RESUBMIT
Authorization to proceed does not relieve Contractor/Supplier of its responsibility or liability under the Contract and or Purchase Order.
By dac54131 at Apr 06, 2026

HANSON™
HANSON PROFESSIONAL SERVICES, INC.
www.hanson-inc.com
Offices Nationwide
11931 Wickchester Lane, Suite 370
Houston, TX 77043
(346) 297-1720

REV	DATE	DES	ENG	CHK	APP	PM APP
1	03-APR-2026	RKN	SJS	FCB	RMF	SS
0	20-FEB-2026	RKN	SJS	FCB	RMF	SS
B	14-NOV-2025	RKN	SJS	FCB	FCB	SS
A	10-OCT-2025	RKN	SJS	FCB	RMF	SS

Lilly

STRUCTURAL CONC CRITERIA AND REINF DETAILS

RAIL UNLOADING RACK

REV	ZONE	PROJECT NUMBER / DESCRIPTION	CHANGE CONTROL	DATE
1		ISSUED FOR CONSTRUCTION		03-APR-2026
0		ISSUED FOR CONSTRUCTION		20-FEB-2026
B		ISSUED FOR REVIEW		14-NOV-2025
A		ISSUED FOR REVIEW		10-OCT-2025

REVISIONS

CONFIDENTIAL INFORMATION

THIS DRAWING AND THE IDEAS AND DESIGNS SHOWN THEREON ARE THE EXCLUSIVE PROPERTY OF ELI LILLY AND COMPANY AND ARE NOT TO BE USED, REPRODUCED OR DISCLOSED, EITHER IN WHOLE OR IN PART, WITHOUT THE WRITTEN CONSENT OF ELI LILLY AND COMPANY.

SYSTEM TYPE: NA			EDIFICE/BUILDING: UNLOADING RACK; LEVEL/FLOOR: NA
SUB DISCIPLINE: SF	LOCATION CODE: LP1	LOCATION/GRID: NA	CCI CODE: YELLOW; PROJECT NAME
CRITICAL QUALITY		ENTERPRISE GROUP: API	DRAWING INTENTION; DRAWING SCALE: NONE
CRITICAL BUSINESS		EQUIPMENT CLASSIFICATION: NA	ALTERNATE DOCUMENT ID: NA; MERIDIAN REV: 1
CRITICAL HSE		VENDOR: NA	DOCUMENT ID
NON-CRITICAL		ENGINEERING AGENCY DOC ID: NA	LP1Y-SF-0009P003

IF YOU ARE USING A PRINTED COPY OF THIS DOCUMENT, IT IS AN UNCONTROLLED PRINT. CONFIRM WITH THE OFFICIAL "ELECTRONIC RECORD" DOCUMENT IN THE GLOBAL ENGINEERING CONTENT MANAGEMENT SYSTEM.

IF YOU ARE USING A PRINTED COPY OF THIS DOCUMENT, IT IS AN UNCONTROLLED PRINT. CONFIRM WITH THE OFFICIAL "ELECTRONIC RECORD" DOCUMENT IN THE GLOBAL ENGINEERING CONTENT MANAGEMENT SYSTEM.

BUILDING CODE : 2012 INTERNATIONAL BUILDING CODE

SCHEDULE OF SPECIAL INSPECTIONS

INSPECTION OF FABRICATORS

	VERIFICATION, INSPECTION, AND TEST	GENERAL REQUIREMENTS REFERENCED STANDARD	SERVICES	EXTENT / FREQUENCY	COMMENTS	AGENT	DATE COMPLETE
1.	VERIFY FABRICATION/QUALITY CONTROL PROCEDURES. VERIFICATION AND INSPECTIONS SHALL BE PERFORMED IN ACCORDANCE WITH AISC 360, CHAPTER N, QUALITY CONTROL AND QUALITY ASSURANCE		IN-PLANT	PERIODIC			
2.	REVIEW FABRICATOR'S AISC CERTIFICATION		IN-PLANT	SUBMITTAL / ONCE			
3.	REVIEW CONSTRUCTION DOCUMENTS.	AISC 360: CHAP. N, SECT. N2 AND N3	IN-PLANT	EACH SUBMITTAL			
4.	REVIEW MATERIAL VERIFICATION	AISC 360: CHAP. N, SECT N5	IN-PLANT	PERIODIC			
5.	STRUCTURAL STEEL WELDING						
	A. INSPECTION PRIOR TO WELDING	AISC 360: CHAP. N, SECT. N5.4 AND TABLE C-N5.4-1	IN-PLANT	PERIODIC			
	B. INSPECTION DURING WELDING	AISC 360: CHAP. N, SECT. N5.4 AND TABLE C-N5.4-2	IN-PLANT	PERIODIC			
	C. INSPECTION AFTER WELDING	AISC 360: CHAP. N, SECT. N5.4 AND TABLE C-N5.4-3	IN-PLANT	PERIODIC			

INSPECTION OF FABRICATORS

	VERIFICATION, INSPECTION, AND TEST	GENERAL REQUIREMENTS REFERENCED STANDARD	SERVICES	EXTENT / FREQUENCY	COMMENTS	AGENT	DATE COMPLETE
1.	VERIFY FABRICATOR AND ERECTOR DOCUMENTS ARE IN ACCORDANCE WITH THE REQUIREMENTS OF AISC 360, CHAPTER N, SECTION N3: FABRICATOR AND ERECTION DOCUMENTS.			INITIAL INSPECTION			
2.	VERIFY QUALIFICATIONS OF INSPECTION AND TESTING PERSONNEL ARE IN ACCORDANCE WITH THE REQUIREMENTS OF AISC 360, CHAPTER N, SECTION N4: INSPECTION AND NON-DESTRUCTIVE TESTING PERSONNEL.			INITIAL INSPECTION			
3.	VERIFY MATERIAL CONTROL AND IDENTIFICATION PROCEDURES ARE IN ACCORDANCE WITH THE REQUIREMENTS OF AISC 360, CHAPTER N, SECTION N5: MINIMUM REQUIREMENTS FOR INSPECTION OF STRUCTURAL STEEL BUILDINGS, SUBSECTION 2: QUALITY ASSURANCE.			INITIAL INSPECTION			
4.	INSPECTION OF WELDING						
	INSPECT WELDING OPERATIONS AND COMPLETED WELDS ACCORDING TO THE REQUIREMENTS OF AISC 360, CHAPTER N, SECTION N5: MINIMUM REQUIREMENTS FOR INSPECTION OF STRUCTURAL STEEL BUILDINGS, SUBSECTION 4: INSPECTION OF WELDING.						
	A. INSPECTION TASKS PRIOR TO WELDING						
	1. WELDING PROCEDURE SPECIFICATIONS (WPSs) AVAILABLE	AISC 360 TABLE C-N.5.4-1:	IN-FIELD	CONTINUOUS			
	2. MANUFACTURER CERTIFICATIONS FOR WELDING CONSUMABLES AVAILABLE.	AISC 360 TABLE C-N.5.4-1:	IN-FIELD	CONTINUOUS			
	3. MATERIAL IDENTIFICATION (TYPE / GRADE)	AISC 360 TABLE C-N.5.4-1:	IN-FIELD	PERIODIC			
	4. WELDER IDENTIFICATION SYSTEM	AISC 360 TABLE C-N.5.4-1:	IN-FIELD	PERIODIC			
	5. FIT-UP OF GROOVE WELDS (INCLUDING JOINT GEOMETRY)	AISC 360 TABLE C-N.5.4-1:	IN-FIELD	PERIODIC			
	JOINT PREPARATION						
	DIMENSION (ALIGNMENT, ROOT OPENING, ROOT FACE, BEVEL)						
	CLEANLINESS (CONDITION OF STEEL SURFACES)						
	TACKING (TACK WELD QUALITY AND LOCATION)						
	BACKING TYPE AND FIT)IF APPLICABLE)						
	6. CONFIGURATION AND FINISH OF ACCESS HOLES	AISC 360 TABLE C-N.5.4-1:	IN-FIELD	PERIODIC			
	7. FIT-UP OF FILLET WELDS	AISC 360 TABLE C-N.5.4-1:	IN-FIELD	PERIODIC			
	DIMENSIONS (ALIGNMENT, GAPS AT ROOT)						
	CLEANLINESS (CONDITION OF STEEL SURFACES)						
	TACKING (TACK WELD QUALITY AND LOCATION)						
	8. CHECKING WELDING EQUIPMENT	AISC 360 TABLE C-N.5.4-1:	IN-FIELD	PERIODIC			
	B. INSPECTION TASKS DURING WELDING						
	1. USE OF QUALIFIED WELDERS	AISC 360 TABLE C-N.5.4-2:	IN-FIELD	PERIODIC			
	2. CONTROL AND HANDLING OF WELDING CONSUMABLES	AISC 360 TABLE C-N.5.4-2:	IN-FIELD	PERIODIC			
	PACKAGING						
	EXPOSURE CONTROL						
	3. NO WELDING OVER CRACKED TACK WELDS	AISC 360 TABLE C-N.5.4-2:	IN-FIELD	PERIODIC			
	4. ENVIRONMENTAL CONDITIONS	AISC 360 TABLE C-N.5.4-2:	IN-FIELD	PERIODIC			
	WIND SPEED WITHIN LIMITS						
	PRECIPITATION AND TEMPERATURE						
	5. WPS FOLLOWED	AISC 360 TABLE C-N.5.4-2:	IN-FIELD	PERIODIC			
	SETTINGS ON WELDING EQUIPMENT						
	TRAVEL SPEED						
	SELECTED WELDING MATERIALS						
	SHIELDING GAS TYPE / FLOW RATE						
	PREHEAT APPLIED						
	INTERPASS TEMPERATURE MAINTAINED (MIN. / MAX.)						
	PROPER POSITION (F, V, H, OH)						
	6. WELDING TECHNIQUES	AISC 360 TABLE C-N.5.4-2:	IN-FIELD	PERIODIC			
	INTERPASS AND FINAL CLEANING						
	EACH PASS WITHIN PROFILE LIMITATIONS						
	EACH PASS MEETS QUALITY REQUIREMENTS						
	C. INSPECTION TASKS AFTER WELDING						
	1. WELDS CLEANED	AISC 360 TABLE C-N.5.4-3:	IN-FIELD	PERIODIC			
	2. SIZE, LENGTH AND LOCATION OF WELDS	AISC 360 TABLE C-N.5.4-3:	IN-FIELD	CONTINUOUS			
	3. WELDS MEET VISUAL ACCEPTANCE CRITERIA	AISC 360 TABLE C-N.5.4-3:	IN-FIELD	PERIODIC			
	CRACK PROHIBITION						
	WELD / BASE-METAL FUSION						
	CRATER CROSS SECTION						
	WELD PROFILES						
	WELD SIZE						
	UNDERCUT						
	POROSITY						
	4. ARC STRIKES	AISC 360 TABLE C-N.5.4-3:	IN-FIELD	CONTINUOUS			
	5. K-AREA	AISC 360 TABLE C-N.5.4-3:	IN-FIELD	CONTINUOUS			
	6. BACKING REMOVED AND WELD TABS REMOVED (IF REQUIRED)	AISC 360 TABLE C-N.5.4-3:	IN-FIELD	CONTINUOUS			
	7. REPAIR ACTIVITIES	AISC 360 TABLE C-N.5.4-3:	IN-FIELD	CONTINUOUS			
	8. DOCUMENT ACCEPTANCE OR REJECTION OF WELDED JOINT OR MEMBER	AISC 360 TABLE C-N.5.4-3:	IN-FIELD	CONTINUOUS			
5.	NONDESTRUCTIVE TESTING OF WELDED JOINTS						
	VERIFY NONDESTRUCTIVE TESTING HAS BEEN PERFORMED IN ACCORDANCE WITH THE REQUIREMENTS OF AISC 360, CHAPTER N, SECTION N5: MINIMUM REQUIREMENTS FOR INSPECTION OF STRUCTURAL STEEL BUILDINGS, SUBSECTION 5: NONDESTRUCTIVE TESTING OF WELDED JOINTS AND AS SPECIFIED IN THE CONTRACT DOCUMENTS.	AISC 360: N5.5	IN-FIELD	PERIODIC			

FREQUENCY OF INSPECTIONS SHALL BE AS DESCRIBED IN THE AISC SECTION REFERENCE. INITIAL INSPECTIONS SHALL HAVE INCREASED LEVELS OF OBSERVATION. WHERE APPROPRIATE LEVELS OF QUALITY CONTROL ARE DEMONSTRATED, THE LEVEL OF OBSERVATIONS MAY BE REDUCED WITH THE APPROVAL OF THE STRUCTURAL ENGINEER OF RECORD.

B1LG-00-K215-00006-3_LP1Y-SF-0009P004.pdf

NOTES:

1. FOR GENERAL NOTES, DESIGN CRITERIA, AND STANDARDS, REFER TO DRAWING LP1Y-SF-0009P001.
2. SPECIAL INSPECTIONS SHALL BE PERFORMED AS REQUIRED BY THE ENGINEER OF RECORD.

SPECIAL INSPECTION NOTES:

1. THE OWNER OR THE OWNER'S AUTHORIZED AGENT SHALL ENGAGE A SPECIAL INSPECTOR(S) FOR SPECIAL INSPECTION WORK REQUIRED BY THE SCHEDULE OF SPECIAL INSPECTIONS ON THIS DRAWING.
2. THE SPECIAL INSPECTOR SHALL PROVIDE SPECIAL INSPECTIONS, TESTING, REPORTING, AND COMPLIANCE PROCEDURES IN ACCORDANCE WITH THE SCHEDULE OF SPECIAL INSPECTIONS ON THIS DRAWING.
3. THE SPECIAL INSPECTOR(S) SHALL BE QUALIFIED AS FOLLOWS: THE SPECIAL INSPECTOR SHALL PROVIDE WRITTEN DOCUMENTATION TO THE EOR DEMONSTRATING THEIR COMPETENCE AND RELEVANT EXPERIENCE OR TRAINING. EXPERIENCE OR TRAINING SHALL BE CONSIDERED RELEVANT WHEN THE DOCUMENTED EXPERIENCE OR TRAINING IS RELATED IN COMPLEXITY TO THE SAME TYPE OF SPECIAL INSPECTION ACTIVITIES FOR PROJECTS OF SIMILAR COMPLEXITY AND MATERIAL QUALITIES. THESE QUALIFICATIONS AND IN ADDITION TO QUALIFICATIONS SPECIFIED IN RELEVANT SECTIONS OF THE 2012 IBC.
4. DUTIES OF THE SPECIAL INSPECTOR(S) INCLUDE, BUT ARE NOT LIMITED TO:
   A. PROVIDE THE INSPECTION SERVICES DEFINED IN THE SCHEDULE OF SPECIAL INSPECTIONS ON THIS DRAWING.
   B. OBSERVE THE WORK FOR CONFORMANCE WITH THE APPROVED CONSTRUCTION DOCUMENTS AND SPECIFICATIONS, BRINGING ANY DISCREPANCIES TO THE IMMEDIATE ATTENTION OF THE GENERAL CONTRACTOR FOR CORRECTION. IF UNCORRECTED, THE ENGINEER OF RECORD AND BUILDING OFFICIAL ARE TO BE NOTIFIED.
   C. REPORTING FOR SPECIAL INSPECTIONS AND TESTING SHALL BE COMPLETED AT THE END OF EACH WEEK. A COPY OF THE SPECIAL INSPECTOR'S WEEKLY REPORTS SHALL BE SUBMITTED TO THE ENGINEER OF RECORD FOR REVIEW AT THE END OF EACH WEEK. A FINAL REPORT SHALL BE COMPILED AT THE END OF THE PROJECT AND SEALED BY A PE REPRESENTING THE SPECIAL INSPECTION COMPANY. REPORTS ARE TO BE SUBMITTED TO THE BUILDING OFFICIAL, CLIENT, AND DESIGN PROFESSIONAL IN RESPONSIBLE CHARGE.
   D. THE SPECIAL INSPECTOR IS TO KEEP A DISCREPANCY LOG, DOCUMENTING ITEMS THAT DID NOT MEET APPROVED CONSTRUCTION DOCUMENT REQUIREMENTS, AND HOW/WHEN IT WAS CORRECTED. LOG SHALL BE SUBMITTED WITH INSPECTION REPORTS.
5. DUTIES OF THE GENERAL CONTRACTOR OR CONSTRUCTION MANAGER INCLUDE, BUT ARE NOT LIMITED TO:
   A. NOTIFY SPECIAL INSPECTOR THAT WORK IS READY FOR INSPECTION PRIOR TO WORK BEING PERFORMED.
   B. COOPERATE WITH THE SPECIAL INSPECTOR(S) BY PROVIDING ACCESS TO WORK, MATERIAL FOR SAMPLES AND TIME FOR INSPECTIONS.
   C. PROVIDE SPECIAL INSPECTOR(S) WITH ACCESS TO APPROVED CONSTRUCTION DOCUMENTS AND SPECIFICATIONS AT THE JOB SITE.
   D. MAINTAIN JOB SITE COPIES OF ALL REPORTS SUBMITTED BY THE SPECIAL INSPECTOR(S).
6. DEFINITIONS:
   A. CONTINUOUS SPECIAL INSPECTION - SPECIAL INSPECTION BY THE SPECIAL INSPECTOR WHO IS PRESENT AND WHERE THE WORK IS BEING PERFORMED.
   B. PERIODIC SPECIAL INSPECTION - SPECIAL INSPECTION BY THE SPECIAL INSPECTOR WHO IS INTERMITTENTLY PRESENT WHERE THE WORK TO BE INSPECTED HAS BEEN OR IS BEING PERFORMED.
   C. ONCE - THE SINGLE TIME OBSERVATION OF WORK REQUIRING SPECIAL INSPECTION BY AN APPROVED SPECIAL INSPECTOR WHO IS PRESENT IN THE AREA WHERE THE WORK HAS BEEN OR IS BEING PERFORMED.
7. AT PROJECT COMPLETION, EACH SUBCONTRACTOR SHALL PROVIDE LETTER CONFIRMING CONSTRUCTION IS PER DRAWINGS AND SPECIFICATIONS.

A1 - DATA COMPLETE - NO COMMENTS - DO NOT RESUBMIT

Authorization to proceed does not relieve Contractor/Supplier of its responsibility or liability under the Contract and or Purchase Order.

By: Ricardo DaCosta dac54131 March 12, 2026

RYNE M. FIORITO REGISTERED PE12100177 STATE OF INDIANA PROFESSIONAL ENGINEER

HANSON™

HANSON PROFESSIONAL SERVICES, INC.
www.hanson-inc.com
Offices Nationwide
11931 Wickchester Lane, Suite 370
Houston, TX 77043
(346) 297-1720

REV	DATE	DES	ENG	CHK	APP	PM APP
0	20-FEB-2026	RKN	SJS	FCB	RMF	SS
B	14-NOV-2025	RKN	SJS	FCB	FCB	SS
A	10-OCT-2025	RKN	SJS	FCB	RMF	SS

Lilly

STRUCTURAL SPECIAL INSPECTION SHEET
SHEET 1 OF 3
RAIL UNLOADING RACK

REV	ZONE	PROJECT NUMBER / DESCRIPTION	CHANGE CONTROL	DATE
0		ISSUED FOR CONSTRUCTION		20-FEB-2026
B		ISSUED FOR REVIEW		14-NOV-2025
A		ISSUED FOR REVIEW		10-OCT-2025

REVISIONS

CONFIDENTIAL INFORMATION
THIS DRAWING AND THE IDEAS AND DESIGNS SHOWN THEREON ARE THE EXCLUSIVE PROPERTY OF ELI LILLY AND COMPANY AND ARE NOT TO BE USED, REPRODUCED OR DISCLOSED, EITHER IN WHOLE OR IN PART, WITHOUT THE WRITTEN CONSENT OF ELI LILLY AND COMPANY.

SYSTEM TYPE: NA		EDIFICE/BUILDING: UNLOADING RACK	LEVEL/FLOOR: NA
SUB DISCIPLINE: SF	LOCATION CODE: LP1	LOCATION/GRID: NA	CCI CODE: YELLOW
PROJECT NAME			
CRITICAL QUALITY	ENTERPRISE GROUP: API	DRAWING INTENTION	DRAWING SCALE: NONE
CRITICAL BUSINESS	EQUIPMENT CLASSIFICATION: NA	ALTERNATE DOCUMENT ID: NA	MERIDIAN REV: 0
CRITICAL HSE	VENDOR: NA	DOCUMENT ID	
NON-CRITICAL	ENGINEERING AGENCY DOC ID: NA	LP1Y-SF-0009P004	

IF YOU ARE USING A PRINTED COPY OF THIS DOCUMENT, IT IS AN UNCONTROLLED PRINT. CONFIRM WITH THE OFFICIAL "ELECTRONIC RECORD" DOCUMENT IN THE GLOBAL ENGINEERING CONTENT MANAGEMENT SYSTEM.

IF YOU ARE USING A PRINTED COPY OF THIS DOCUMENT, IT IS AN UNCONTROLLED PRINT. CONFIRM WITH THE OFFICIAL "ELECTRONIC RECORD" DOCUMENT IN THE GLOBAL ENGINEERING CONTENT MANAGEMENT SYSTEM.

B1LG-00-K215-00007-3_LP1Y-SF-0009P005.pdf

BUILDING CODE : 2012 INTERNATIONAL BUILDING CODE

SCHEDULE OF SPECIAL INSPECTIONS

INSPECTION OF FABRICATORS

			VERIFICATION, INSPECTION, AND TEST	GENERAL REQUIREMENTS REFERENCED STANDARD	SERVICES	EXTENT / FREQUENCY	COMMENTS	AGENT	DATE COMPLETE
	B.		COMPLETE JOINT PENETRATION (CJP) GROVE WELD						
		2.	ULTRASONIC TESTING (UT) ON CJP WELDS (RISK CATEGORY III OR IV)	AISC 360: N5.5B	IN-FIELD	CONTINUOUS	INSPECTOR SHALL NOTIFY THE STRUCTURAL ENGINEER OF RECORD OF ANY WELDER REQUIRING INCREASED INSPECTION DUE TO A CJP WELD FAILURE RATE OF MORE THAN 5%.		
	C.		BEAM COPE AND ACCESS HOLE						
		1.	THERMALLY CUT SURFACES OF BEAM COPES AND ACCESS HOLES SHALL BE TESTED USING MAGNETIC PARTICLE TESTING (MT) OR PENETRANT TESTING (PT), WHEN THE FLANGE THICKNESS EXCEEDS 2" FOR ROLL SHAPES, OR WHEN THE WEB THICKNESS EXCEEDS 2" FOR BUILT-UP SHAPES	AISC 360: N5.5C	IN-FIELD	CONTINUOUS			
6.			INSPECTION OF BOLTING						
			INSPECT BOLTING OPERATIONS AND ASSEMBLED CONNECTIONS ACCORDING TO THE REQUIREMENTS OF AISC 360, CHAPTER N, SECTION N5: MINIMUM REQUIREMENTS FOR INSPECTION OF STRUCTURAL STEEL BUILDINGS, SUBSECTION 6: INSPECTION OF HIGH-STRENGTH BOLTING AND RCSC, SECTION 9: INSPECTION.		IN-FIELD		REFER TO THE CONTRACT DOCUMENTS FOR THE IDENTIFICATION OF JOINT TYPES: SNUG-TIGHTENED JOINTS AND PRE-TENSIONED JOINTS.		
	A.		INSPECTION TASKS PRIOR TO BOLTING						
		1.	MANUFACTURER'S CERTIFICATION AVAILABLE FOR FASTENER MATERIALS.	AISC 360 TABLE C-N.5.6-1:	IN-FIELD	CONTINUOUS			
		2.	FASTENERS MARKED IN ACCORDANCE WITH ASTM REQUIREMENTS.	AISC 360 TABLE C-N.5.6-1:	IN-FIELD	PERIODIC			
		3.	PROPER FASTENERS SELECTED FOR THE JOINT DETAIL (GRADE, TYPE, BOLT LENGTH IF THREADS TO BE EXCLUDED FROM SHEAR PLANE)	AISC 360 TABLE C-N.5.6-1:	IN-FIELD	PERIODIC			
		4.	PROPER BOLTING PROCEDURE SELECTED FOR JOINT DETAIL	AISC 360 TABLE C-N.5.6-1:	IN-FIELD	PERIODIC			
		5.	CONNECTING ELEMENTS, INCLUDING THE APPROPRIATE FAYING SURFACE CONDITION AND HOLE PREPARATION, IF SPECIFIED, MEET APPLICABLE REQUIREMENTS.	AISC 360 TABLE C-N.5.6-1:	IN-FIELD	PERIODIC			
		6.	PRE-INSTALLATION VERIFICATION TESTING BY INSTALLATION PERSONNEL OBSERVED AND DOCUMENTED FOR FASTENER ASSEMBLIES AND METHODS USED.	AISC 360 TABLE C-N.5.6-1:	IN-FIELD	PERIODIC			
		7.	PROPER STORAGE PROVIDED FOR BOLTS, NUTS, WASHERS, AND OTHER FASTENER COMPONENTS.	AISC 360 TABLE C-N.5.6-1:	IN-FIELD	PERIODIC			
	B.		INSPECTION TASKS DURING BOLTING						
		1.	FASTENER ASSEMBLIES, OF SUITABLE CONDITION, PLACED IN ALL HOLES AND WASHERS (IF REQUIRED) ARE POSITIONED AS REQUIRED.	AISC 360 TABLE C-N.5.6-2:	IN-FIELD	PERIODIC			
		2.	JOINT BROUGHT TO THE SNUG-TIGHT CONDITION PRIOR TO THE PRETENSIONING OPERATION.	AISC 360 TABLE C-N.5.6-2:	IN-FIELD	PERIODIC			
		3.	FASTENER COMPONENT NOT TURNED BY THE WRENCH PREVENTED FROM ROTATING.	AISC 360 TABLE C-N.5.6-2:	IN-FIELD	PERIODIC			
		4.	FASTENERS ARE PRE-TENSIONED IN ACCORDANCE WITH A METHOD APPROVED BY RCSC AND PROGRESSING SYSTEMATICALLY FROM MOST RIGID POINT TOWARD FREE EDGES.	AISC 360 TABLE C-N.5.6-2:	IN-FIELD	PERIODIC			
	C.		INSPECTION TASKS AFTER BOLTING						
		1.	DOCUMENT ACCEPTANCE OR REJECTION OF BOLTED CONNECTIONS	AISC 360 TABLE C-N.5.6-3:	IN-FIELD	CONTINUOUS			
	D.		VERIFY PRE-TENSIONING METHOD IS APPROVED AND IN ACCORDANCE WITH THE CONTRACT DOCUMENTS.		IN-FIELD	CONTINUOUS			
7.			OTHER INSPECTION TASKS						
	A.		VERIFY AND INSPECT FABRICATED ASSEMBLIES AND STEEL FRAME ARE IN ACCORDANCE WITH THE DETAILS SHOWN ON THE CONSTRUCTION DOCUMENTS	AISC 360 SECTION N5.7	IN-FIELD	PERIODIC			
	B.		VERIFY AND INSPECT ANCHOR RODS (BOLTS) AND OTHER EMBEDMENTS SUPPORTING STRUCTURAL STEEL ARE IN ACCORDANCE WITH CONSTRUCTION DOCUMENTS.	AISC 360 SECTION N5.7	IN-FIELD	PERIODIC			
	C.		VERIFY MEMBER LOCATIONS, BRACES, STIFFENERS, AND PROPER APPLICATION OF JOINT DETAILS AT EACH CONNECTION ARE IN ACCORDANCE WITH CONSTRUCTION DOCUMENTS.	AISC 360 SECTION N5.7	IN-FIELD	PERIODIC			

CONCRETE CONSTRUCTION

			VERIFICATION, INSPECTION, AND TEST	GENERAL REQUIREMENTS REFERENCED STANDARD	SERVICES	EXTENT / FREQUENCY	COMMENTS	AGENT	DATE COMPLETE
1.			INSPECT REINFORCEMENT STEEL, INCLUDING PRE-STRESSING TENDONS. VERIFY MATERIAL GRADE, SIZE, CONDITION, AND PLACEMENT OF REINFORCING ARE IN ACCORDANCE WITH THE CONTRACT DOCUMENTS. BASIS FOR ACCEPTANCE OF REINFORCING SHALL BE AS SPECIFIED IN ACI 301: SPECIFICATIONS FOR STRUCTURAL CONCRETE.	ACI 301 AND ACI 318: 3.5, 7.1 - 7.7	IN-FIELD	PERIODIC			
2.			CAST-IN-PLACE ANCHORS	ACI 318: 8.1.3, 21.2.8					
	A.		VERIFY DIAMETER, GRADE, TYPE, LENGTH, EMBEDMENT AND PROJECTION OF ANCHORS. VERIFY ANCHOR FABRICATION IS IN ACCORDANCE WITH THE CONTRACT DOCUMENTS.		IN-FIELD	PERIODIC			
3.			CAST-IN-PLACE ANCHORS REQUIRING CONTINUOUS INSPECTION.						
	A.		VERIFY DIAMETER, GRADE, TYPE, LENGTH, EMBEDMENT AND PROJECTION OF ANCHORS. VERIFY ANCHOR FABRICATION IS IN ACCORDANCE WITH THE CONTRACT DOCUMENTS.		IN-FIELD	CONTINUOUS	WHERE INDICATED ON THE CONTRACT DOCUMENTS.		
4.			EMBEDDED ITEMS						
	A.		VERIFY DIAMETER, GRADE, TYPE AND LENGTH OF EMBEDDED ITEM.		IN-FIELD	PERIODIC			
5.			INSPECTION OF ANCHORS AND REINFORCING STEEL POST-INSTALLED IN HARDENED CONCRETE.	ACI 318: 3.8.6, 8.1.3, 21.2.8			WHERE INDICATED ON THE CONTRACT DOCUMENTS.		
			INSPECTIONS SHALL BE IN ACCORDANCE WITH THE MANUFACTURER`S RECOMMENDATIONS AND THE RESPECTIVE ICC REPORTS FOR THE ANCHORAGE INSTALLED.						
	A.		FOR ADHESIVE ANCHORS BOLTS AND REINFORCEMENT INSTALLED IN HORIZONTALLY AND UPWARDLY INCLINED ORIENTATIONS TO RESIST SUSTAIN TENSION LOADS, VERIFY ANCHOR MANUFACTURER, ANCHOR TYPE, ANCHOR DIMENSIONS, HOLE DRILLING, HOLE DIMENSIONS, HOLE CLEANING PROCEDURES, ANCHOR SPACING, ANCHOR EMBEDMENT AND TIGHTENING TORQUE.		IN-FIELD	CONTINUOUS			
	B.		FOR ANCHORS NOT DEFINED IN 6A ABOVE, VERIFY ANCHOR MANUFACTURER, ANCHOR TYPE, ANCHOR DIMENSIONS, HOLE DRILLING, HOLE DIMENSIONS, HOLE CLEANING PROCEDURES, ANCHOR SPACING, ANCHOR EMBEDMENT AND TIGHTENING TORQUE.		IN-FIELD	PERIODIC			
	C.		FOR REINFORCING, VERIFY MATERIAL, BAR SIZE, HOLE DRILLING, HOLE DIMENSIONS, HOLE CLEANING PROCEDURES, ANCHOR SPACING, EDGE DISTANCES, CONCRETE MINIMUM THICKNESS, AND EMBEDMENT.		IN-FIELD	PERIODIC			
6.			VERIFY USE OF APPROVED DESIGN MIX	AC1 318: CH 4, 5.2 - 5.4	IN-FIELD	PERIODIC			
7.			AT THE TIME FRESH CONCRETE IS SAMPLED TO FABRICATE SPECIMENS FOR STRENGTH TESTS, PERFORM SLUMP AND AIR CONTENT TESTS AND DETERMINE TEMPERATURE OF CONCRETE	ASTM C 172, ASTM C 31, ACI 318: 5.6, 5.8	IN-FIELD	CONTINUOUS			
8.			INSPECTION FOR MAINTENANCE OF SPECIFIED CURING TEMPERATURE AND TECHNIQUES	AC1 318: 5.11 - 5.13	IN-FIELD	PERIODIC			
9.			INSPECTION OF FRAMEWORK FOR SHAPE, LINES, LOCATION AND DIMENSIONS OF THE CONCRETE MEMBERS BEING FORMED.	ACI 301 AND ACI318: 6.1.1	IN-FIELD	PERIODIC			
10.			CONCRETE STRENGTH TESTING AND VERIFICATION OF COMPLIANCE WITH CONSTRUCTION DOCUMENTS		IN-FIELD	PERIODIC			

SOILS

			VERIFICATION, INSPECTION, AND TEST	GENERAL REQUIREMENTS REFERENCED STANDARD	SERVICES	EXTENT / FREQUENCY	COMMENTS	AGENT	DATE COMPLETE
1.			VERIFY MATERIALS BELOW SHALLOW FOUNDATIONS ARE ADEQUATE TO ACHIEVE THE DESIGN BEARING CAPACITY AS PROVIDED ON THE CONTRACT DOCUMENTS		IN-FIELD	PERIODIC			
2.			VERIFY EXCAVATIONS ARE EXTENDED TO PROPER DEPTH AND HAVE REACHED PROPER MATERIAL.		IN-FIELD	PERIODIC			
3.			PERFORM CLASSIFICATION AND TESTING OF CONTROLLED FILL MATERIALS.		IN-FIELD	PERIODIC			
4.			VERIFY USE OF PROPER MATERIALS, DENSITIES, AND LIFT THICKNESS DURING PLACEMENT AND COMPACTION OF CONTROLLED FILL		IN-FIELD	CONTINUOUS			
5.			PRIOR TO PLACEMENT OF CONTROLLED FILL, OBSERVE SUBGRADE AND VERIFY THAT SITE HAS BEEN PREPARED PROPERLY.		IN-FIELD	PERIODIC			

NOTES:

1. FOR GENERAL NOTES, DESIGN CRITERIA, AND STANDARDS, REFER TO DRAWING LP1Y-SF-0009P001.
2. REFER TO SPECIAL INSPECTION NOTES ON DRAWING LP1Y-SF-0009P004.

A1 - DATA COMPLETE - NO COMMENTS - DO NOT RESUBMIT

Authorization to proceed does not relieve Contractor/Supplier of its responsibility or liability under the Contract and or Purchase Order.

By: Ricardo DaCosta dac54131 March 12, 2026

RYNE M. FIORITO REGISTERED PE12100177 STATE OF INDIANA PROFESSIONAL ENGINEER

HANSON

HANSON PROFESSIONAL SERVICES, INC.
www.hanson-inc.com
Offices Nationwide

11931 Wickchester Lane, Suite 370
Houston, TX 77043
(346) 297-1720

REV	DATE	DES	ENG	CHK	APP	PM APP
2	20-FEB-2026	RKN	SJS	FCB	RMF	SS
B	14-NOV-2025	RKN	SJS	FCB	FCB	SS
A	10-OCT-2025	RKN	SJS	FCB	RMF	SS

Lilly

STRUCTURAL SPECIAL INSPECTION SHEET
SHEET 2 OF 3
RAIL UNLOADING RACK

REV	ZONE	PROJECT NUMBER / DESCRIPTION	CHANGE CONTROL	DATE
2		ISSUED FOR CONSTRUCTION		20-FEB-2026
B		ISSUED FOR REVIEW		14-NOV-2025
A		ISSUED FOR REVIEW		10-OCT-2025

REVISIONS

SYSTEM TYPE: NA		EDIFICE/BUILDING: UNLOADING RACK	LEVEL/FLOOR: NA
SUB DISCIPLINE: SF	LOCATION CODE: LP1	LOCATION/GRID: NA	CCI CODE: YELLOW
CRITICAL QUALITY:		ENTERPRISE GROUP: API	PROJECT NAME:
CRITICAL BUSINESS:		EQUIPMENT CLASSIFICATION: NA	DRAWING INTENTION:
CRITICAL HSE:		VENDOR: NA	DRAWING SCALE: NONE
NON-CRITICAL:		ENGINEERING AGENCY DOC ID: NA	ALTERNATE DOCUMENT ID: NA
			MERIDIAN REV: 0
			DOCUMENT ID: LP1Y-SF-0009P005

CONFIDENTIAL INFORMATION
THIS DRAWING AND THE IDEAS AND DESIGNS SHOWN THEREON ARE THE EXCLUSIVE PROPERTY OF ELI LILLY AND COMPANY AND ARE NOT TO BE USED, REPRODUCED OR DISCLOSED, EITHER IN WHOLE OR IN PART, WITHOUT THE WRITTEN CONSENT OF ELI LILLY AND COMPANY.

IF YOU ARE USING A PRINTED COPY OF THIS DOCUMENT, IT IS AN UNCONTROLLED PRINT. CONFIRM WITH THE OFFICIAL "ELECTRONIC RECORD" DOCUMENT IN THE GLOBAL ENGINEERING CONTENT MANAGEMENT SYSTEM.

IF YOU ARE USING A PRINTED COPY OF THIS DOCUMENT, IT IS AN UNCONTROLLED PRINT. CONFIRM WITH THE OFFICIAL "ELECTRONIC RECORD" DOCUMENT IN THE GLOBAL ENGINEERING CONTENT MANAGEMENT SYSTEM.

B1LG-00-K215-00008-3_LP1Y-SF-0009P006.pdf

BUILDING CODE : 2012 INTERNATIONAL BUILDING CODE

SCHEDULE OF SPECIAL INSPECTIONS

WIND-RESISTING COMPONENTS

		VERIFICATION, INSPECTION, AND TEST	SERVICES	EXTENT / FREQUENCY	COMMENTS	AGENT	DATE COMPLETE
1.		ROOF CLADDING, ROOF DECK AND ROOF FRAMING CONNECTIONS					
	A.	VERIFY MATERIAL TYPE, GAGE, FASTENER TYPE AND SPACING ARE IN ACCORDANCE WITH THE CONTRACT DOCUMENTS.	IN-FIELD	PERIODIC			

NOTES:

1. FOR GENERAL NOTES, DESIGN CRITERIA, AND STANDARDS, REFER TO DRAWING LP1Y-SF-0009P001.
2. REFER TO SPECIAL INSPECTION NOTES ON DRAWING LP1Y-SF-0009P004.

A1 - DATA COMPLETE - NO COMMENTS - DO NOT RESUBMIT

Authorization to proceed does not relieve Contractor/Supplier of its responsibility or liability under the Contract and or Purchase Order.

By: Ricardo DaCosta dac54131 March 12, 2026

RYNE M. FIORITO REGISTERED PE12100177 STATE OF INDIANA PROFESSIONAL ENGINEER

REV	ZONE	PROJECT NUMBER / DESCRIPTION	CHANGE CONTROL	DATE
0		ISSUED FOR CONSTRUCTION		20-FEB-2026
B		ISSUED FOR REVIEW		14-NOV-2025
A		ISSUED FOR REVIEW		10-OCT-2025

REVISIONS

CONFIDENTIAL INFORMATION
THIS DRAWING AND THE IDEAS AND DESIGNS SHOWN THEREON ARE THE EXCLUSIVE PROPERTY OF ELI LILLY AND COMPANY AND ARE NOT TO BE USED, REPRODUCED OR DISCLOSED, EITHER IN WHOLE OR IN PART, WITHOUT THE WRITTEN CONSENT OF ELI LILLY AND COMPANY.

HANSON™
HANSON PROFESSIONAL SERVICES, INC.
www.hanson-inc.com
Offices Nationwide
11931 Wickchester Lane, Suite 370
Houston, TX 77043
(346) 297-1720

REV	DATE	DES	ENG	CHK	APP	PM APP
2	20-FEB-2026	RKN	SJS	FCB	RMF	SS
1	14-NOV-2025	RKN	SJS	FCB	FCB	SS
0	10-OCT-2025	RKN	SJS	FCB	RMF	SS

Lilly

STRUCTURAL SPECIAL INSPECTION SHEET
SHEET 3 OF 3
RAIL UNLOADING RACK

SYSTEM TYPE: NA			EDIFICE/BUILDING: UNLOADING RACK	LEVEL/FLOOR: NA
SUB DISCIPLINE: SF	LOCATION CODE: LP1	LOCATION/GRID: NA	CCI CODE: YELLOW	PROJECT NAME:
CRITICAL QUALITY:		ENTERPRISE GROUP: API	DRAWING INTENTION:	DRAWING SCALE: NONE
CRITICAL BUSINESS:		EQUIPMENT CLASSIFICATION: NA	ALTERNATE DOCUMENT ID: NA	MERIDIAN REV: 0
CRITICAL HSE:		VENDOR: NA	DOCUMENT ID: LP1Y-SF-0009P006	
NON-CRITICAL:		ENGINEERING AGENCY DOC ID: NA		

IF YOU ARE USING A PRINTED COPY OF THIS DOCUMENT, IT IS AN UNCONTROLLED PRINT. CONFIRM WITH THE OFFICIAL "ELECTRONIC RECORD" DOCUMENT IN THE GLOBAL ENGINEERING CONTENT MANAGEMENT SYSTEM.

IF YOU ARE USING A PRINTED COPY OF THIS DOCUMENT, IT IS AN UNCONTROLLED PRINT. CONFIRM WITH THE OFFICIAL "ELECTRONIC RECORD" DOCUMENT IN THE GLOBAL ENGINEERING CONTENT MANAGEMENT SYSTEM.

BUILDING CODE : 2012 INTERNATIONAL BUILDING CODE

SCHEDULE OF SPECIAL INSPECTIONS

IBC 2012, SECTION 1705.6: SOILS

	VERIFICATION, INSPECTION, AND TEST	GENERAL REQUIREMENTS REFERENCED STANDARD	IBC REFERENCE	SERVICES	EXTENT / FREQUENCY	APPLICATION TO THIS PROJECT YES/NO (NOTE 8)	COMMENTS	AGENT	DATE COMPLETE
1.	VERIFY MATERIALS BELOW SHALLOW FOUNDATIONS ARE ADEQUATE TO ACHIEVE THE DESIGN BEARING CAPACITY AS PROVIDED ON THE CONTRACT DOCUMENTS		TABLE 1705.6	IN-FIELD	PERIODIC	YES			
2.	VERIFY EXCAVATIONS ARE EXTENDED TO PROPER DEPTH AND HAVE REACHED PROPER MATERIAL.		TABLE 1705.6	IN-FIELD	PERIODIC	YES			
3.	PERFORM CLASSIFICATION AND TESTING OF CONTROLLED FILL MATERIALS.		TABLE 1705.6	IN-FIELD	PERIODIC	YES			
4.	VERIFY USE OF PROPER MATERIALS, DENSITIES, AND LIFT THICKNESS DURING PLACEMENT AND COMPACTION OF CONTROLLED FILL		TABLE 1705.6	IN-FIELD	CONTINUOUS	YES			
5.	PRIOR TO PLACEMENT OF CONTROLLED FILL, OBSERVE SUBGRADE AND VERIFY THAT SITE HAS BEEN PREPARED PROPERLY.		TABLE 1705.6	IN-FIELD	PERIODIC	YES			

NOTES:

1. FOR GENERAL NOTES, DESIGN CRITERIA, AND STANDARDS, REFER TO DRAWING LP1Y-SF-0009P001.
2. REFER TO SPECIAL INSPECTION NOTES ON DRAWING LP1Y-SF-0009P004.

V1- VOID - DO NOT RESUBMIT

Authorization to proceed does not relieve Contractor/Supplier of its responsibility or liability under the Contract and or Purchase Order.

By dac54131 at Dec 03, 2025

PRELIMINARY
NOT FOR CONSTRUCTION

REV	ZONE	PROJECT NUMBER / DESCRIPTION	CHANGE CONTROL	DATE
A		ISSUED FOR REVIEW		10-OCT-2025

REVISIONS

CONFIDENTIAL INFORMATION
THIS DRAWING AND THE IDEAS AND DESIGNS SHOWN THEREON ARE THE EXCLUSIVE PROPERTY OF ELI LILLY AND COMPANY AND ARE NOT TO BE USED, REPRODUCED OR DISCLOSED, EITHER IN WHOLE OR IN PART, WITHOUT THE WRITTEN CONSENT OF ELI LILLY AND COMPANY.

FLUOR® EFDEE Engineering PC
PROJECT NO. B1LG
NODE:

REV	DATE	DES	ENG	CHK	APP	PM APP
A	10-OCT-2025	RKN	SJS	FCB	RMF	SS

Lilly

STRUCTURAL SPECIAL INSPECTION SHEET

SHEET 4 OF 6

SYSTEM TYPE: NA			EDIFICE/BUILDING: UNLOADING RACK	LEVEL/FLOOR:
SUB DISCIPLINE	LOCATION CODE: LP1	LOCATION/GRID	CCI CODE	PROJECT NAME: LP1-306-1181
CRITICAL QUALITY		ENTERPRISE GROUP: API	DRAWING INTENTION	DRAWING SCALE: NONE
CRITICAL BUSINESS		EQUIPMENT CLASSIFICATION: NA	ALTERNATE DOCUMENT ID: NA	MERIDIAN REV: 1
CRITICAL HSE		VENDOR: NA	DOCUMENT ID: LP1Y-SF-0009P007	
NON-CRITICAL		ENGINEERING AGENCY DOC ID: NA		

IF YOU ARE USING A PRINTED COPY OF THIS DOCUMENT, IT IS AN UNCONTROLLED PRINT. CONFIRM WITH THE OFFICIAL "ELECTRONIC RECORD" DOCUMENT IN THE GLOBAL ENGINEERING CONTENT MANAGEMENT SYSTEM.

IF YOU ARE USING A PRINTED COPY OF THIS DOCUMENT, IT IS AN UNCONTROLLED PRINT. CONFIRM WITH THE OFFICIAL "ELECTRONIC RECORD" DOCUMENT IN THE GLOBAL ENGINEERING CONTENT MANAGEMENT SYSTEM.

BUILDING CODE : 2012 INTERNATIONAL BUILDING CODE

SCHEDULE OF SPECIAL INSPECTIONS

IBC 2012, SECTION 1705.11.1: STRUCTURAL STEEL SPECIAL INSPECTIONS FOR SEISMIC RESISTANCE

	VERIFICATION, INSPECTION, AND TEST	GENERAL REQUIREMENTS REFERENCED STANDARD	IBC REFERENCE	SERVICES	EXTENT / FREQUENCY	APPLICATION TO THIS PROJECT YES/NO (NOTE 8)	COMMENTS	AGENT	DATE COMPLETE
1.	REFERENCE AISC 341, CHAPTER J: QUALITY CONTROL AND QUALITY ASSURANCE		SECTION 1705.11.1						
2.	VERIFY DOCUMENTS LISTED IN AISC 341, CHAPTER J, SECTION J2: FABRICATOR AND ERECTION DOCUMENTS HAVE BEEN REVIEWED BY THE ENGINEER OF RECORD AS APPLICABLE.			IN-FIELD	INITIAL INSPECTION	YES			
3.	INSPECTION OF WELDING								
	A. INSPECT WELDING OPERATIONS AND COMPLETED WELDS ACCORDING TO THE REQUIREMENTS OF AISC 341, CHAPTER J, SECTION J6: WELDING INSPECTION AND NONDESTRUCTIVE TESTING, SUBSECTION 1: VISUAL WELDING INSPECTION.	REFERENCE AISC 341:							
		TABLE J6-1: VISUAL INSPECTION TASKS PRIOR TO WELDING		IN-FIELD	PERIODIC	YES			
		TABLE J6-2: VISUAL INSPECTION TASKS DURING WELDING							
		TABLE J6-3: INSPECTION TASKS AFTER WELDING							
4.	INSPECTION OF BOLTING:								
	A. INSPECT BOLTING OPERATIONS AND ASSEMBLED CONNECTIONS ACCORDING TO THE REQUIREMENTS OF AISC 341, CHAPTER J, SECTION J7: INSPECTION OF HIGH-STRENGTH BOLTING AND RCSC, SECTION 9: INSPECTION.	REFERENCE AISC 341:					REFER TO THE CONTRACT DOCUMENTS FOR THE IDENTIFICATION OF JOINT TYPES: ALL JOINTS ARE TO BE PRE-TENSIONED JOINTS FOR HIGH STRENGTH BOLTED CONNECTIONS UNLESS NOTED OTHERWISE ON THE CONTRACT DOCUMENTS.		
		TABLE J7-1: INSPECTION TASKS PRIOR TO BOLTING		IN-FIELD	PERIODIC	YES			
		TABLE J7-2: INSPECTION TASKS DURING BOLTING							
		TABLE J7-3: INSPECTION TASKS AFTER BOLTING							
	B. VERIFY PRE-TENSIONING METHOD IS APPROVED AND IN ACCORDANCE WITH THE CONTRACT DOCUMENTS.			IN-FIELD	PERIODIC	YES			
5.	INSPECT H-PILES ACCORDING TO THE REQUIREMENTS OF AISC 341, CHAPTER J, SECTION J10: INSPECTION OF H-PILES.	AISC 341: TABLE J10-1		IN-FIELD	PERIODIC	NO			

NOTES:

1. FOR GENERAL NOTES, DESIGN CRITERIA, AND STANDARDS, REFER TO DRAWING LP1Y-SF-0009P001.
2. REFER TO SPECIAL INSPECTION NOTES ON DRAWING LP1Y-SF-0009P004.

V1- VOID - DO NOT RESUBMIT

Authorization to proceed does not relieve Contractor/Supplier of its responsibility or liability under the Contract and or Purchase Order.

By dac54131 at Dec 03, 2025

PRELIMINARY
NOT FOR CONSTRUCTION

REV	ZONE	PROJECT NUMBER / DESCRIPTION	CHANGE CONTROL	DATE
A		ISSUED FOR REVIEW		10-OCT-2025

REVISIONS

CONFIDENTIAL INFORMATION
THIS DRAWING AND THE IDEAS AND DESIGNS SHOWN THEREON ARE THE EXCLUSIVE PROPERTY OF ELI LILLY AND COMPANY AND ARE NOT TO BE USED, REPRODUCED OR DISCLOSED, EITHER IN WHOLE OR IN PART, WITHOUT THE WRITTEN CONSENT OF ELI LILLY AND COMPANY.

FLUOR®
EFDEE Engineering PC
PROJECT NO: B1LG
NODE:

REV	DATE	DES	ENG	CHK	APP	PM APP
A	10-OCT-2025	RKN	SJS	FCB	RMF	SS

Lilly

STRUCTURAL SPECIAL INSPECTION SHEET


SHEET 5 OF 6

SYSTEM TYPE: NA			EDIFICE/BUILDING: UNLOADING RACK	LEVEL/FLOOR:
SUB DISCIPLINE	LOCATION CODE: LP1	LOCATION/GRID	CCI CODE	PROJECT NAME: LP1-306-1181
CRITICAL QUALITY		ENTERPRISE GROUP: API	DRAWING INTENTION	DRAWING SCALE: NONE
CRITICAL BUSINESS		EQUIPMENT CLASSIFICATION: NA	ALTERNATE DOCUMENT ID: NA	MERIDIAN REV: 1
CRITICAL HSE		VENDOR: NA	DOCUMENT ID: LP1Y-SF-0009P008	
NON-CRITICAL		ENGINEERING AGENCY DOC ID: NA		

IF YOU ARE USING A PRINTED COPY OF THIS DOCUMENT, IT IS AN UNCONTROLLED PRINT. CONFIRM WITH THE OFFICIAL "ELECTRONIC RECORD" DOCUMENT IN THE GLOBAL ENGINEERING CONTENT MANAGEMENT SYSTEM.

IF YOU ARE USING A PRINTED COPY OF THIS DOCUMENT, IT IS AN UNCONTROLLED PRINT. CONFIRM WITH THE OFFICIAL "ELECTRONIC RECORD" DOCUMENT IN THE GLOBAL ENGINEERING CONTENT MANAGEMENT SYSTEM.

By:LG-00-K215-00012-3_LP1Y-SF-0009P250.pdf

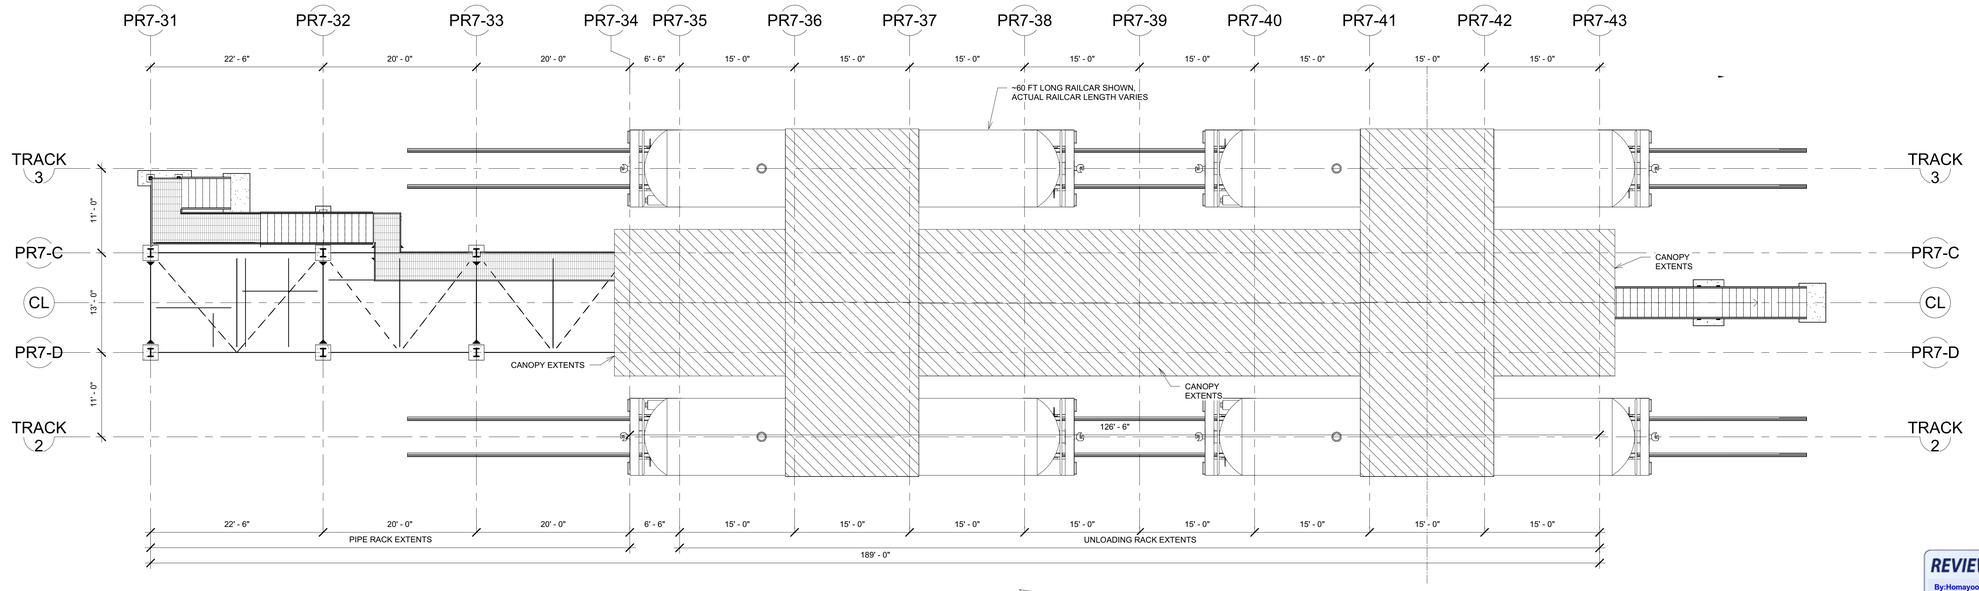


GENERAL ARRANGEMENT PLAN

1/8" = 1'-0"

REVIEWED
By:Homayoon S. CSA,saf16975,March 2, 2026

No comment

No additional comments

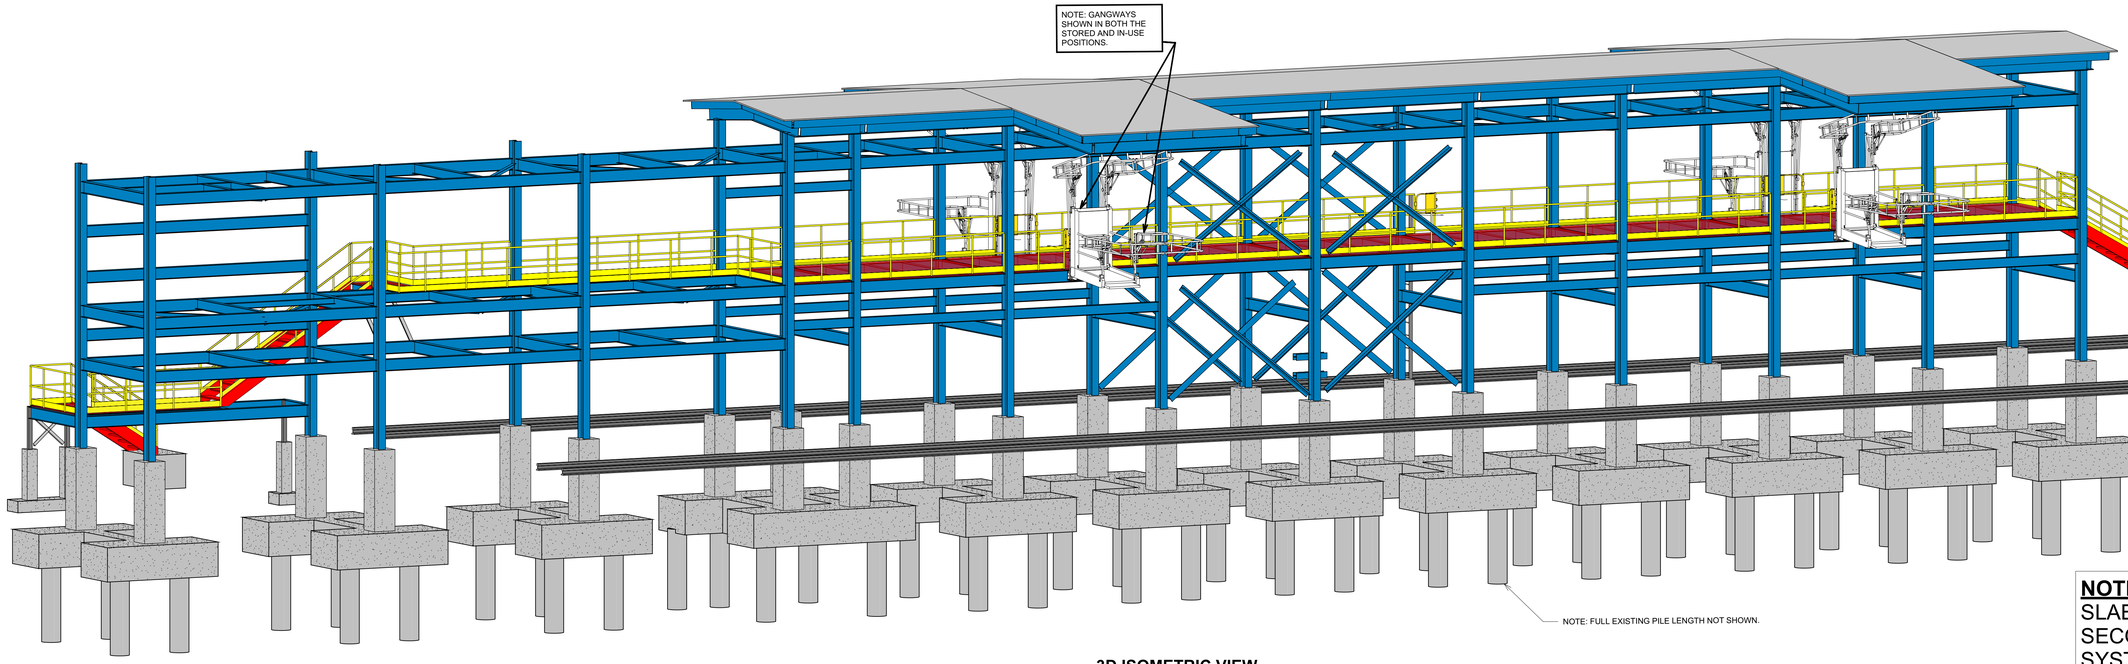

3D ISOMETRIC VIEW


NOTE:
SLAB-ON-GRADE AND SECONDARY CONTAINMENT SYSTEM NOT SHOWN

A1 - DATA COMPLETE - NO COMMENTS - DO NOT RESUBMIT

Authorization to proceed does not relieve Contractor/Supplier of its responsibility or liability under the Contract and or Purchase Order.

By: Ricardo DaCosta dac54131 March 9, 2026

RYNE M. FIORITO REGISTERED PE12100177 STATE OF INDIANA PROFESSIONAL ENGINEER

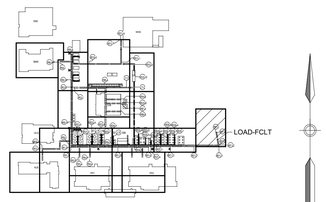

SITE - KEYPLAN

HANSON™
HANSON PROFESSIONAL SERVICES, INC.
www.hanson-inc.com
Offices Nationwide
11931 Wickchester Lane, Suite 370
Houston, TX 77043
(346) 297-1720

Lilly

GENERAL ARRANGEMENT PLAN

RAIL UNLOADING RACK

REV	DATE	DES	ENG	CHK	APP	PM APP
0	20-FEB-2026	RKN	SJS	FCB	RMF	SS
B	14-NOV-2025	RKN	SJS	FCB	FCB	SS
A	10-OCT-2025	RKN	SJS	FCB	RMF	SS

REVISIONS

REV	ZONE	PROJECT NUMBER / DESCRIPTION	CHANGE CONTROL	DATE
0		ISSUED FOR CONSTRUCTION		20-FEB-2026
B		ISSUED FOR REVIEW		14-NOV-2025
A		ISSUED FOR REVIEW		10-OCT-2025

CONFIDENTIAL INFORMATION


THIS DRAWING AND THE IDEAS AND DESIGNS SHOWN THEREON ARE THE EXCLUSIVE PROPERTY OF ELI LILLY AND COMPANY AND ARE NOT TO BE USED, REPRODUCED OR DISCLOSED, EITHER IN WHOLE OR IN PART, WITHOUT THE WRITTEN CONSENT OF ELI LILLY AND COMPANY.

SYSTEM TYPE: NA		EDIFICE/BUILDING: UNLOADING RACK	LEVEL/FLOOR: 0
SUB DISCIPLINE: SF	LOCATION CODE: LP1	LOCATION/GRID: NA	CO CODE: YELLOW	PROJECT NAME: LP1-306-1181
CRITICAL QUALITY		ENTERPRISE GROUP: API	DRAWING INTENTION	DRAWING SCALE: 1/8" = 1'-0"
CRITICAL BUSINESS		EQUIPMENT CLASSIFICATION: NA	ALTERNATE DOCUMENT ID: NA	MERIDIAN REV: 0
CRITICAL HSE		VENDOR: NA	DOCUMENT ID: LP1Y-SF-0009P250	
NON-CRITICAL		ENGINEERING AGENCY DOC ID: NA		

IF YOU ARE USING A PRINTED COPY OF THIS DOCUMENT, IT IS AN UNCONTROLLED PRINT. CONFIRM WITH THE OFFICIAL "ELECTRONIC RECORD" DOCUMENT IN THE GLOBAL ENGINEERING CONTENT MANAGEMENT SYSTEM.


2/20/2026 10:52:22 AM Autodesk Docs://250007 - Hanson-Fluor Lilly/LP1Y-TFS-SX-000-000-93-HNS.rvt

IF YOU ARE USING A PRINTED COPY OF THIS DOCUMENT, IT IS AN UNCONTROLLED PRINT. CONFIRM WITH THE OFFICIAL "ELECTRONIC RECORD" DOCUMENT IN THE GLOBAL ENGINEERING CONTENT MANAGEMENT SYSTEM.

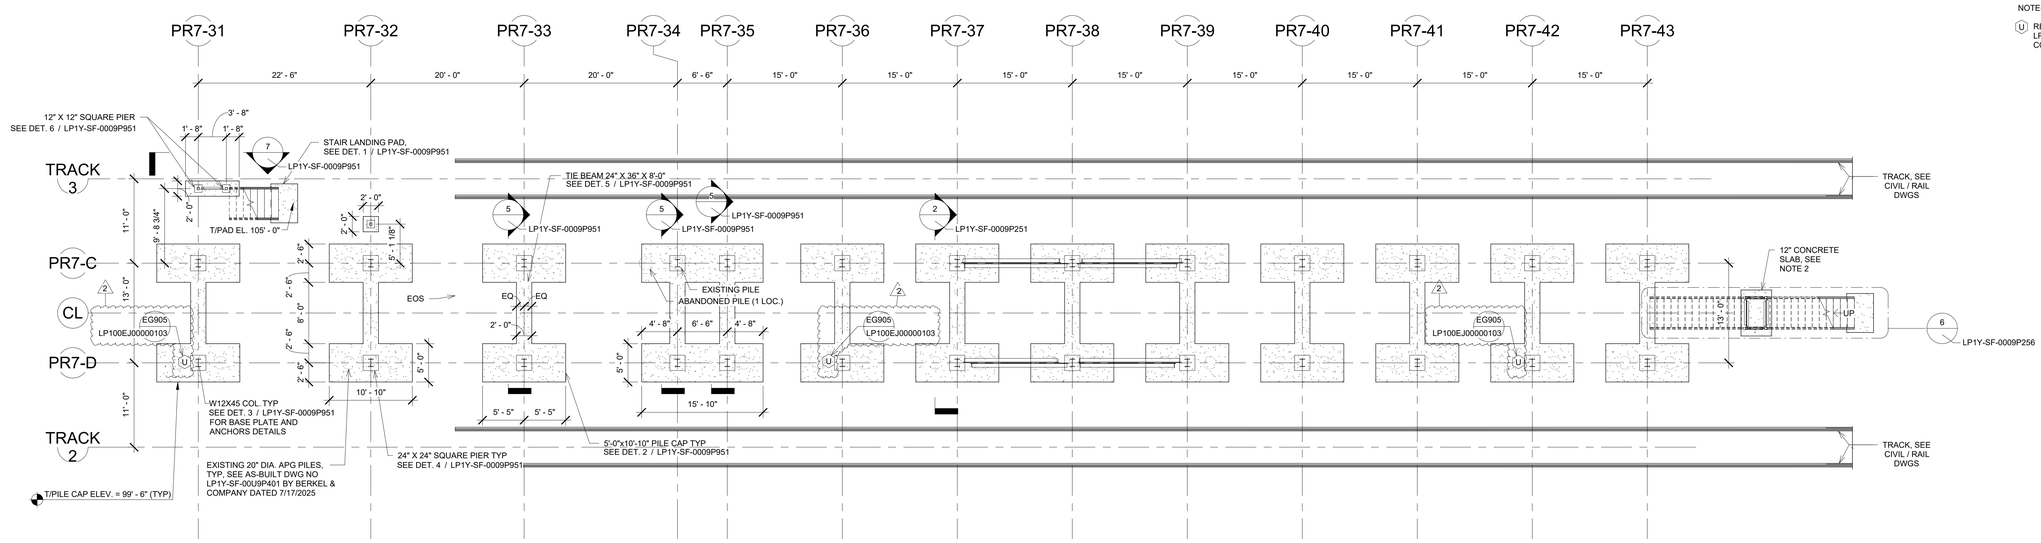


1 **FOUNDATION PLAN**
1/8" = 1'-0"
LP1Y-SF-0009P251

2 **TYPICAL SECTION AT PIER FOUNDATION**
3/8" = 1'-0"
LP1Y-SF-0009P251

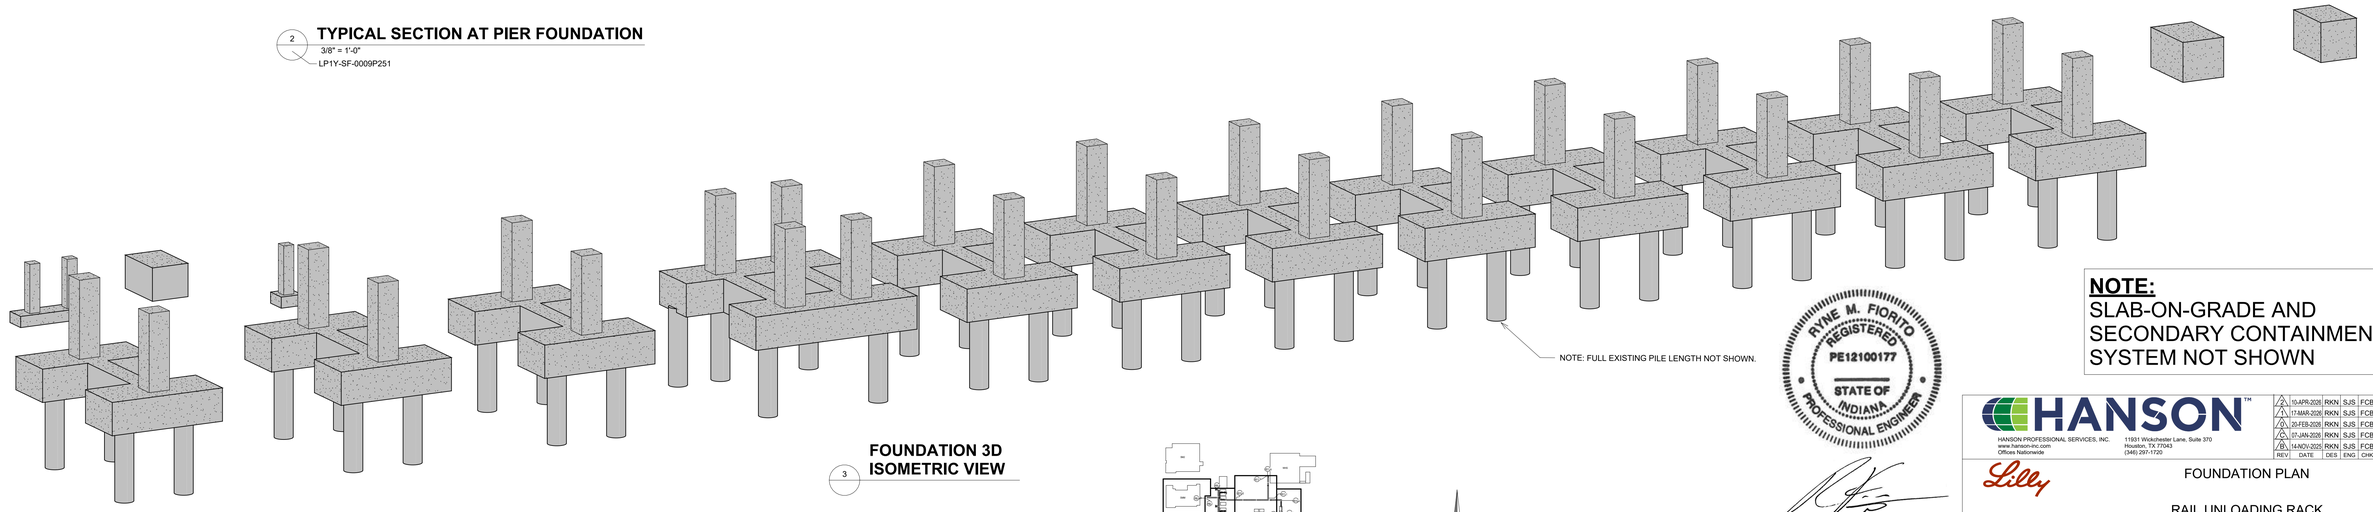

3 **FOUNDATION 3D ISOMETRIC VIEW**

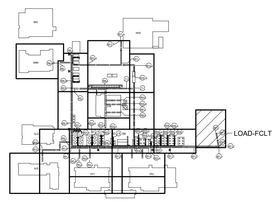

SITE - KEYPLAN

NOTES:

(U) REFER TO ELECTRICAL GROUNDING PLAN SHEET LP1Y-EP-00090006 FOR MORE DETAILS OF UFER CONNECTION. (TYPICAL OF 3)

A1- DATA COMPLETE - NO COMMENTS - DO NOT RESUBMIT

Authorization to proceed does not relieve Contractor/Supplier of its responsibility or liability under the Contract and or Purchase Order.

By dac54131 at Apr 15, 2026

RYNE M. FIORITO
REGISTERED
PE12100177
STATE OF INDIANA
PROFESSIONAL ENGINEER

NOTE:
SLAB-ON-GRADE AND SECONDARY CONTAINMENT SYSTEM NOT SHOWN

HANSON™
HANSON PROFESSIONAL SERVICES, INC.
www.hanson-inc.com
Offices Nationwide
11931 Wickchester Lane, Suite 370
Houston, TX 77043
(346) 297-1720

REV	DATE	DES	ENG	CHK	APP	PM APP
4	10-APR-2026	RKN	SJS	FCB	RMF	SS
3	17-MAR-2026	RKN	SJS	FCB	RMF	SS
2	20-FEB-2026	RKN	SJS	FCB	RMF	SS
1	07-JAN-2026	RKN	SJS	FCB	FCB	SS
0	14-NOV-2025	RKN	SJS	FCB	FCB	SS

Lilly

FOUNDATION PLAN

RAIL UNLOADING RACK

REV	ZONE	PROJECT NUMBER / DESCRIPTION	CHANGE CONTROL	DATE
2		ISSUED FOR CONSTRUCTION		10-APR-2026
1		ISSUED FOR CONSTRUCTION		17-MAR-2026
0		ISSUED FOR CONSTRUCTION		20-FEB-2026
C		ISSUED FOR REVIEW		07-JAN-2026
B		ISSUED FOR REVIEW		14-NOV-2025

REVISIONS

CONFIDENTIAL INFORMATION


THIS DRAWING AND THE IDEAS AND DESIGNS SHOWN THEREON ARE THE EXCLUSIVE PROPERTY OF ELI LILLY AND COMPANY AND ARE NOT TO BE USED, REPRODUCED OR DISCLOSED, EITHER IN WHOLE OR IN PART, WITHOUT THE WRITTEN CONSENT OF ELI LILLY AND COMPANY.

SYSTEM TYPE: NA			EDIFICE/BUILDING: UNLOADING RACK; LEVEL/FLOOR: 0
SUB DISCIPLINE: SF	LOCATION CODE: LP1	LOCATION/GRID: NA	CCI CODE: YELLOW; PROJECT NAME: LP1-306-1181
CRITICAL QUALITY		ENTERPRISE GROUP: API	DRAWING INTENTION; DRAWING SCALE: As indicated
CRITICAL BUSINESS		EQUIPMENT CLASSIFICATION: NA	ALTERNATE DOCUMENT ID: NA; MERIDIAN REV: 1
CRITICAL HSE		VENDOR: NA	DOCUMENT ID: LP1Y-SF-0009P251
NON-CRITICAL		ENGINEERING AGENCY DOC ID: NA	

IF YOU ARE USING A PRINTED COPY OF THIS DOCUMENT, IT IS AN UNCONTROLLED PRINT. CONFIRM WITH THE OFFICIAL "ELECTRONIC RECORD" DOCUMENT IN THE GLOBAL ENGINEERING CONTENT MANAGEMENT SYSTEM.

IF YOU ARE USING A PRINTED COPY OF THIS DOCUMENT, IT IS AN UNCONTROLLED PRINT. CONFIRM WITH THE OFFICIAL "ELECTRONIC RECORD" DOCUMENT IN THE GLOBAL ENGINEERING CONTENT MANAGEMENT SYSTEM.

4/10/2026 12:48:52 PM Autodesk Docs://2500007 - Hanson-Fluor Lilly/LP1Y-TFS-SU-009-000-00-INS.rvt

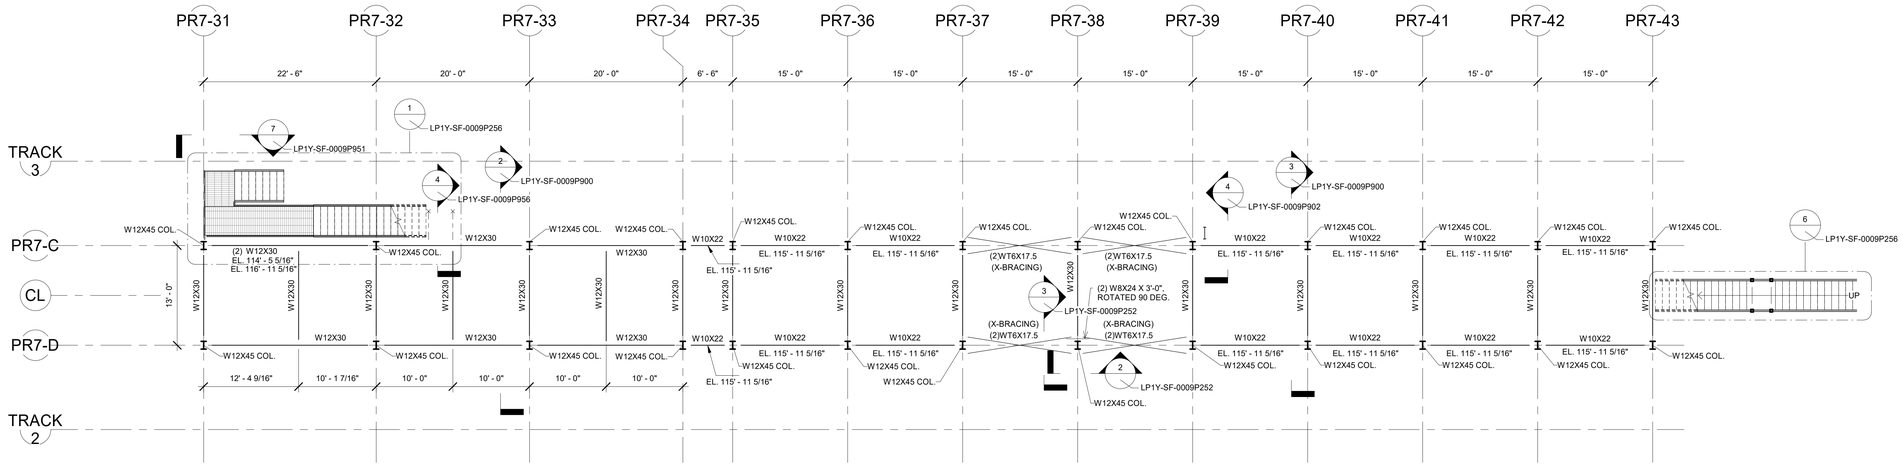

PIPE SUPPORT FRAMING PLAN


1/8" = 1'-0"

LP1Y-SF-0009P252

T/STL = EL 114'-5 5/16" UNO

SHEET NOTES:


1. DESIGN ALL SHEAR CXNS ON THIS SHEET FOR V=20 K.
2. SEE PLATFORM FRAMING PLAN FOR VERTICAL BRACE LOADS.
3. ALL LOADS PROVIDED ARE FACTORED LOADS (LRFD).

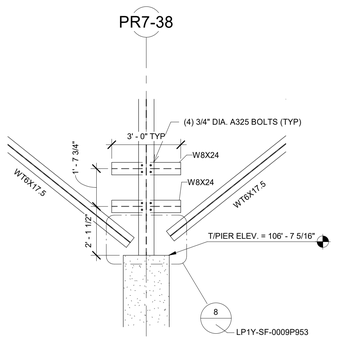

WATER HEATER SUPPORT FRAMING

3/8" = 1'-0"

LP1Y-SF-0009P252

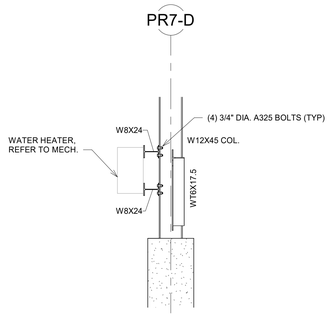

SECTION AT EQUIPMENT MOUNT FRAMING

3/8" = 1'-0"


LP1Y-SF-0009P252

A1- DATA COMPLETE - NO COMMENTS - DO NOT RESUBMIT

Authorization to proceed does not relieve Contractor/Supplier of its responsibility or liability under the Contract and or Purchase Order.

By dac54131 at Mar 23, 2026

NOTE:
SLAB-ON-GRADE AND SECONDARY CONTAINMENT SYSTEM NOT SHOWN

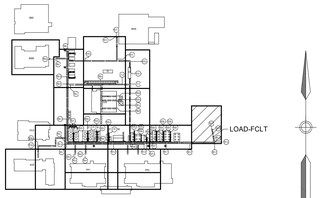

SITE - KEYPLAN

RYNE M. FIORITO
REGISTERED
PE12100177
STATE OF INDIANA
PROFESSIONAL ENGINEER

HANSON PROFESSIONAL SERVICES, INC.
www.hanson-inc.com
Offices Nationwide
11931 Wickchester Lane, Suite 370
Houston, TX 77043
(346) 297-1720

REV	DATE	DES	ENG	CHK	APP	PM APP
1	17-MAR-2026	RKN	SJS	FCB	RMF	SS
0	20-FEB-2026	RKN	SJS	FCB	RMF	SS
C	07-JAN-2026	RKN	SJS	FCB	FCB	SS
B	14-NOV-2025	RKN	SJS	FCB	FCB	SS
A	10-OCT-2025	RKN	SJS	FCB	RMF	SS

PIPE SUPPORT FRAMING PLAN

RAIL UNLOADING RACK

REV	ZONE	PROJECT NUMBER / DESCRIPTION	CHANGE CONTROL	DATE
1		ISSUED FOR CONSTRUCTION		17-MAR-2026
0		ISSUED FOR CONSTRUCTION		20-FEB-2026
C		ISSUED FOR REVIEW		07-JAN-2026
B		ISSUED FOR REVIEW		14-NOV-2025
A		ISSUED FOR REVIEW		10-OCT-2025

REVISIONS

CONFIDENTIAL INFORMATION

THIS DRAWING AND THE IDEAS AND DESIGNS SHOWN THEREON ARE THE EXCLUSIVE PROPERTY OF ELI LILLY AND COMPANY AND ARE NOT TO BE USED, REPRODUCED OR DISCLOSED, EITHER IN WHOLE OR IN PART, WITHOUT THE WRITTEN CONSENT OF ELI LILLY AND COMPANY.


SYSTEM TYPE: NA		EDIFICE/BUILDING: UNLOADING RACK	LEVEL/FLOOR: 0
SUB DISCIPLINE: SF	LOCATION CODE: LP1	LOCATION/GRID: NA	CCI CODE: YELLOW
			PROJECT NAME: LP1-306-1181
CRITICAL QUALITY	ENTERPRISE GROUP: API	DRAWING INTENTION	DRAWING SCALE: As indicated
CRITICAL BUSINESS	EQUIPMENT CLASSIFICATION: NA	ALTERNATE DOCUMENT ID: NA	MERIDIAN REV: 0
CRITICAL HSE	VENDOR: NA	DOCUMENT ID: LP1Y-SF-0009P252	
NON-CRITICAL	ENGINEERING AGENCY DOC ID: NA		

IF YOU ARE USING A PRINTED COPY OF THIS DOCUMENT, IT IS AN UNCONTROLLED PRINT. CONFIRM WITH THE OFFICIAL "ELECTRONIC RECORD" DOCUMENT IN THE GLOBAL ENGINEERING CONTENT MANAGEMENT SYSTEM.

IF YOU ARE USING A PRINTED COPY OF THIS DOCUMENT, IT IS AN UNCONTROLLED PRINT. CONFIRM WITH THE OFFICIAL "ELECTRONIC RECORD" DOCUMENT IN THE GLOBAL ENGINEERING CONTENT MANAGEMENT SYSTEM.

3/17/2026 7:34:32 AM Autodesk Docs://2500007 - Hanson-Fluor Lily LP1/Y-TFS-SD-000-00-MKS.rvt

By:LG-00-K215-00015-4_LP1Y-SF-0009P253.pdf

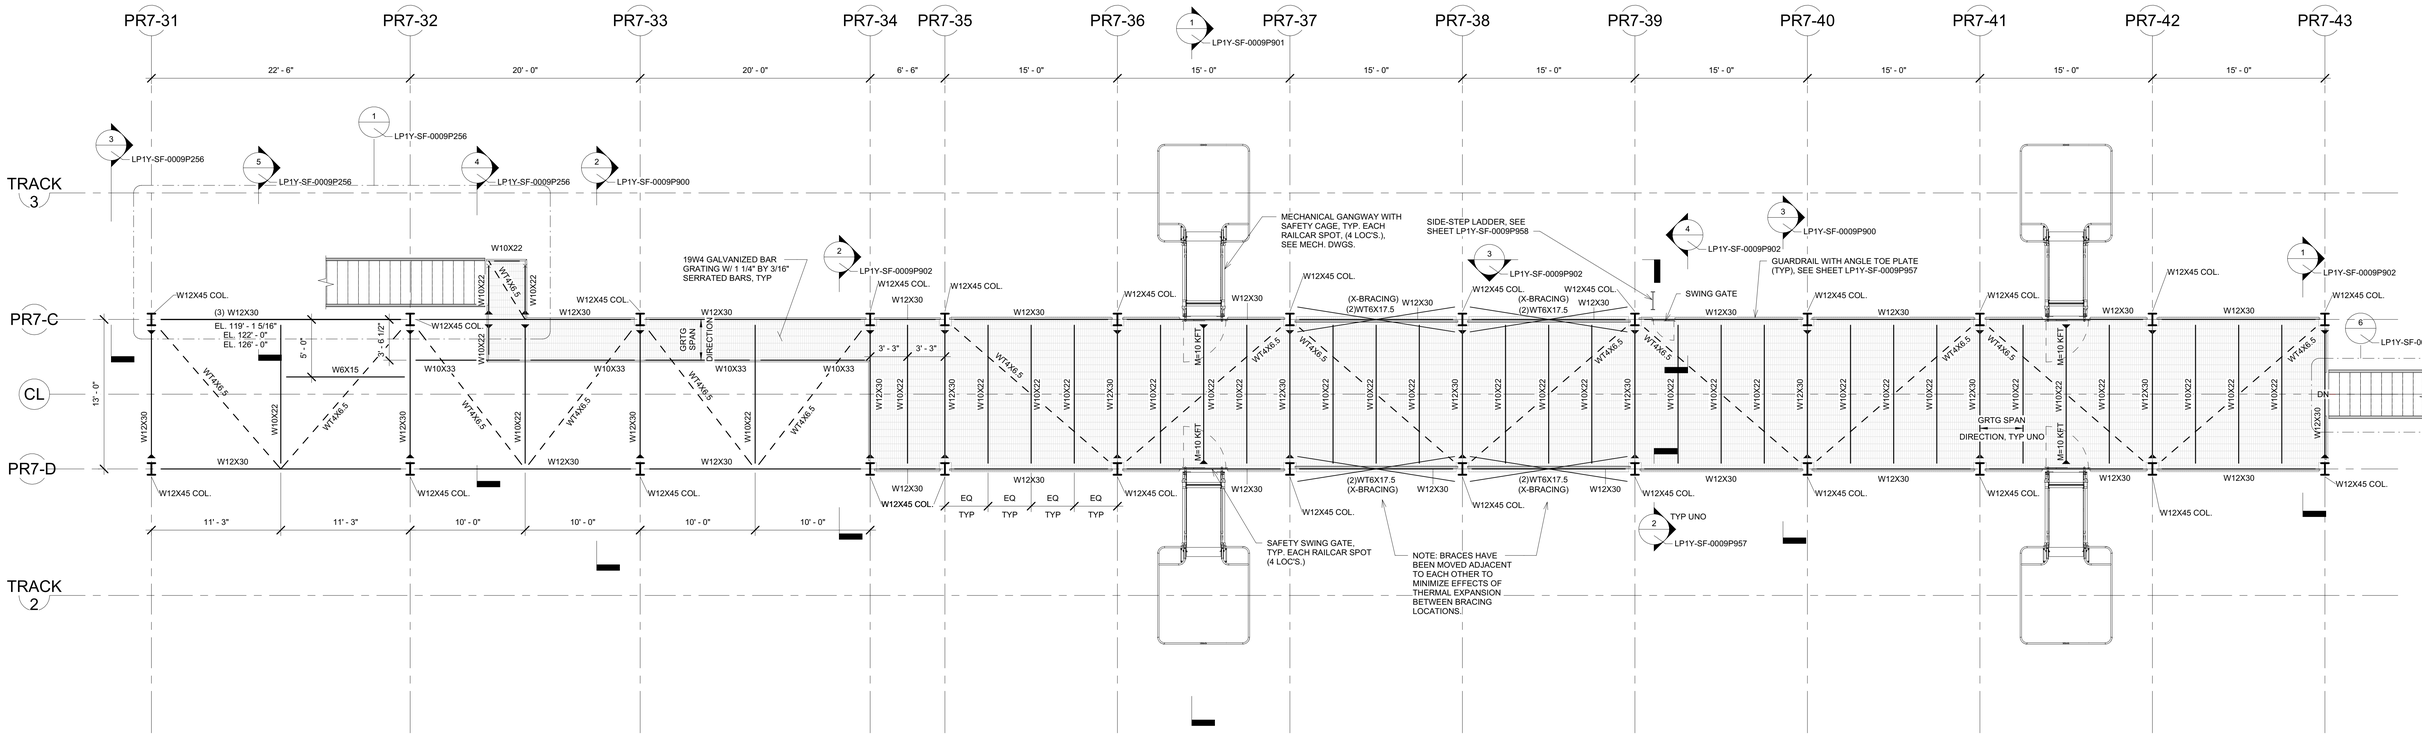

1 PLATFORM FRAMING PLAN

3/16" = 1'-0"

LP1Y-SF-0009P253

T/STL = EL 119'-1 5/16" UNO
T/STL OF WT HORIZ. BRACES = TO BE SET BY FABRICATOR

SHEET NOTES:

1. DESIGN ALL SHEAR CXNS ON THIS SHEET FOR V=20 K.
2. DESIGN ALL VERTICAL X-BRACE CXNS FOR P=30 K AXIAL LOAD (TENSION/COMPRESSION)
3. DESIGN ALL HORIZONTAL BRACE CXNS ON THIS SHEET FOR P=10 K AXIAL LOAD (TENSION/COMPRESSION).
4. ALL LOADS PROVIDED ARE FACTORED LOADS (LRFD).

FRAMING LEGEND

▶ = MOMENT CONNECTION, SEE DET. 5 / LP1Y-SF-0009P953

A1 - DATA COMPLETE - NO COMMENTS - DO NOT RESUBMIT

Authorization to proceed does not relieve Contractor/Supplier of its responsibility or liability under the Contract and or Purchase Order.


By: Ricardo DaCosta dac54131 March 11, 2026

No lilly comment

REVIEWED
By:Homayoon S. CSA_saf16975,March 10, 2026

No comment

RYNE M. FIORITO
REGISTERED
PE12100177
STATE OF INDIANA
PROFESSIONAL ENGINEER

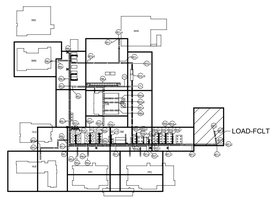

SITE - KEYPLAN

HANSON PROFESSIONAL SERVICES, INC.
www.hanson-inc.com
Offices Nationwide
11931 Wickchester Lane, Suite 370
Houston, TX 77043
(346) 297-1720

REV	DATE	DES	ENG	CHK	APP	PM APP
0	20-FEB-2026	RKN	SJS	FCB	RMF	SS
C	07-JAN-2026	RKN	SJS	FCB	FCB	SS
B	14-NOV-2025	RKN	SJS	FCB	FCB	SS
A	10-OCT-2025	RKN	SJS	FCB	RMF	SS

PLATFORM FRAMING PLAN

RAIL UNLOADING RACK

REV	ZONE	PROJECT NUMBER / DESCRIPTION	CHANGE CONTROL	DATE
0		ISSUED FOR CONSTRUCTION		20-FEB-2026
C		ISSUED FOR REVIEW		07-JAN-2026
B		ISSUED FOR REVIEW		14-NOV-2025
A		ISSUED FOR REVIEW		10-OCT-2025

REVISIONS

CONFIDENTIAL INFORMATION

THIS DRAWING AND THE IDEAS AND DESIGNS SHOWN THEREON ARE THE EXCLUSIVE PROPERTY OF ELI LILLY AND COMPANY AND ARE NOT TO BE USED, REPRODUCED OR DISCLOSED, EITHER IN WHOLE OR IN PART, WITHOUT THE WRITTEN CONSENT OF ELI LILLY AND COMPANY.

SYSTEM TYPE: NA			EDIFICE/BUILDING: UNLOADING RACK
SUB DISCIPLINE: SF	LOCATION CODE: LP1	LOCATION/GRID: NA	CCI CODE: YELLOW
CRITICAL QUALITY		ENTERPRISE GROUP: API	DRAWING INTENTION
CRITICAL BUSINESS		EQUIPMENT CLASSIFICATION: NA	ALTERNATE DOCUMENT ID: NA
CRITICAL HSE		VENDOR: NA	DOCUMENT ID: LP1Y-SF-0009P253
NON-CRITICAL		ENGINEERING AGENCY DOC ID: NA	


LEVEL/FLOOR: 0
PROJECT NAME: LP1-306-1181
DRAWING SCALE: As indicated
MERIDIAN REV: 0

IF YOU ARE USING A PRINTED COPY OF THIS DOCUMENT, IT IS AN UNCONTROLLED PRINT. CONFIRM WITH THE OFFICIAL "ELECTRONIC RECORD" DOCUMENT IN THE GLOBAL ENGINEERING CONTENT MANAGEMENT SYSTEM.

2/20/2026 10:52:29 AM Autodesk Docs://250007 - Hanson-Fluor Lilly/LP1Y-TFS-00-000-00-HNS.rvt

IF YOU ARE USING A PRINTED COPY OF THIS DOCUMENT, IT IS AN UNCONTROLLED PRINT. CONFIRM WITH THE OFFICIAL "ELECTRONIC RECORD" DOCUMENT IN THE GLOBAL ENGINEERING CONTENT MANAGEMENT SYSTEM.

By:LG-00-K215-00016-4_LP1Y-SF-0009P254.pdf

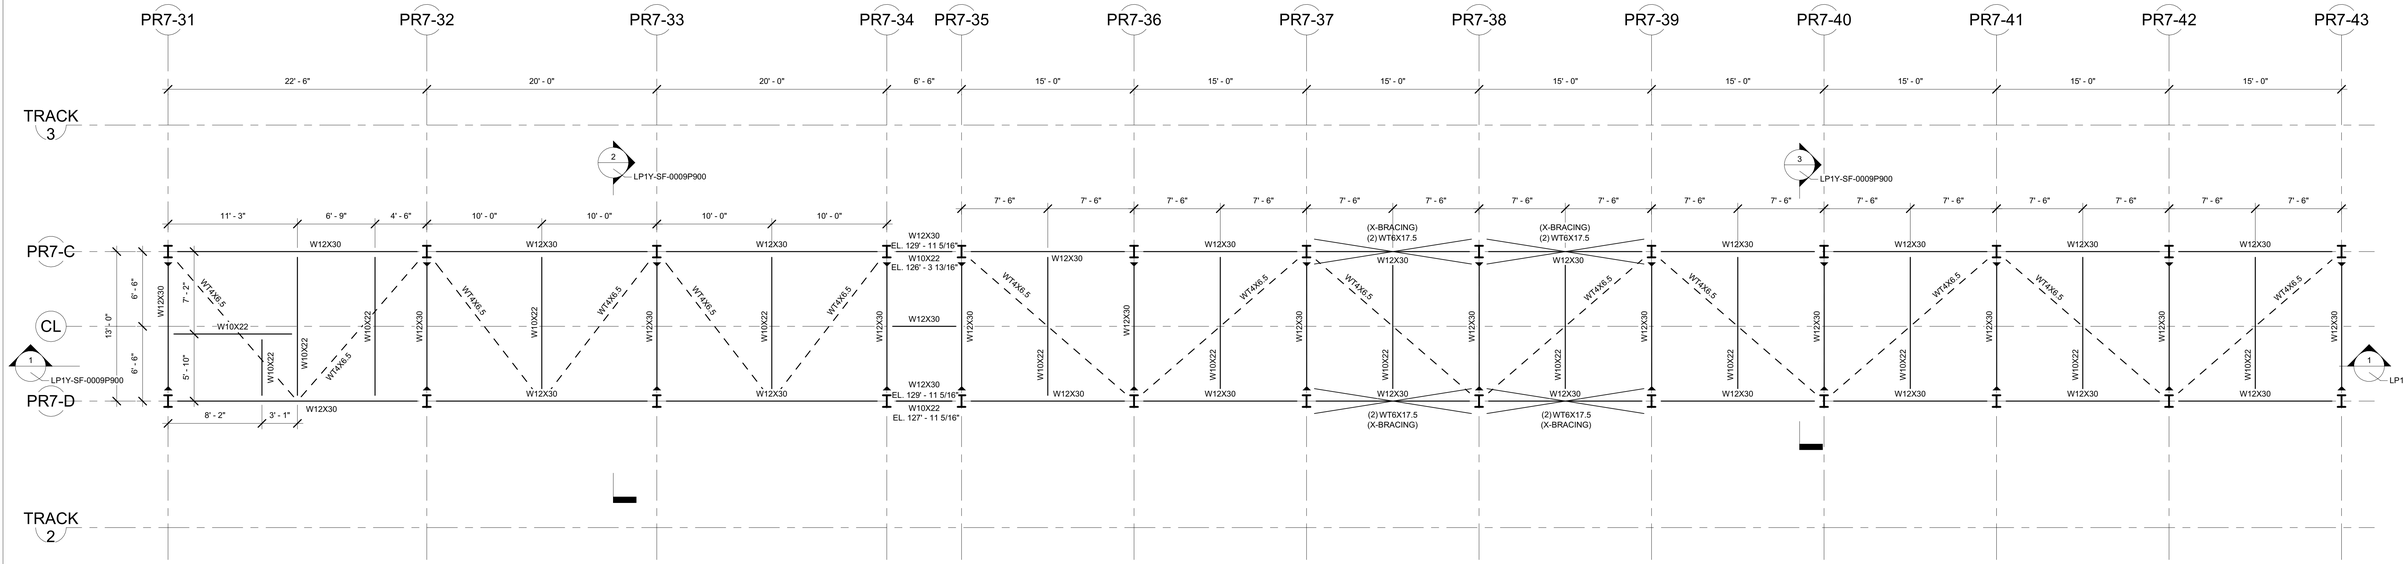

CABLE TRAY SUPPORT FRAMING PLAN

3/16" = 1'-0"

LP1Y-SF-0009P254

T/STL = EL 129' - 11 5/16" UNO
T/STL OF WT HORIZ. BRACES = TO BE SET BY FABRICATOR

SHEET NOTES:

1. DESIGN ALL SHEAR CXNS ON THIS SHEET FOR V=20 K.
2. DESIGN ALL HORIZONTAL BRACE CXNS ON THIS SHEET FOR P=10 K AXIAL LOAD (TENSION/COMPRESSION).
3. ALL LOADS PROVIDED ARE FACTORED LOADS (LRFD).

FRAMING LEGEND


▶ = MOMENT CONNECTION, SEE DET. 5 / LP1Y-SF-0009P953

A1 - DATA COMPLETE - NO COMMENTS - DO NOT RESUBMIT

Authorization to proceed does not relieve Contractor/Supplier of its responsibility or liability under the Contract and or Purchase Order.

By: Ricardo DaCosta dac54131 March 11, 2026

RYNE M. FIORITO
REGISTERED
PE12100177
STATE OF INDIANA
PROFESSIONAL ENGINEER

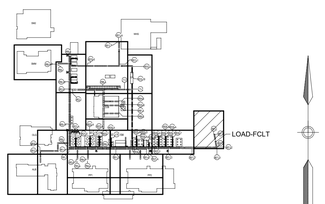

SITE - KEYPLAN

No Lilly comment

REVIEWED
By:Homayoon S. CSA,saf16975,March 10, 2026

No comment

HANSON™
HANSON PROFESSIONAL SERVICES, INC.
www.hanson-inc.com
Offices Nationwide
11931 Wickchester Lane, Suite 370
Houston, TX 77043
(346) 297-1720

REV	DATE	DES	ENG	CHK	APP	PM APP
2	20-FEB-2026	RKN	SJS	FCB	RMF	SS
C	07-JAN-2026	RKN	SJS	FCB	FCB	SS
B	14-NOV-2025	RKN	SJS	FCB	FCB	SS
A	10-OCT-2025	RKN	SJS	FCB	RMF	SS

Lilly

CABLE TRAY SUPPORT FRAMING PLAN

RAIL UNLOADING RACK

REV	ZONE	PROJECT NUMBER / DESCRIPTION	CHANGE CONTROL	DATE
0		ISSUED FOR CONSTRUCTION		20-FEB-2026
C		ISSUED FOR REVIEW		07-JAN-2026
B		ISSUED FOR REVIEW		14-NOV-2025
A		ISSUED FOR REVIEW		10-OCT-2025

REVISIONS

CONFIDENTIAL INFORMATION

THIS DRAWING AND THE IDEAS AND DESIGNS SHOWN THEREON ARE THE EXCLUSIVE PROPERTY OF ELI LILLY AND COMPANY AND ARE NOT TO BE USED, REPRODUCED OR DISCLOSED, EITHER IN WHOLE OR IN PART, WITHOUT THE WRITTEN CONSENT OF ELI LILLY AND COMPANY.


SYSTEM TYPE: NA				EDIFICE/BUILDING: UNLOADING RACK	LEVEL/FLOOR: 0
SUB DISCIPLINE: SF	LOCATION CODE: LP1	LOCATION/GRID: NA		CCI CODE: YELLOW	PROJECT NAME: LP1-306-1181
CRITICAL QUALITY		ENTERPRISE GROUP: API		DRAWING INTENTION	DRAWING SCALE: As indicated
CRITICAL BUSINESS		EQUIPMENT CLASSIFICATION: NA		ALTERNATE DOCUMENT ID: NA	MERIDIAN REV: 0
CRITICAL HSE		VENDOR: NA		DOCUMENT ID	LP1Y-SF-0009P254
NON-CRITICAL		ENGINEERING AGENCY DOC ID: NA			

IF YOU ARE USING A PRINTED COPY OF THIS DOCUMENT, IT IS AN UNCONTROLLED PRINT. CONFIRM WITH THE OFFICIAL "ELECTRONIC RECORD" DOCUMENT IN THE GLOBAL ENGINEERING CONTENT MANAGEMENT SYSTEM.

2/20/2026 10:52:27 AM Autodesk Docs://250007 - Hanson-Fluor Lilly/LP1Y-TFS-00-000-00-HNS.rvt

IF YOU ARE USING A PRINTED COPY OF THIS DOCUMENT, IT IS AN UNCONTROLLED PRINT. CONFIRM WITH THE OFFICIAL "ELECTRONIC RECORD" DOCUMENT IN THE GLOBAL ENGINEERING CONTENT MANAGEMENT SYSTEM.

By:LG-00-K215-00017-3_LP1Y-SF-0009P255.pdf

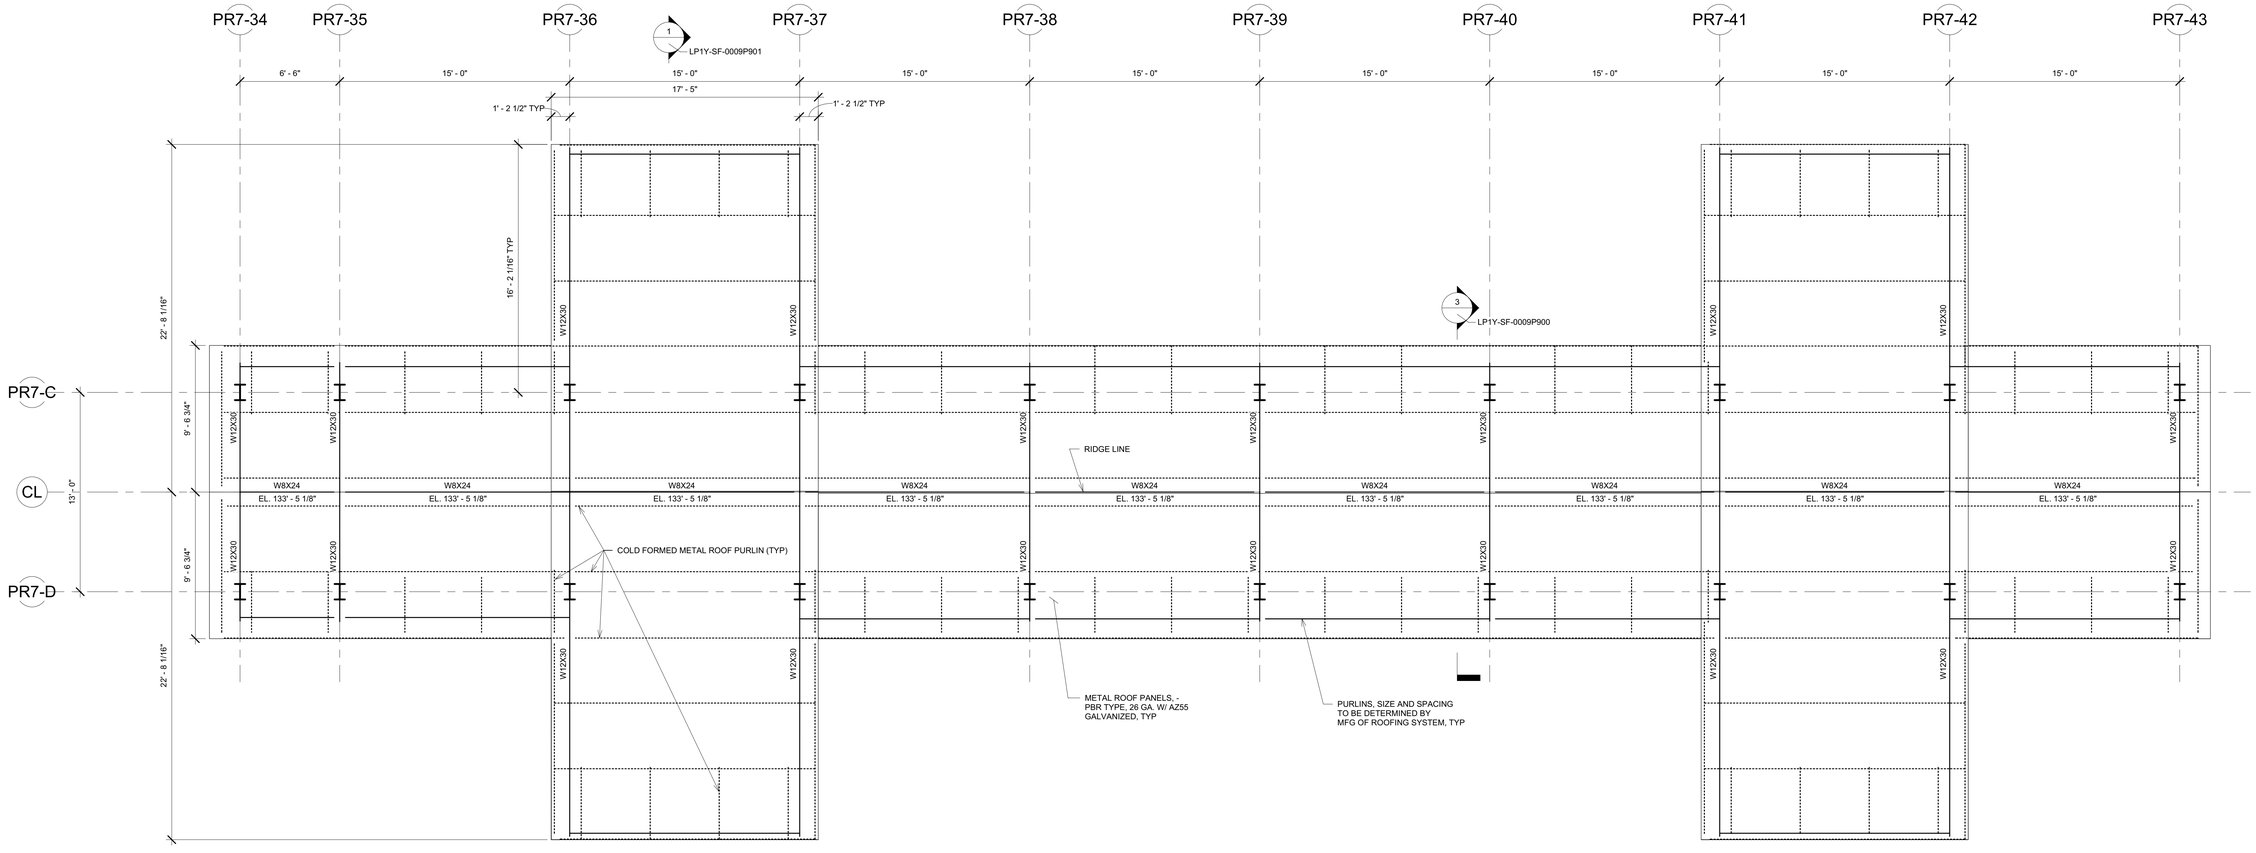

ROOF FRAMING PLAN

1/4" = 1'-0"

LP1Y-SF-0009P255

T/STL ELEVATION = SEE SECTIONS
1/ LP1Y-SF-00000901 & 3/LP1Y-SF-00000900

SHEET NOTES:

1. DESIGN ALL SHEAR CXNS ON THIS SHEET FOR V=10 K
2. ALL LOADS PROVIDED ARE MAXIMUM FACTORED LOADS (LRFD).

No lilly comment

REVIEWED
By Honeycutt S. CSA.ad1597f,March 10, 2026


No comment

A1 - DATA COMPLETE - NO COMMENTS - DO NOT RESUBMIT

Authorization to proceed does not relieve Contractor/Supplier of its responsibility or liability under the Contract and or Purchase Order.

By: Ricardo DaCosta dac54131 March 11, 2026

RYNE M. FIORITO
REGISTERED
PE12100177
STATE OF INDIANA
PROFESSIONAL ENGINEER

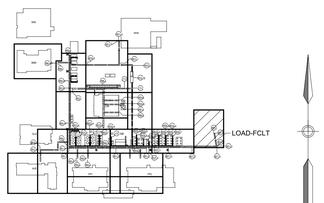

SITE - KEYPLAN

HANSON™
HANSON PROFESSIONAL SERVICES, INC.
www.hanson-inc.com
Offices Nationwide
11931 Wickchester Lane, Suite 370
Houston, TX 77043
(346) 297-1720

REV	DATE	DES	ENG	CHK	APP	PM APP
2	20-FEB-2026	RKN	SJS	FCB	RMF	SS
1	14-NOV-2025	RKN	SJS	FCB	FCB	SS
0	10-OCT-2025	RKN	SJS	FCB	RMF	SS

Lilly

ROOF FRAMING PLAN

RAIL UNLOADING RACK

REV	ZONE	PROJECT NUMBER / DESCRIPTION	CHANGE CONTROL	DATE
0		ISSUED FOR CONSTRUCTION		20-FEB-2026
B		ISSUED FOR REVIEW		14-NOV-2025
A		ISSUED FOR REVIEW		10-OCT-2025

REVISIONS

CONFIDENTIAL INFORMATION


THIS DRAWING AND THE IDEAS AND DESIGNS SHOWN THEREON ARE THE EXCLUSIVE PROPERTY OF ELI LILLY AND COMPANY AND ARE NOT TO BE USED, REPRODUCED OR DISCLOSED, EITHER IN WHOLE OR IN PART, WITHOUT THE WRITTEN CONSENT OF ELI LILLY AND COMPANY.

SYSTEM TYPE: NA		EDIFICE/BUILDING: UNLOADING RACK	LEVEL/FLOOR: 0
SUB DISCIPLINE: SF	LOCATION CODE: LP1	LOCATION/GRID: NA	CCI CODE: YELLOW	PROJECT NAME: LP1-306-1181
CRITICAL QUALITY		ENTERPRISE GROUP: API	DRAWING INTENTION	DRAWING SCALE: 1/4" = 1'-0"
CRITICAL BUSINESS		EQUIPMENT CLASSIFICATION: NA	ALTERNATE DOCUMENT ID: NA	MERIDIAN REV: 0
CRITICAL HSE		VENDOR: NA	DOCUMENT ID: LP1Y-SF-0009P255	
NON-CRITICAL		ENGINEERING AGENCY DOC ID: NA		

IF YOU ARE USING A PRINTED COPY OF THIS DOCUMENT, IT IS AN UNCONTROLLED PRINT. CONFIRM WITH THE OFFICIAL "ELECTRONIC RECORD" DOCUMENT IN THE GLOBAL ENGINEERING CONTENT MANAGEMENT SYSTEM.

2/20/2026 10:52:26 AM Autodesk Docs://250007 - Hanson-Fluor Lilly/LP1Y-TFS-SI-000-000-00-HNS.rvt


IF YOU ARE USING A PRINTED COPY OF THIS DOCUMENT, IT IS AN UNCONTROLLED PRINT. CONFIRM WITH THE OFFICIAL "ELECTRONIC RECORD" DOCUMENT IN THE GLOBAL ENGINEERING CONTENT MANAGEMENT SYSTEM.

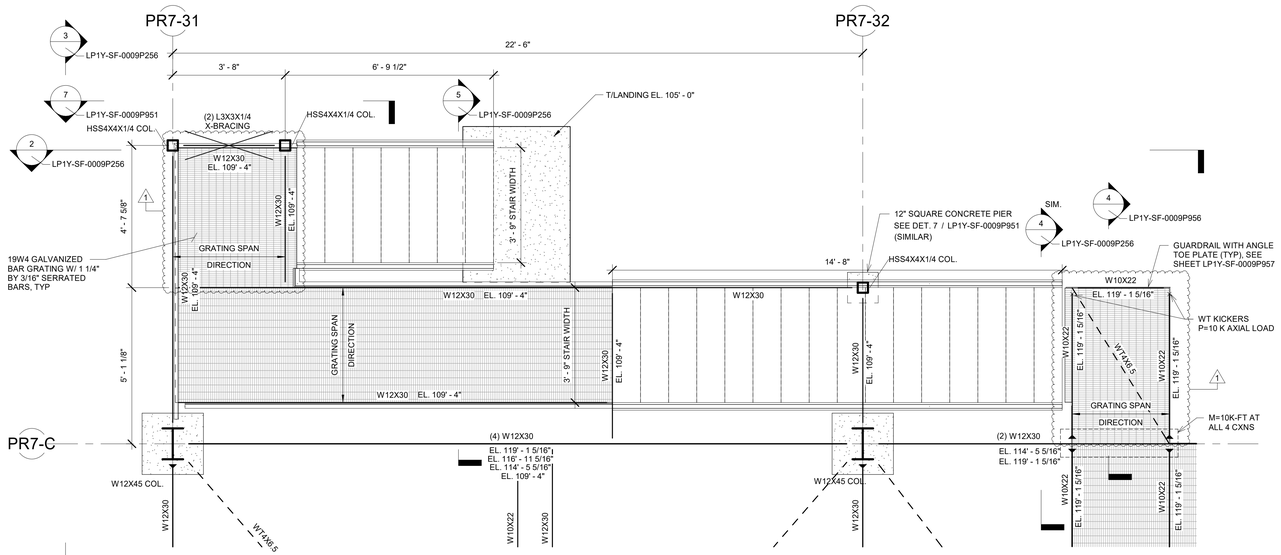

1 **SOUTH STAIRS FRAMING PLAN**
1/2" = 1'-0"
LP1Y-SF-0009P256

SHEET NOTES:
1. DESIGN ALL SHEAR CXNS ON THIS SHEET FOR V=20 K.
2. DESIGN ALL VERTICAL X-BRACE CXNS ON THIS SHEET FOR P=10 K AXIAL LOAD (TENSION/COMPRESSION).
3. DESIGN ALL HORIZONTAL BRACE CXNS ON THIS SHEET FOR P=10 K AXIAL LOAD (TENSION/COMPRESSION).
4. ALL LOADS PROVIDED ARE FACTORED LOADS (LRFD).

NOTE:
SLAB-ON-GRADE AND SECONDARY CONTAINMENT SYSTEM NOT SHOWN

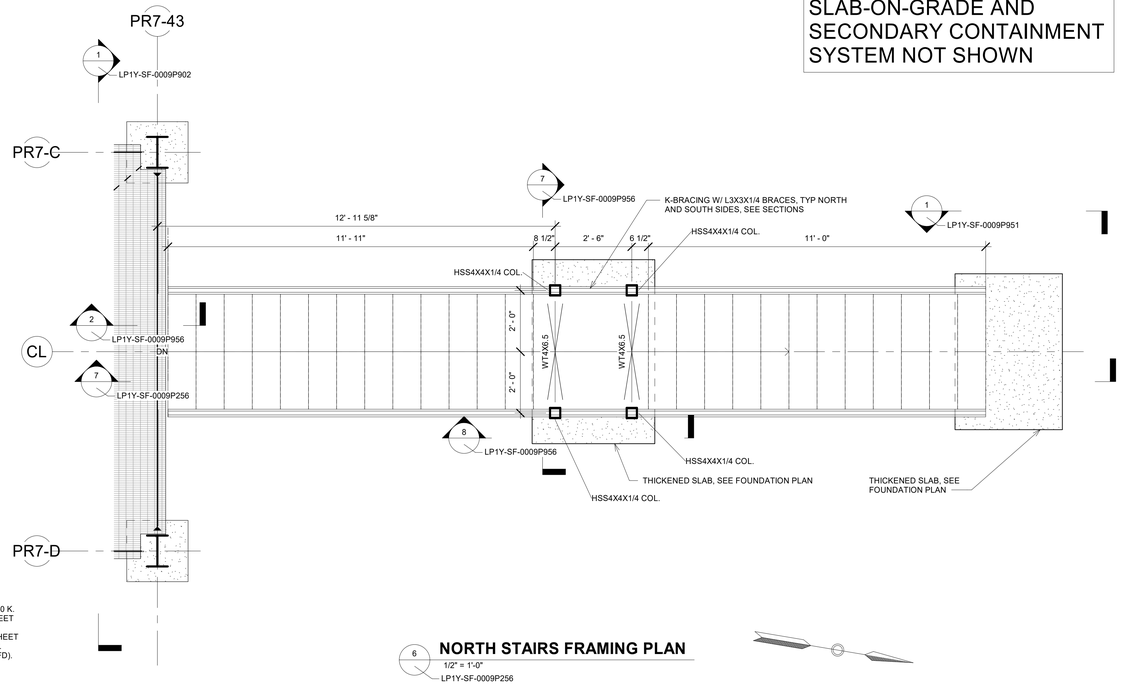

6 **NORTH STAIRS FRAMING PLAN**
1/2" = 1'-0"
LP1Y-SF-0009P256


2 **ELEVATION AT STAIRS**
1/4" = 1'-0"
LP1Y-SF-0009P256

3 **SECTION AT STAIRS**
1/4" = 1'-0"
LP1Y-SF-0009P256

7 **ELEVATION AT STAIRS**
3/8" = 1'-0"
LP1Y-SF-0009P256

5 **SECTION AT MIDDLE STAIRS PLATFORM**
1/4" = 1'-0"
LP1Y-SF-0009P256

4 **SECTION AT UPPER STAIRS PLATFORM**
1/4" = 1'-0"
LP1Y-SF-0009P256

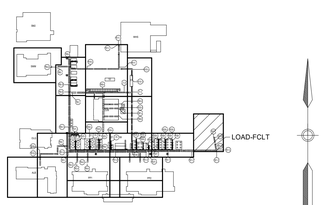

SITE - KEYPLAN

A1- DATA COMPLETE - NO COMMENTS - DO NOT RESUBMIT
Authorization to proceed does not relieve Contractor/Supplier of its responsibility or liability under the Contract and or Purchase Order.
By dac54131 at Mar 23, 2026

RYNE M. FIORITO
REGISTERED
PE12100177
STATE OF INDIANA
PROFESSIONAL ENGINEER

REV	ZONE	PROJECT NUMBER / DESCRIPTION	CHANGE CONTROL	DATE
1		ISSUED FOR CONSTRUCTION		17-MAR-2026
0		ISSUED FOR CONSTRUCTION		20-FEB-2026
C		ISSUED FOR REVIEW		07-JAN-2026
B		ISSUED FOR REVIEW		14-NOV-2025
A		ISSUED FOR REVIEW		10-OCT-2025

REVISIONS
CONFIDENTIAL INFORMATION
THIS DRAWING AND THE IDEAS AND DESIGNS SHOWN THEREON ARE THE EXCLUSIVE PROPERTY OF ELI LILLY AND COMPANY AND ARE NOT TO BE USED, REPRODUCED OR DISCLOSED, EITHER IN WHOLE OR IN PART, WITHOUT THE WRITTEN CONSENT OF ELI LILLY AND COMPANY.

HANSON PROFESSIONAL SERVICES, INC.
www.hanson-inc.com
Offices Nationwide
11931 Wickchester Lane, Suite 370
Houston, TX 77043
(346) 297-1720

REV	DATE	DES	ENG	CHK	APP	PM APP
1	17-MAR-2026	RKN	SJS	FCB	RMF	SS
0	20-FEB-2026	RKN	SJS	FCB	RMF	SS
C	07-JAN-2026	RKN	SJS	FCB	FCB	SS
B	14-NOV-2025	RKN	SJS	FCB	FCB	SS
A	10-OCT-2025	RKN	SJS	FCB	RMF	SS

Lilly

STAIR PLAN

RAIL UNLOADING RACK


SYSTEM TYPE: NA		EDIFICE/BUILDING: UNLOADING RACK	LEVEL/FLOOR: 0
SUB DISCIPLINE: SF	LOCATION CODE: LP1	LOCATION/GRID: NA	CCI CODE: YELLOW
CRITICAL QUALITY:		ENTERPRISE GROUP: API	DRAWING INTENTION:
CRITICAL BUSINESS:		EQUIPMENT CLASSIFICATION: NA	ALTERNATE DOCUMENT ID: NA
CRITICAL HSE:		VENDOR: NA	DOCUMENT ID: LP1Y-SF-0009P256
NON-CRITICAL:		ENGINEERING AGENCY DOC ID: NA	

PROJECT NAME: LP1-306-1181
DRAWING SCALE: As indicated
MERIDIAN REV: 1

IF YOU ARE USING A PRINTED COPY OF THIS DOCUMENT, IT IS AN UNCONTROLLED PRINT. CONFIRM WITH THE OFFICIAL "ELECTRONIC RECORD" DOCUMENT IN THE GLOBAL ENGINEERING CONTENT MANAGEMENT SYSTEM.

IF YOU ARE USING A PRINTED COPY OF THIS DOCUMENT, IT IS AN UNCONTROLLED PRINT. CONFIRM WITH THE OFFICIAL "ELECTRONIC RECORD" DOCUMENT IN THE GLOBAL ENGINEERING CONTENT MANAGEMENT SYSTEM.

3/17/2026 8:49:33 AM Autodesk Docs://2930007 - Hanson-Fluor Lilly/LP1/0Y-TFS-SIU-000-00-HNS.rvt

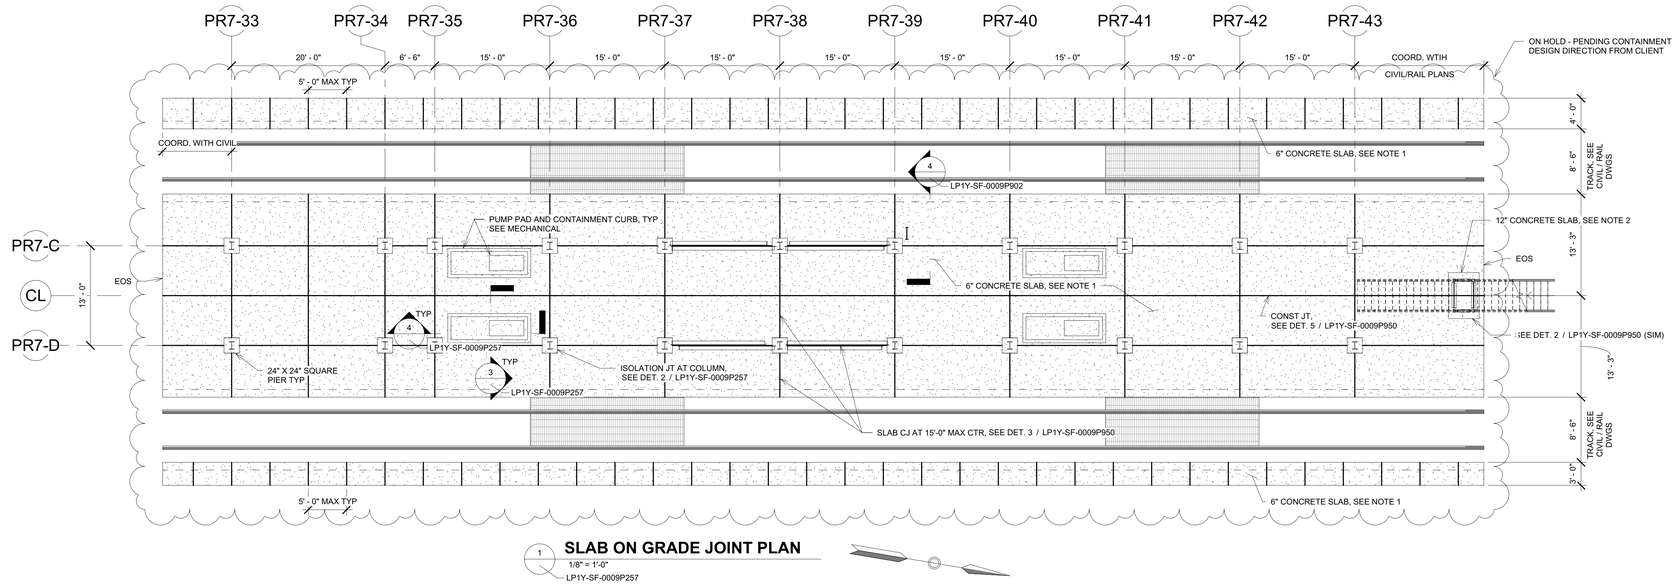


1 **SLAB ON GRADE JOINT PLAN**
1/8" = 1'-0"
LP1Y-SF-0009P257

NOTES:
1. 6" REINFORCED CONCRETE SLAB-ON-GRADE WITH #5 BARS @ 10" CTR EW AT 3" CLEAR FROM BOTTOM. PLACE SLAB OVER 6" COMPACTED AGGREGATE BASE AND PROOF-ROLLED SUBGRADE. SEE DETS. 3, 4, & 5 / LP1Y-SF-0009P950.
2. 12" REINFORCED CONCRETE SLAB-ON-GRADE WITH #5 BARS @ 10" CTR EW, T&B, 1 1/2" CLEAR FROM TOP OF SLAB AND 3" CLEAR FROM BOTTOM OF SLAB. PLACE SLAB OVER 6" COMPACTED AGGREGATE BASE AND PROOF-ROLLED SUBGRADE. SEE DETS. 3, 4, & 5 / LP1Y-SF-0009P950.
3. ALL CONCRETE SLABS-ON-GRADE SHALL BE COATED WITH REC1 - VINYL ESTER EXTERIOR SECONDARY CONTAINMENT COATING. REFER TO SPECIFICATION LP100-220-EMS-09672 "RESINOUS FLOORING". JOINTS SHALL BE FILLED PER THE FOLLOWING INSTRUCTIONS:
   1. FILL CONTROL JOINT/SAW-CUTS COMPLETELY WITH KEY JOINT FILLER.
   2. APPLY KEY #580 FLEXIBLE EPOXY OR KEY #400 URETHANE ELASTOMER OVER JOINT, EXTENDING TO APPROXIMATELY EIGHT TO TWELVE INCHES EACH SIDE OF THE JOINT. IMBED FIBERGLASS CLOTH OVER THAT WIDTH. THE TOTAL THICKNESS WILL BE 35-40 MILS.
   3. APPLY SPECIFIED SEAMLESS FLOORING SYSTEM OVER JOINT.

confirm applicability wih Rec1 - Vinyl coating with the vendor.

B2

REVIEWED
By:Homayoon S.,saf16975,January 21, 2026

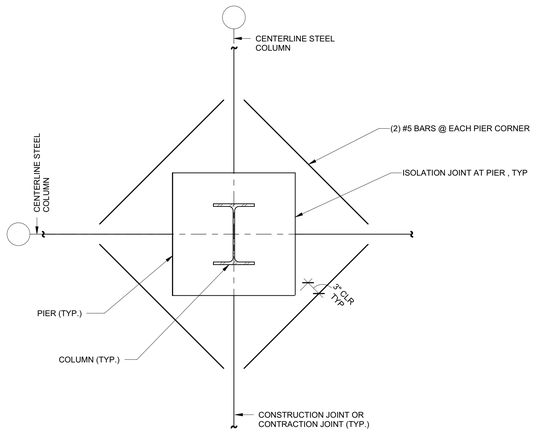

2 **TYPICAL COLUMN ISOLATION JOINT**
1" = 1'-0"
LP1Y-SF-0009P257


No Lilly comment

RD: Data is incomplete due to the DFT containment design option. Resubmit once design parameters are finalized.

B2 - DATA INCOMPLETE - WITH COMMENTS - PROCEED - RESUBMIT


Authorization to proceed does not relieve Contractor/Supplier of its responsibility or liability under the Contract and or Purchase Order.

By: Ricardo DaCosta dac54131 January 22, 2026

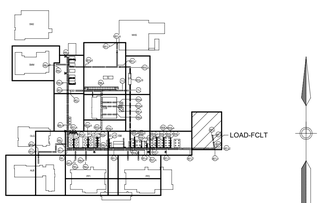


SITE - KEYPLAN

Shall be verified after containment design decision

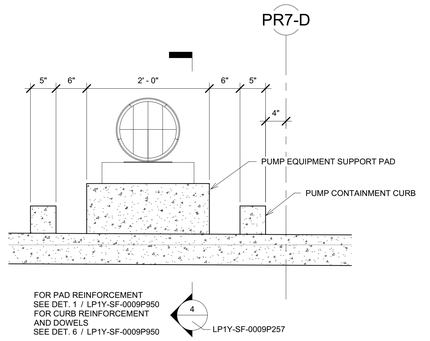

3 **SECTION AT PUMP PAD**
1" = 1'-0"
LP1Y-SF-0009P257

3
LP1Y-SF-0009P257

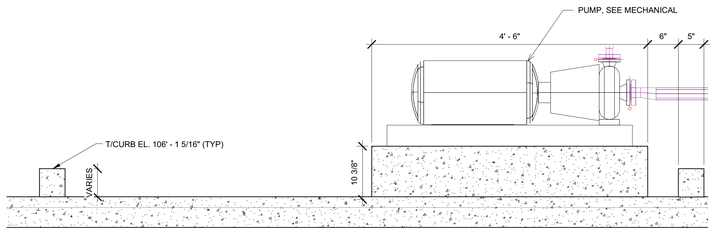

4 **SECTION AT PUMP PAD**
1" = 1'-0"
LP1Y-SF-0009P257

HANSON PROFESSIONAL SERVICES, INC.
www.hanson-inc.com
Offices Nationwide
11931 Wickchester Lane, Suite 370
Houston, TX 77043
(346) 297-1720

REV	DATE	DES	ENG	CHK	APP	PM APP
B	07-JAN-2026	RKN	SJS	FCB	FCB	SS
A	14-NOV-2025	RKN	SJS	FCB	RMF	SS

FOUNDATION JOINT PLAN

RAIL UNLOADING RACK

REV	ZONE	PROJECT NUMBER / DESCRIPTION	CHANGE CONTROL	DATE
B		ISSUED FOR REVIEW		07-JAN-2026
A		ISSUED FOR REVIEW		14-NOV-2025

REVISIONS

CONFIDENTIAL INFORMATION

THIS DRAWING AND THE IDEAS AND DESIGNS SHOWN THEREON ARE THE EXCLUSIVE PROPERTY OF ELI LILLY AND COMPANY AND ARE NOT TO BE USED, REPRODUCED OR DISCLOSED, EITHER IN WHOLE OR IN PART, WITHOUT THE WRITTEN CONSENT OF ELI LILLY AND COMPANY.


SYSTEM TYPE: NA		EDIFICE/BUILDING: UNLOADING RACK	LEVEL/FLOOR: 0
SUB DISCIPLINE: SF	LOCATION CODE: LP1	LOCATION/GRID: NA	CCI CODE: YELLOW
CRITICAL QUALITY		ENTERPRISE GROUP: API	DRAWING INTENTION
CRITICAL BUSINESS		EQUIPMENT CLASSIFICATION: NA	ALTERNATE DOCUMENT ID: NA
CRITICAL HSE		VENDOR: NA	DOCUMENT ID: LP1Y-SF-0009P257
NON-CRITICAL		ENGINEERING AGENCY DOC ID: NA	

PROJECT NAME: LP1-306-1181
DRAWING SCALE: As indicated
MERIDIAN REV: 0


1/7/2026 4:19:42 PM Autodesk Docs://2505007 - Hanson-Fluor Lilly/LP1/Y-TFS-SI/-000-000-93-HNS.rvt

IF YOU ARE USING A PRINTED COPY OF THIS DOCUMENT, IT IS AN UNCONTROLLED PRINT. CONFIRM WITH THE OFFICIAL "ELECTRONIC RECORD" DOCUMENT IN THE GLOBAL ENGINEERING CONTENT MANAGEMENT SYSTEM.


IF YOU ARE USING A PRINTED COPY OF THIS DOCUMENT, IT IS AN UNCONTROLLED PRINT. CONFIRM WITH THE OFFICIAL "ELECTRONIC RECORD" DOCUMENT IN THE GLOBAL ENGINEERING CONTENT MANAGEMENT SYSTEM.

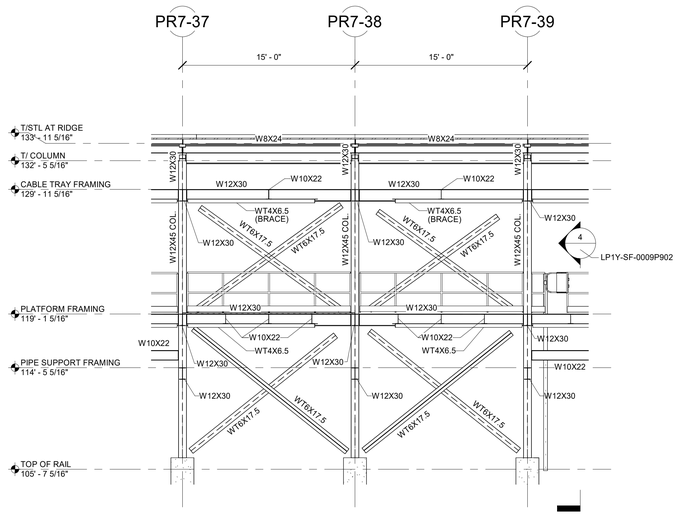

1 **SECTION AT FRAMING**
3/16" = 1'-0"
LP1Y-SF-0009P900

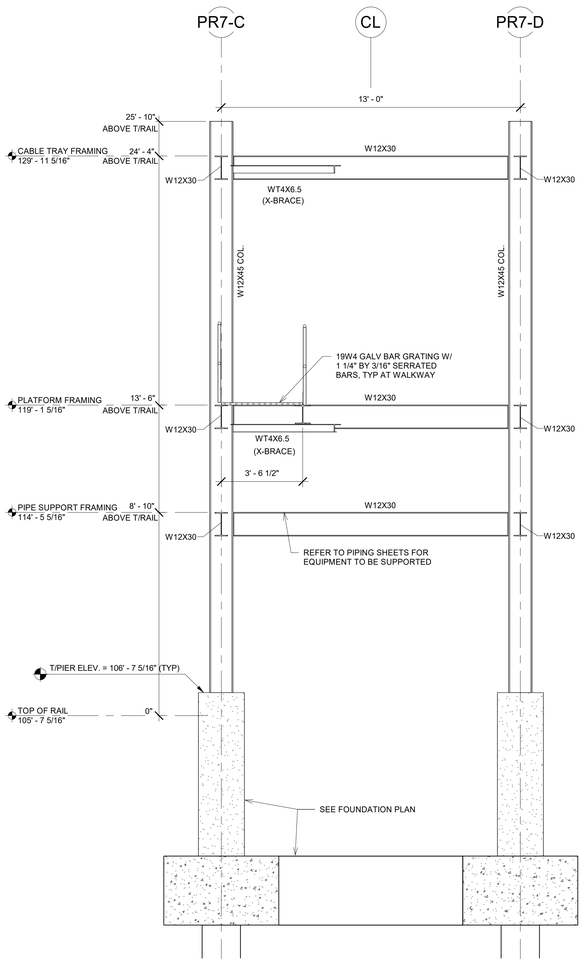

2 **TYPICAL FRAMING SECTION AT PIPE RACK**
3/8" = 1'-0"
LP1Y-SF-0009P900

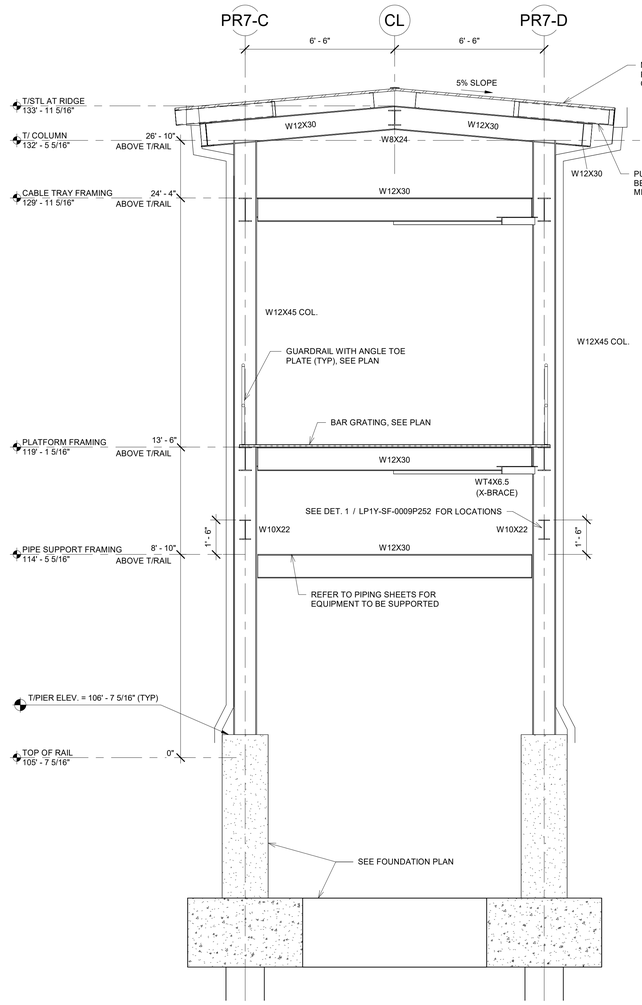

3 **TYPICAL FRAMING SECTION AT CANOPY**
3/8" = 1'-0"
LP1Y-SF-0009P900

A1- DATA COMPLETE - NO COMMENTS - DO NOT RESUBMIT

Authorization to proceed does not relieve Contractor/Supplier of its responsibility or liability under the Contract and or Purchase Order.

By dac54131 at Mar 23, 2026

NOTE:
SLAB-ON-GRADE AND SECONDARY CONTAINMENT SYSTEM NOT SHOWN

RYNE M. FIORITO
REGISTERED
PE12100177
STATE OF
INDIANA
PROFESSIONAL ENGINEER

HANSON PROFESSIONAL SERVICES, INC.
www.hanson-inc.com
Offices Nationwide
11931 Wickchester Lane, Suite 370
Houston, TX 77043
(346) 297-1720

REV	DATE	DES	ENG	CHK	APP	PM APP
1	17-MAR-2026	RKN	SJS	FCB	RMF	SS
0	20-FEB-2026	RKN	SJS	FCB	RMF	SS
C	07-JAN-2026	RKN	SJS	FCB	FCB	SS
B	14-NOV-2025	RKN	SJS	FCB	FCB	SS
A	10-OCT-2025	RKN	SJS	FCB	RMF	SS

Lilly

UNLOADING RACK SECTIONS

RAIL UNLOADING RACK

REV	ZONE	PROJECT NUMBER / DESCRIPTION	CHANGE CONTROL	DATE
1		ISSUED FOR CONSTRUCTION		17-MAR-2026
0		ISSUED FOR CONSTRUCTION		20-FEB-2026
C		ISSUED FOR REVIEW		07-JAN-2026
B		ISSUED FOR REVIEW		14-NOV-2025
A		ISSUED FOR REVIEW		10-OCT-2025


REVISIONS

CONFIDENTIAL INFORMATION
THIS DRAWING AND THE IDEAS AND DESIGNS SHOWN THEREON ARE THE EXCLUSIVE PROPERTY OF ELI LILLY AND COMPANY AND ARE NOT TO BE USED, REPRODUCED OR DISCLOSED, EITHER IN WHOLE OR IN PART, WITHOUT THE WRITTEN CONSENT OF ELI LILLY AND COMPANY.

SYSTEM TYPE: NA			EDIFICE/BUILDING: UNLOADING RACK; LEVEL/FLOOR: 0
SUB DISCIPLINE: SF	LOCATION CODE: LP1	LOCATION/GRID: NA	CCI CODE: YELLOW; PROJECT NAME:
CRITICAL QUALITY:		ENTERPRISE GROUP: API	DRAWING INTENTION: ; DRAWING SCALE: NONE
CRITICAL BUSINESS:		EQUIPMENT CLASSIFICATION: NA	ALTERNATE DOCUMENT ID: NA; MERIDIAN REV: 0
CRITICAL HSE:		VENDOR: NA	DOCUMENT ID: LP1Y-SF-0009P900
NON-CRITICAL:		ENGINEERING AGENCY DOC ID: NA	

IF YOU ARE USING A PRINTED COPY OF THIS DOCUMENT, IT IS AN UNCONTROLLED PRINT. CONFIRM WITH THE OFFICIAL "ELECTRONIC RECORD" DOCUMENT IN THE GLOBAL ENGINEERING CONTENT MANAGEMENT SYSTEM.

IF YOU ARE USING A PRINTED COPY OF THIS DOCUMENT, IT IS AN UNCONTROLLED PRINT. CONFIRM WITH THE OFFICIAL "ELECTRONIC RECORD" DOCUMENT IN THE GLOBAL ENGINEERING CONTENT MANAGEMENT SYSTEM.

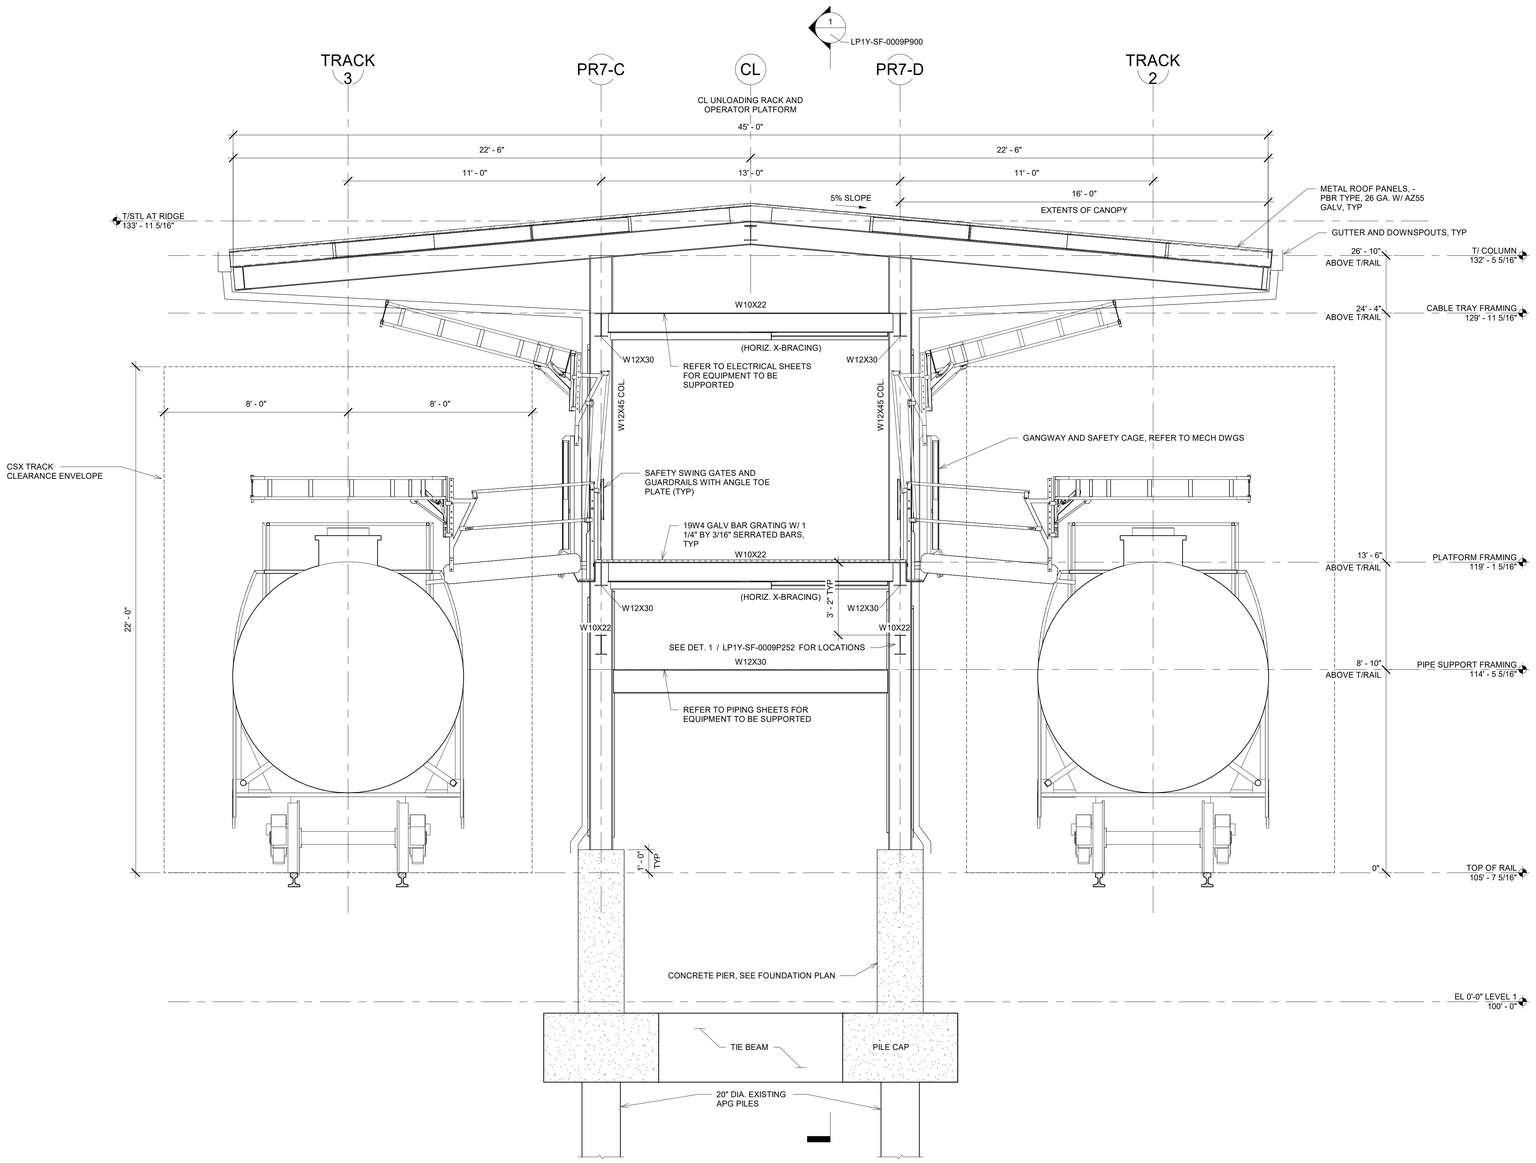

TYPICAL UNLOADING RACK SECTION AT EXTENDED CANOPY (LOOKING NORTH)

1 — 3/8" = 1'-0"
LP1Y-SF-0009P901

A1- DATA COMPLETE - NO COMMENTS - DO NOT RESUBMIT

Authorization to proceed does not relieve Contractor/Supplier of its responsibility or liability under the Contract and or Purchase Order.

By dac54131 at Mar 23, 2026

NOTE:
SLAB-ON-GRADE AND SECONDARY CONTAINMENT SYSTEM NOT SHOWN

RYNE M. FIORITO REGISTERED PE12100177 STATE OF INDIANA PROFESSIONAL ENGINEER

HANSON PROFESSIONAL SERVICES, INC.
www.hanson-inc.com
Offices Nationwide
11931 Wickchester Lane, Suite 370
Houston, TX 77043
(345) 297-1720

REV	DATE	DES	ENG	CHK	APP	PM APP
1	17-MAR-2026	RKN	SJS	FCB	RMF	SS
0	20-FEB-2026	RKN	SJS	FCB	RMF	SS
B	14-NOV-2025	RKN	SJS	FCB	FCB	SS
A	10-OCT-2025	RKN	SJS	FCB	RMF	SS

Lilly

UNLOADING RACK SECTIONS

RAIL UNLOADING RACK

REV	ZONE	PROJECT NUMBER / DESCRIPTION	CHANGE CONTROL	DATE
1		ISSUED FOR CONSTRUCTION		17-MAR-2026
0		ISSUED FOR CONSTRUCTION		20-FEB-2026
B		ISSUED FOR REVIEW		14-NOV-2025
A		ISSUED FOR REVIEW		10-OCT-2025

REVISIONS


SYSTEM TYPE: NA		EDIFICE/BUILDING: UNLOADING RACK	LEVEL/FLOOR: 0
SUB DISCIPLINE: SF	LOCATION CODE: LP1	LOCATION/GRID: NA	CCI CODE: YELLOW
CRITICAL QUALITY		ENTERPRISE GROUP: API	DRAWING INTENTION
CRITICAL BUSINESS		EQUIPMENT CLASSIFICATION: NA	ALTERNATE DOCUMENT ID: NA
CRITICAL HSE		VENDOR: NA	DOCUMENT ID: LP1Y-SF-0009P901
NON-CRITICAL		ENGINEERING AGENCY DOC ID: NA	

PROJECT NAME: NONE
DRAWING SCALE: NONE
MERIDIAN REV: 0


CONFIDENTIAL INFORMATION
THIS DRAWING AND THE IDEAS AND DESIGNS SHOWN THEREON ARE THE EXCLUSIVE PROPERTY OF ELI LILLY AND COMPANY AND ARE NOT TO BE USED, REPRODUCED OR DISCLOSED, EITHER IN WHOLE OR IN PART, WITHOUT THE WRITTEN CONSENT OF ELI LILLY AND COMPANY.

IF YOU ARE USING A PRINTED COPY OF THIS DOCUMENT, IT IS AN UNCONTROLLED PRINT. CONFIRM WITH THE OFFICIAL "ELECTRONIC RECORD" DOCUMENT IN THE GLOBAL ENGINEERING CONTENT MANAGEMENT SYSTEM.


IF YOU ARE USING A PRINTED COPY OF THIS DOCUMENT, IT IS AN UNCONTROLLED PRINT. CONFIRM WITH THE OFFICIAL "ELECTRONIC RECORD" DOCUMENT IN THE GLOBAL ENGINEERING CONTENT MANAGEMENT SYSTEM.

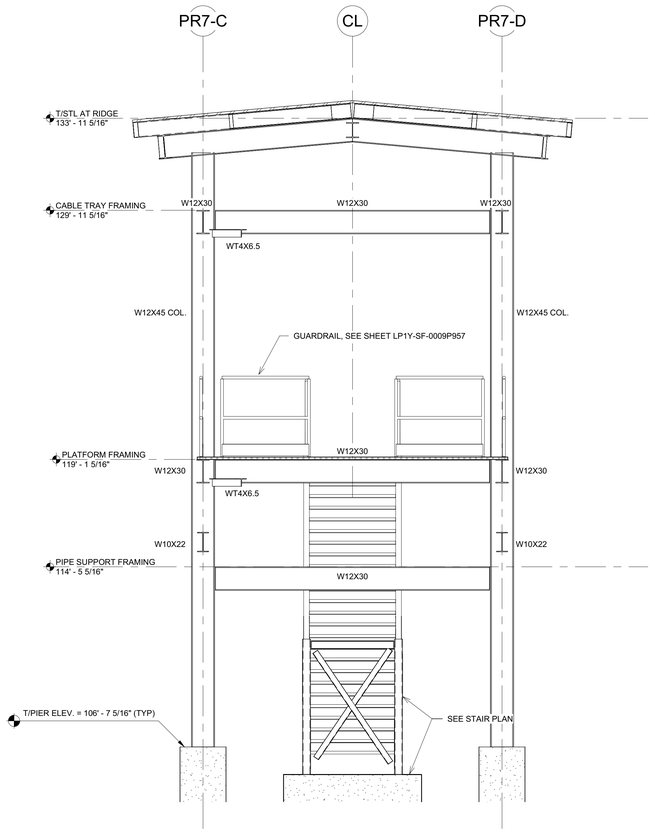


1 **ELEVATION AT NORTH END**
3/8" = 1'-0"
LP1Y-SF-0009P902

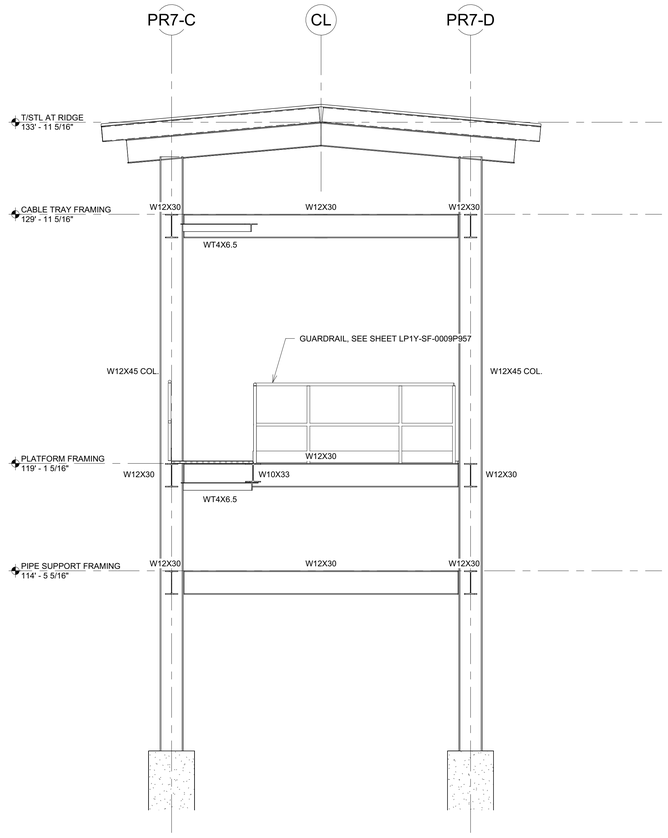

2 **SECTION AT CATWALK**
3/8" = 1'-0"
LP1Y-SF-0009P902

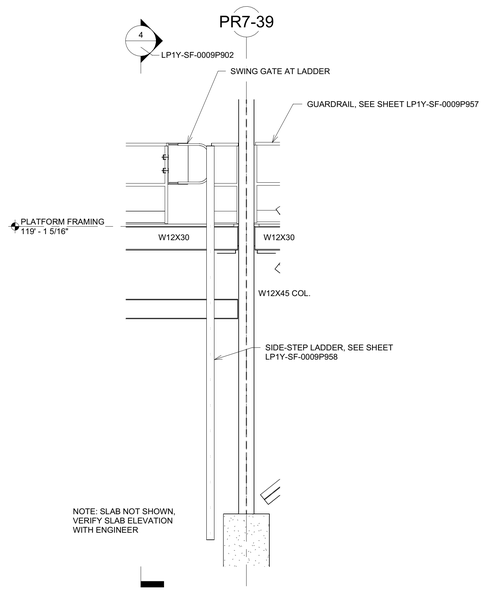

3 **ELEVATION AT LADDER**
3/8" = 1'-0"
LP1Y-SF-0009P902

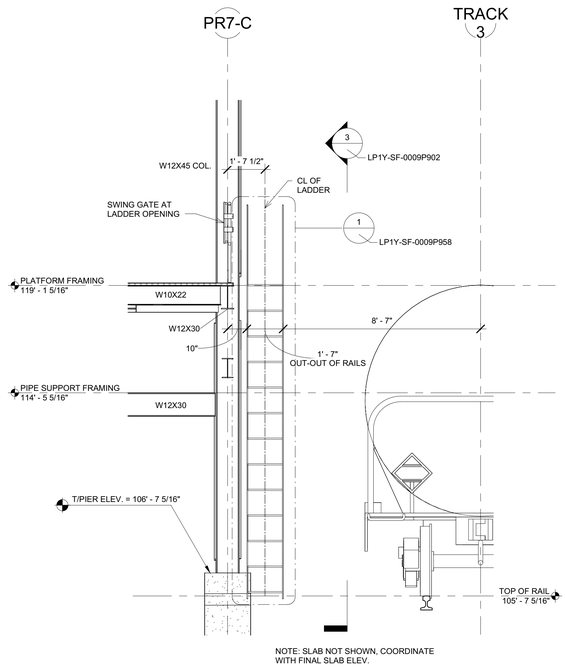

4 **SECTION AT LADDER**
3/8" = 1'-0"
LP1Y-SF-0009P902

NOTE:
SLAB-ON-GRADE AND SECONDARY CONTAINMENT SYSTEM NOT SHOWN

A1 - DATA COMPLETE - NO COMMENTS - DO NOT RESUBMIT
Authorization to proceed does not relieve Contractor/Supplier of its responsibility or liability under the Contract and or Purchase Order.
By: Ricardo DaCosta dac54131 April 6, 2026

RYNE M. FIORITO REGISTERED PE12100177 STATE OF INDIANA PROFESSIONAL ENGINEER

HANSON PROFESSIONAL SERVICES, INC.
www.hanson-inc.com
Offices Nationwide

11931 Wickchester Lane, Suite 370
Houston, TX 77043
(346) 297-1720

REV	DATE	DES	ENG	CHK	APP	PM APP
A	20-FEB-2026	RKN	SJS	FCB	RMF	SS
B	07-JAN-2026	RKN	SJS	FCB	FCB	SS
0	14-NOV-2025	RKN	SJS	FCB	RMF	SS

GUARDRAIL AND LADDER SECTIONS

RAIL UNLOADING RACK

REV	ZONE	PROJECT NUMBER / DESCRIPTION	CHANGE CONTROL	DATE
0		ISSUED FOR CONSTRUCTION		20-FEB-2026
B		ISSUED FOR REVIEW		07-JAN-2026
A		ISSUED FOR REVIEW		14-NOV-2025

REVISIONS


CONFIDENTIAL INFORMATION
THIS DRAWING AND THE IDEAS AND DESIGNS SHOWN THEREON ARE THE EXCLUSIVE PROPERTY OF ELI LILLY AND COMPANY AND ARE NOT TO BE USED, REPRODUCED OR DISCLOSED, EITHER IN WHOLE OR IN PART, WITHOUT THE WRITTEN CONSENT OF ELI LILLY AND COMPANY.

SYSTEM TYPE: NA		EDIFICE/BUILDING: UNLOADING RACK	LEVEL/FLOOR: 0
SUB DISCIPLINE: SF	LOCATION CODE: LP1	LOCATION/GRID: NA	CCI CODE: YELLOW
CRITICAL QUALITY:		ENTERPRISE GROUP: API	DRAWING INTENTION:
CRITICAL BUSINESS:		EQUIPMENT CLASSIFICATION: NA	ALTERNATE DOCUMENT ID: NA
CRITICAL HSE:		VENDOR: NA	DOCUMENT ID: LP1Y-SF-0009P902
NON-CRITICAL:		ENGINEERING AGENCY DOC ID: NA	

PROJECT NAME:
DRAWING SCALE: NONE
MERIDIAN REV: 0

IF YOU ARE USING A PRINTED COPY OF THIS DOCUMENT, IT IS AN UNCONTROLLED PRINT. CONFIRM WITH THE OFFICIAL "ELECTRONIC RECORD" DOCUMENT IN THE GLOBAL ENGINEERING CONTENT MANAGEMENT SYSTEM.


IF YOU ARE USING A PRINTED COPY OF THIS DOCUMENT, IT IS AN UNCONTROLLED PRINT. CONFIRM WITH THE OFFICIAL "ELECTRONIC RECORD" DOCUMENT IN THE GLOBAL ENGINEERING CONTENT MANAGEMENT SYSTEM.

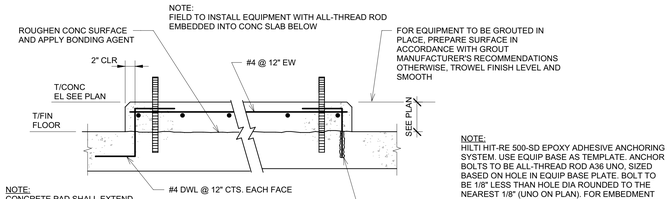

DIA	EMBEDMENT
1/4"	5"
3/8"	5"
1/2"	5"
5/8"	6"
3/4"	7"
7/8"	8"
1"+	SEE PLAN


MISC CONC PAD FOR EQUIPMENT ETC

1 **DETAIL**

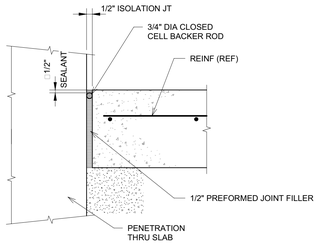

ISOLATION JOINT FOR SLAB ON GRADE


2 **DETAIL**

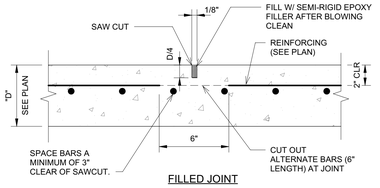

FILLED JOINT

NOTE:
SAW CUT AS SOON AS CONCRETE HAS HARDENED SUFFICIENTLY TO PREVENT DISLODGING OF AGGREGATE (MINIMUM OF 4 HOURS AFTER PLACEMENT) USING A SOFT-CUT SAW. COMPLETE CUTTING BEFORE SHRINKAGE INDUCES CRACKING (MAXIMUM 12 HOURS AFTER PLACEMENT). SEAL JOINT. (JOINT MAY BE FORMED AT CONTRACTOR'S OPTION)

3 **TYPICAL CONTROL JOINT**

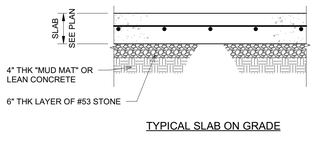


TYPICAL SLAB ON GRADE

4 **DETAIL**

NOTES:

1. FOR GENERAL NOTES, DESIGN CRITERIA, AND STANDARDS, REFER TO DRAWING LP1Y-SF-0009P001.
2. DOWELS MUST BE CAREFULLY ALIGNED AND SUPPORTED IN CONCRETE POURS TO MINIMIZE CRACKING.

Lilly comment: EMM 20Jan2026
Note scale (TYP)

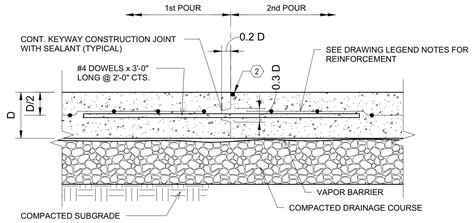


SLAB NOTES:

1. CONSTRUCTION JOINTS SHALL BE PLACED SO SLAB POURS DO NOT EXCEED 2,500 SQ. FT. ADDITIONAL CONSTRUCTION OR CONTRACTION JOINTS SHALL BE PLACED SO SLAB POURS DO NOT EXCEED 250 SQ. FT. CONTRACTOR SHALL SUBMIT SLAB POURING SEQUENCE AND JOINT PATTERN TO THE ENGINEER FOR APPROVAL.
2. CONTRACTION JOINTS MAY BE SAWED JOINTS OR MADE WITH PLASTIC INSERTS (.25D MIN. DEPTH). FILL ALL JOINTS WITH SEALANT. SAWING TO BE COMPLETED WITHIN THE FIRST 12 HOURS.
3. CONSTRUCTION AND CONTRACTION JOINTS PARALLEL WITH THICKENED SLABS SHOULD OCCUR OUTSIDE THE LIMITS OF THE THICKENED SLAB.

TYPICAL SLAB ON GRADE CONSTRUCTION JOINT

5

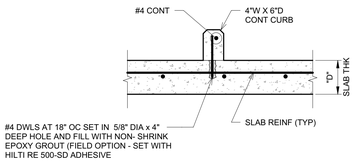

SLAB-ON-GRADE CURB DETAIL

6

B1 - DATA COMPLETE - WITH COMMENTS - PROCEED - RESUBMIT
Authorization to proceed does not relieve Contractor/Supplier of its responsibility or liability under the Contract and or Purchase Order.
By: Ricardo Dacosta dac54131 January 22, 2026

REVIEWED
By:Homayoon S.,saf16975,January 21, 2026

HANSON PROFESSIONAL SERVICES, INC.
www.hanson-inc.com
Offices Nationwide
11931 Wickchester Lane, Suite 370
Houston, TX 77043
(346) 297-1720

REV	DATE	DES	ENG	CHK	APP	PM APP
C	07-JAN-2026	RKN	SJS	FCB	FCB	SS
B	14-NOV-2025	RKN	SJS	FCB	FCB	SS
A	10-OCT-2025	RKN	SJS	FCB	RMF	SS

FOUNDATION DETAILS

RAIL UNLOADING RACK

REV	ZONE	PROJECT NUMBER / DESCRIPTION	CHANGE CONTROL	DATE
C		ISSUED FOR REVIEW		07-JAN-2026
B		ISSUED FOR REVIEW		14-NOV-2025
A		ISSUED FOR REVIEW		10-OCT-2025

REVISIONS

CONFIDENTIAL INFORMATION
THIS DRAWING AND THE IDEAS AND DESIGNS SHOWN THEREON ARE THE EXCLUSIVE PROPERTY OF ELI LILLY AND COMPANY AND ARE NOT TO BE USED, REPRODUCED OR DISCLOSED, EITHER IN WHOLE OR IN PART, WITHOUT THE WRITTEN CONSENT OF ELI LILLY AND COMPANY.

SYSTEM TYPE: NA			EDIFICE/BUILDING: UNLOADING RACK; LEVEL/FLOOR: 0
SUB DISCIPLINE: SF	LOCATION CODE: LP1	LOCATION/GRID: NA	CCI CODE: YELLOW; PROJECT NAME:
CRITICAL QUALITY		ENTERPRISE GROUP: API	DRAWING INTENTION; DRAWING SCALE: NONE
CRITICAL BUSINESS		EQUIPMENT CLASSIFICATION: NA	ALTERNATE DOCUMENT ID: NA; MERIDIAN REV: 0
CRITICAL HSE		VENDOR: NA	DOCUMENT ID: LP1Y-SF-0009P950
NON-CRITICAL		ENGINEERING AGENCY DOC ID: NA	


IF YOU ARE USING A PRINTED COPY OF THIS DOCUMENT, IT IS AN UNCONTROLLED PRINT. CONFIRM WITH THE OFFICIAL "ELECTRONIC RECORD" DOCUMENT IN THE GLOBAL ENGINEERING CONTENT MANAGEMENT SYSTEM.

IF YOU ARE USING A PRINTED COPY OF THIS DOCUMENT, IT IS AN UNCONTROLLED PRINT. CONFIRM WITH THE OFFICIAL "ELECTRONIC RECORD" DOCUMENT IN THE GLOBAL ENGINEERING CONTENT MANAGEMENT SYSTEM.

A1- DATA COMPLETE - NO COMMENTS - DO NOT RESUBMIT


Authorization to proceed does not relieve Contractor/Supplier of its responsibility or liability under the Contract and or Purchase Order.

By dac54131 at Apr 15, 2026

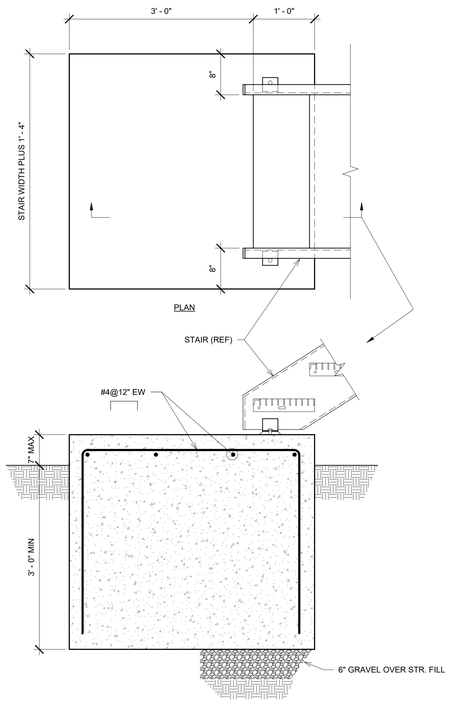


1 ISOLATED STAIR PAD DETAIL

1" = 1'-0"
LP1Y-SF-0009P951

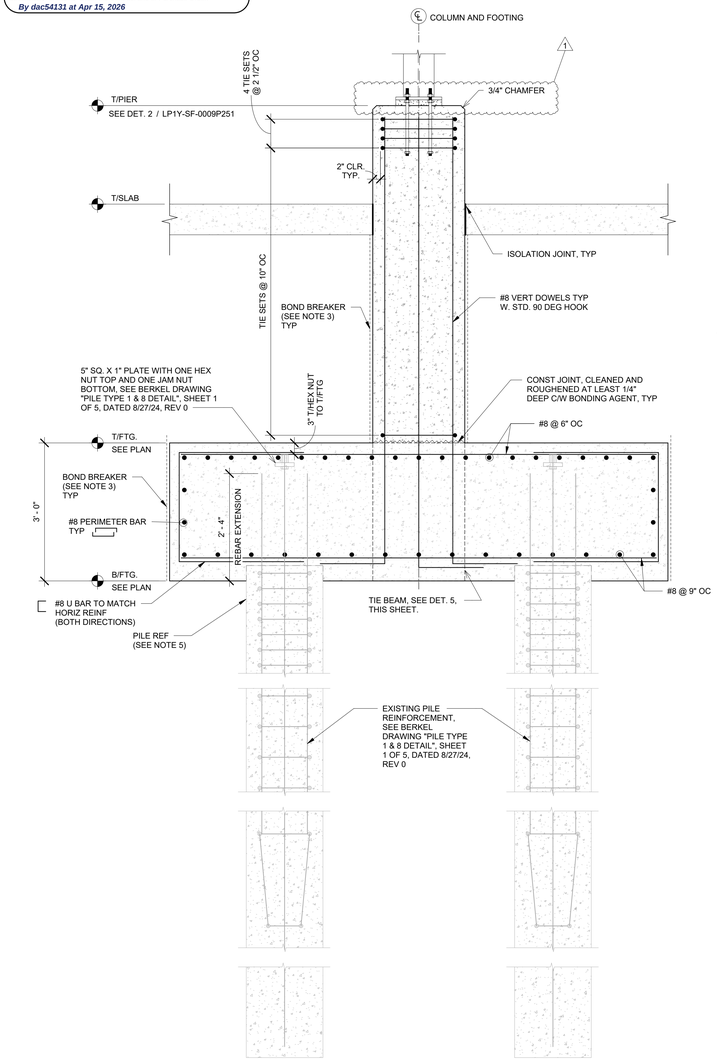

2 TYP FOOTING AT COLUMN WITH PIER DETAIL

3/4" = 1'-0"
LP1Y-SF-0009P951

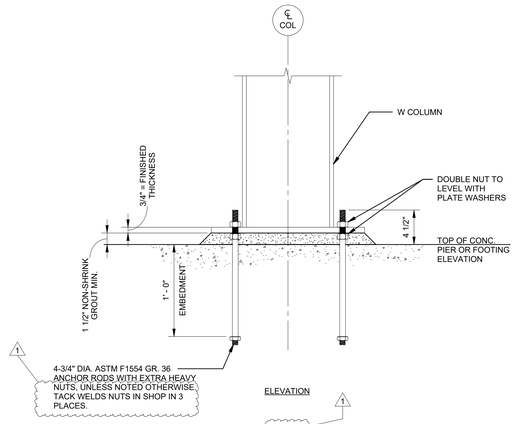

3 BASE PLATE AND ANCHOR DETAIL

1 1/2" = 1'-0"
LP1Y-SF-0009P951

SHEET NOTES:

1. FOR GENERAL NOTES, DESIGN CRITERIA, DRAWING LIST, ABBREVIATIONS AND STANDARDS, REFER TO DRAWINGS LP1Y-SF-0009P001 AND LP100-215-EMS-03001 "PLAIN AND REINFORCED CONCRETE".
2. FOR GROUNDING DETAILS, REFER TO ELECTRICAL DRAWINGS. FOR GROUNDING LOCATION REFER TO FOUNDATION PLAN DRAWINGS.
3. FROST JACKING BOND BREAKER SHALL:
   A. CONFORM TO A SINGLE LAYER OF 30 MIL LINEAR LOW-DENSITY POLYETHYLENE (LLDPE) MATERIAL OR APPROVED EQUIVALENT.
   B. EXTENT AS INDICATED ON DESIGN DRAWINGS.
   C. BE FIXED AGAINST VERTICAL SURFACES OF CONCRETE WITH ADHESIVE COMPATIBLE TO BOTH CONCRETE AND BOND BREAKER. ADHESIVE SHALL BE DURABLE TO WITHSTAND LOW AND HIGH TEMPERATURES AND SUITABLE FOR APPLICATIONS IN HIGH WATERTABLE.
   D. BE INSTALLED WITH MANUFACTURER'S WRITTEN SPECIFICATION AND INSTRUCTION. LAP SPLICING SHALL BE BY SOLVENT ADHESIVE.
4. PILING CUT OFF ELEVATION SHALL BE WITHIN +0" AND -1".


ANCHOR BOLT NOTES:

ANCHOR BOLT MATERIAL CRITERIA

1. ANCHOR BOLT MATERIAL SHALL CONFORM TO ASTM F1554, 36 KSI, UNLESS NOTED OTHERWISE.
2. NUTS SHALL BE IN ACCORDANCE WITH ASME/ANSI B18.2.2 HEAVY HEX AND CONFORM TO ASTM A563.
3. WASHERS SHALL CONFORM TO ASTM F436.
4. STANDARD CUT WASHERS SHALL BE FURNISHED WITH ANCHOR BOLTS.
5. WELDING SHALL CONFORM TO AWS D1.1 WITH CLASS E70XX ELECTRODES CONFORMING TO AWS A5.1.
6. ANCHOR BOLT SLEEVES, FOR BOLTS THROUGH 5" DIAMETER, SHALL BE WILSON ANCHOR BOLT SLEEVES AS MANUFACTURED BY THE WILSON ANCHOR BOLT SLEEVE COMPANY, OR APPROVED SUBSTITUTE. CUT OFF TOP OF SLEEVE BEFORE SETTING EQUIPMENT OR BASE.
7. THREADS SHALL BE COARSE THREAD SERIES (UNC) FOR ALL ANCHOR BOLTS. THREADS SHALL CONFORM TO ASME/ANSI B1.1 HAVING A CLASS 2A TOLERANCE FOR BOLTS AND A CLASS 2B TOLERANCE FOR NUTS.
8. UNLESS OTHERWISE SPECIFIED, ALL BOLTS, NUTS AND WASHERS SHALL BE HOT-DIP GALVANIZED AFTER FABRICATION IN ACCORDANCE WITH ASTM A123. EXCESS GALVANIZING MATERIAL SHALL BE REMOVED FROM THE THREADED PORTIONS OF THE BOLT BY THE USE OF A CENTRIFUGE OR BY MECHANICAL CHASING OF THE BOLT THREADS.


INSTALLATION

1. ANCHOR BOLTS SHALL BE INSTALLED IN ACCORDANCE WITH THE DESIGN DRAWINGS AND TO THE REQUIREMENTS AND TOLERANCES SPECIFIED IN PARAGRAPH 7.5 OF THE AISC CODE OF STANDARD PRACTICE. SPECIFICALLY, INDIVIDUAL ANCHOR BOLTS MUST NOT VARY FROM THE DIMENSIONS SHOWN ON THE DESIGN DRAWINGS BY MORE THAN THE FOLLOWING:
   A. CENTER-TO-CENTER OF ANY TWO BOLTS WITHIN A BOLT GROUP: +/- 1/8"
   B. CENTER-TO-CENTER BETWEEN ADJACENT BOLT GROUPS: +/- 1/4"
   C. BOLT PROJECTION: + 1/4" - 0"
   D. PLUMBNESS: +/- 1/8" IN 3'-0"
   E. REFER TO AISC CODE OF STANDARD PRACTICE FOR ADDITIONAL CUMULATIVE TOLERANCES FOR BOLT GROUPS.
2. ANCHOR BOLTS SHALL BE TIGHTENED TO SNUG CONDITION EXCEPT WHERE TORQUE VALUE IS SPECIFIED ON THE DESIGN DRAWINGS, OR AT THE LOCATIONS OF SLIDE PLATES. AT SLIDE PLATE LOCATIONS, TWO NUTS ARE REQUIRED. THE LOWER NUT SHALL BE HAND TIGHTENED AND THEN BACKED OFF A HALF TURN LEAVING APPROXIMATELY 1/16" CLEARANCE BETWEEN THE LOWER NUT AND THE BASE PLATE. THE UPPER NUT SHALL BE INSTALLED AND JAMMED AGAINST THE FIRST NUT.
3. ANCHOR BOLTS SHALL NOT BE REPAIRED, REPLACED OR FIELD MODIFIED WITHOUT THE APPROVAL OF THE PROJECT STRUCTURAL ENGINEER OF RECORD. FOR REFERENCE SEE OSHA REGULATION 1926.755.
4. UNLESS NOTED OTHERWISE ON DESIGN DRAWINGS, ANCHOR BOLT SLEEVES FOR STATIONARY EQUIPMENT AND STRUCTURAL BASE PLATES SHALL BE FILLED WITH GROUT AFTER THE COLUMN OR EQUIPMENT IS IN PLACE AND THE ANCHOR BOLTS ARE ALIGNED. WATER OR OTHER LOOSE PARTICLES SHALL NOT BE ALLOWED TO COLLECT IN THE SLEEVE BEFORE THE SLEEVE IS GROUTED.
5. CERTIFIED MILL TEST REPORTS SHALL BE SUBMITTED FOR INDIVIDUAL ANCHOR BOLT COMPONENTS.
6. SLEEVED BOLTS SHALL BE USED FOR SPHERES, VERTICAL VESSELS, PUMPS, COMPRESSORS, SHOP ASSEMBLED HEATERS AND BOILERS, FREE STANDING STACKS AND WHERE RECOMMENDED BY EQUIPMENT MANUFACTURERS OR AS DESIGNATED ON THE DRAWINGS.
7. PROVIDE ONE NUT AT EACH ANCHOR BOLT UNLESS NOTED OTHERWISE ON THE DESIGN DRAWING.
8. ANCHOR BOLTS SHALL HAVE A TAG WITH THE ANCHOR BOLT MARK NUMBER ENGRAVED ON THE TAG. THE MARK NUMBER SHALL CORRESPOND TO THE BUILDING NAME AND COLUMN NUMBER OR EQUIPMENT NUMBER.

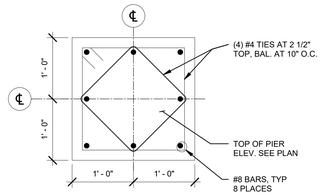


4 PIER DETAIL 1

1" = 1'-0"
LP1Y-SF-0009P951

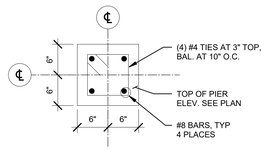


6 PIER DETAIL 2

1" = 1'-0"
LP1Y-SF-0009P951

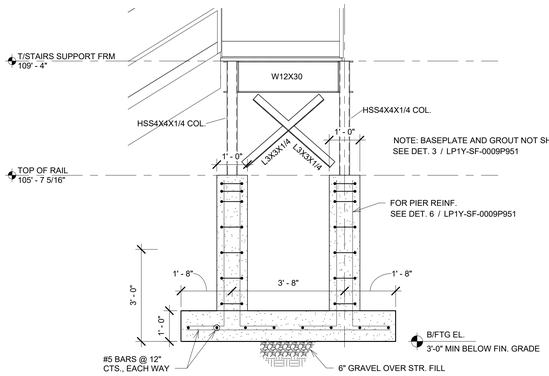


7 SECTION AT STAIR POSTS

1/2" = 1'-0"
LP1Y-SF-0009P951

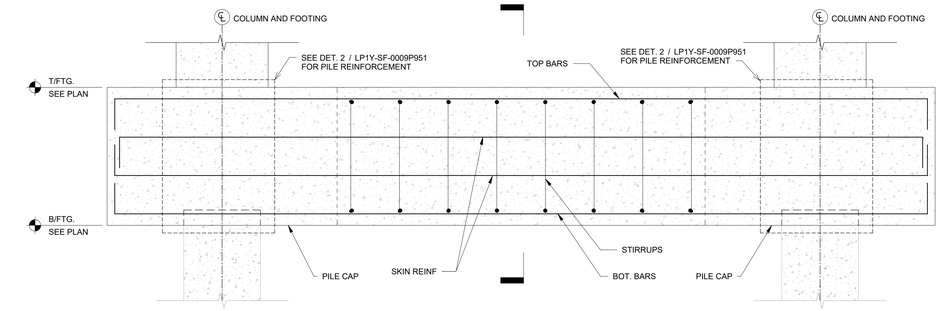

5 TYP GRADE BEAM ELEVATION

3/4" = 1'-0"
LP1Y-SF-0009P951

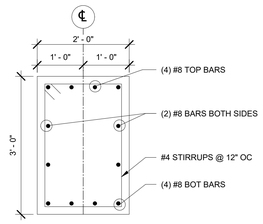

SECTION

NOTE:
SLAB-ON-GRADE AND SECONDARY CONTAINMENT SYSTEM NOT SHOWN

RYNE M. FIORITO REGISTERED PE12100177 STATE OF INDIANA PROFESSIONAL ENGINEER

HANSON™

HANSON PROFESSIONAL SERVICES, INC.
www.hanson-inc.com
Offices Nationwide

11931 Wickchester Lane, Suite 370
Houston, TX 77043
(346) 297-1720

REV	DATE	DES	ENG	CHK	APP	PM APP
2	10-APR-2026	RKN	SJS	FCB	RMF	SS
1	03-APR-2026	RKN	SJS	FCB	RMF	SS
0	20-FEB-2026	RKN	SJS	FCB	RMF	SS
C	07-JAN-2026	RKN	SJS	FCB	FCB	SS
B	14-NOV-2025	RKN	SJS	FCB	FCB	SS

Lilly

FOUNDATION DETAILS

RAIL UNLOADING RACK

REV	ZONE	PROJECT NUMBER / DESCRIPTION	CHANGE CONTROL	DATE
2		ISSUED FOR CONSTRUCTION		10-APR-2026
1		ISSUED FOR CONSTRUCTION		03-APR-2026
0		ISSUED FOR CONSTRUCTION		20-FEB-2026
C		ISSUED FOR REVIEW		07-JAN-2026
B		ISSUED FOR REVIEW		14-NOV-2025

REVISIONS

CONFIDENTIAL INFORMATION
THIS DRAWING AND THE IDEAS AND DESIGNS SHOWN THEREON ARE THE EXCLUSIVE PROPERTY OF ELI LILLY AND COMPANY AND ARE NOT TO BE USED, REPRODUCED OR DISCLOSED, EITHER IN WHOLE OR IN PART, WITHOUT THE WRITTEN CONSENT OF ELI LILLY AND COMPANY.

SYSTEM TYPE: NA		EDIFICE/BUILDING: UNLOADING RACK	LEVEL/FLOOR: 0
SUB DISCIPLINE: SF	LOCATION CODE: LP1	LOCATION/GRID: NA	CCI CODE: YELLOW
CRITICAL QUALITY:		ENTERPRISE GROUP: API	DRAWING INTENTION:
CRITICAL BUSINESS:		EQUIPMENT CLASSIFICATION: NA	ALTERNATE DOCUMENT ID: NA
CRITICAL HSE:		VENDOR: NA	DOCUMENT ID: LP1Y-SF-0009P951
NON-CRITICAL:		ENGINEERING AGENCY DOC ID: NA	


PROJECT NAME:
DRAWING SCALE: NONE
MERIDIAN REV: 2

IF YOU ARE USING A PRINTED COPY OF THIS DOCUMENT, IT IS AN UNCONTROLLED PRINT. CONFIRM WITH THE OFFICIAL "ELECTRONIC RECORD" DOCUMENT IN THE GLOBAL ENGINEERING CONTENT MANAGEMENT SYSTEM.


IF YOU ARE USING A PRINTED COPY OF THIS DOCUMENT, IT IS AN UNCONTROLLED PRINT. CONFIRM WITH THE OFFICIAL "ELECTRONIC RECORD" DOCUMENT IN THE GLOBAL ENGINEERING CONTENT MANAGEMENT SYSTEM.

NOTES:


1. FOR GENERAL NOTES, DESIGN CRITERIA, AND STANDARDS, REFER TO DRAWING LP1Y-SF-0009P001.
2. WHEN TWO STRUCTURAL MEMBERS ON OPPOSITE SIDES OF A COLUMN WEB, OR A BEAM WEB OVER A COLUMN, ARE CONNECTED SHARING COMMON CONNECTION HOLES, AT LEAST ONE BOLT WITH ITS WRENCH TIGHT NUT SHALL REMAIN CONNECTED TO THE FIRST MEMBER UNLESS A SHOP ATTACHED OR FIELD ATTACHED SEAT OR EQUIVALENT CONNECTION DEVICE IS SUPPLIED WITH THE MEMBER TO SECURE THE FIRST MEMBER AND PREVENT THE COLUMN FROM BEING DISPLACED. OSHA REGULATION 1926.756(C)(1).
3. SEAT ANGLE SHALL BE DESIGNED TO SUPPORT THE LOAD DURING THE DOUBLE CONNECTION PROCESS. IT SHALL BE FIELD BOLTED TO BOTH THE SUPPORTING MEMBER AND THE FIRST MEMBER BEFORE THE NUTS ON THE SHARED BOLTS ARE REMOVED TO MAKE THE DOUBLE CONN-ECTION. SEAT ANGLE MAY BE REMOVED AFTER CONNECTION INSTALL-ATION IS COMPLETE.
4. CONNECTIONS SHOW VARIOUS NUMBERS OF BOLTS. FABRICATOR SHALL PROVIDE CONNECTIONS AS REQUIRED TO DEVELOP FORCES SHOWN ON DRAWINGS. CONNECTIONS SHALL BE MADE WITH A MINIMUM OF 2 BOLTS ALONG THE LONGITUDINAL AXIS OF THE MEMBER.
5. MINIMUM GUSSET PLATE THICKNESS SHALL BE 3/8".
6. BRACING WORK POINTS (WP) SHOWN ARE TYPICAL UNLESS NOTED OTHERWISE. COORDINATE WORK POINT LOCATIONS ON THIS DRAWING WITH DESIGN DRAWINGS.
7. FABRICATOR MAY SUBMIT, FOR ENGINEERING APPROVAL, ALTERNATE CONNECTION DETAILS.
8. LOOSE PIECES SHALL BE WIRED OR SOFT BOLTED TO STRUCTURAL MEMBERS FOR SHIPMENT.

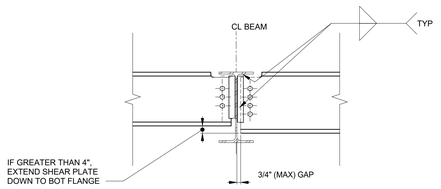


1 **TWO-SIDED BEAM-BEAM CONN**
1" = 1'-0"
LP1Y-SF-0009P953

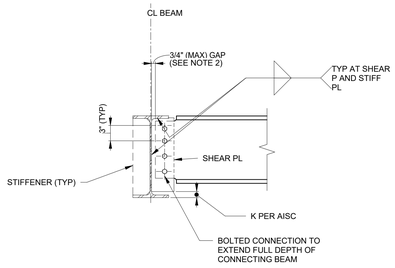


2 **ONE-SIDED BEAM-BEAM CONN**
1" = 1'-0"
LP1Y-SF-0009P953

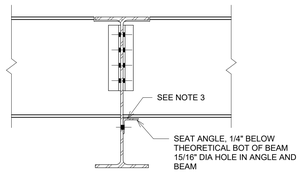


3 **BEAM TO BEAM CONNECTION**
1" = 1'-0"
LP1Y-SF-0009P953

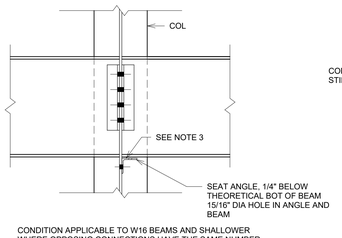


4 **BEAM TO COL. SHEAR CONNECTION**
1" = 1'-0"
LP1Y-SF-0009P953

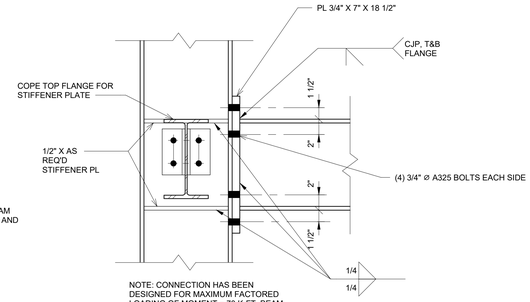


5 **MOMENT CONNECTION**
1 1/2" = 1'-0"
LP1Y-SF-0009P953

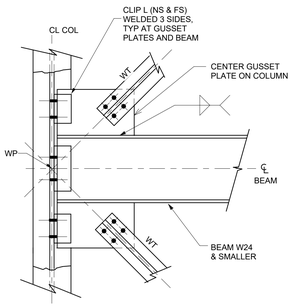


6 **VERTICAL X-BRACE TO COL. CONN.**
1" = 1'-0"
LP1Y-SF-0009P953

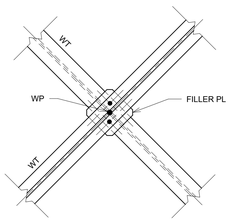


7 **HORIZ. X-BRACE CONN.**
1" = 1'-0"
LP1Y-SF-0009P953

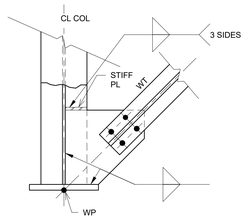

8 **VERTICAL X-BRACE TO COL. BASEPLATE CONN.**
1" = 1'-0"
LP1Y-SF-0009P953

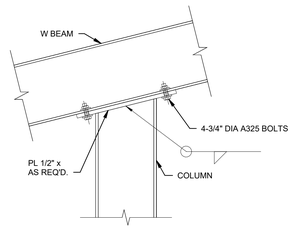

14 **CONNECTION, SLOPING BEAM TO COLUMN**
1" = 1'-0"
LP1Y-SF-0009P953

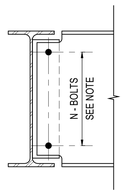


NOTE:
CONNECTIONS NOT DETAILED ON THE PLANS SHALL BE SELECTED IN ACCORDANCE WITH AISC SPECIFICATIONS, TYPE 2 FRAMING CONNECTIONS USING 3/4" DIA. ASTM A325 N-BOLTS (SNUG TIGHT). FOR CONNECTIONS WHERE REACTIONS ARE NOT PROVIDED ON THE FRAMING PLAN, FOR A GIVEN SIZE AND GRADE OF BEAMS, CONNECTIONS SHALL BE SELECTED BY THE FABRICATOR TO SUPPORT THE FOLLOWING BEAM REACTIONS:


- R = W/2 >10 KIP
- W = MAX. TOTAL UNIFORM LOAD (LRFD), KIPS FOR BEAM SPAN IN FEET PER AISC STEEL CONSTRUCTION MANUAL, FOURTEENTH EDITION, PART 3, MAXIMUM TOTAL UNIFORM LOAD TABLES (LRFD. IN NO CASE SHALL THE NUMBER OF BOLTS, N, BE LESS THAN THE FOLLOWING FOR THE INDICATED BEAM CLASS:

N=	2	3	4	5	6	8
	W8	W12	W16	W21	W27	W33
	W10	W14	W18	W24	W30	W36
	C9	C15				


13 **TYPICAL CONNECTION DETAIL**
1 1/2" = 1'-0"
LP1Y-SF-0009P953

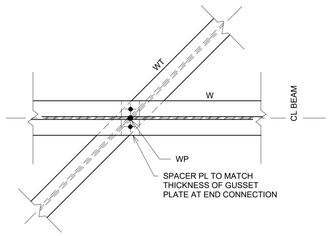


9 **HORIZONTAL BRACE DETAIL**
1" = 1'-0"
LP1Y-SF-0009P953

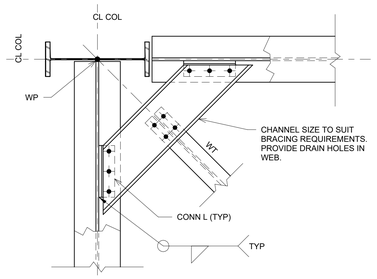


10 **HOR. BRACE CONN. AT COL.**
1" = 1'-0"
LP1Y-SF-0009P953

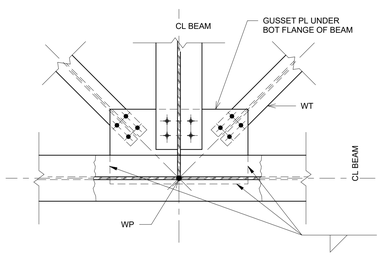


11 **HORIZONTAL BRACE CONN. AT BEAM TO GIRDER**
1" = 1'-0"
LP1Y-SF-0009P953

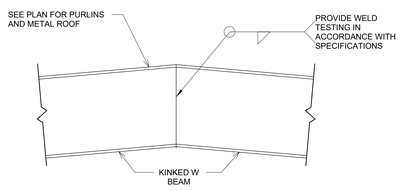

12 **KINKED BEAM CONNECTION**
1" = 1'-0"
LP1Y-SF-0009P953

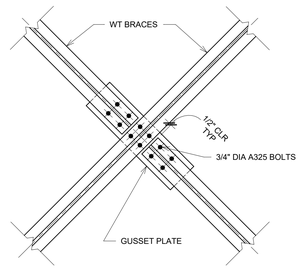

15 **VERTICAL X-BRACE CONN.**
1" = 1'-0"
LP1Y-SF-0009P953

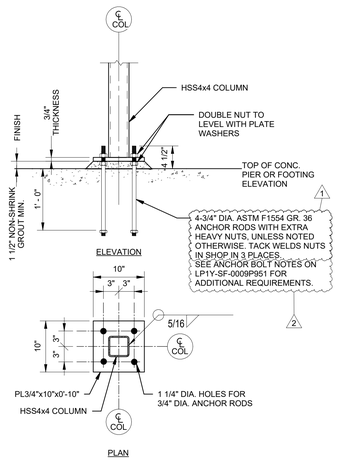

16 **BASE PLATE DETAIL**
1" = 1'-0"
LP1Y-SF-0009P953

A1- DATA COMPLETE - NO COMMENTS - DO NOT RESUBMIT
Authorization to proceed does not relieve Contractor/Supplier of its responsibility or liability under the Contract and or Purchase Order.
By dac54131 at Apr 15, 2026

RYNE M. FIORITO REGISTERED PE12100177 STATE OF INDIANA PROFESSIONAL ENGINEER

REV	ZONE	PROJECT NUMBER / DESCRIPTION	CHANGE CONTROL	DATE
2		ISSUED FOR CONSTRUCTION		10-APR-2026
1		ISSUED FOR CONSTRUCTION		03-APR-2026
0		ISSUED FOR CONSTRUCTION		20-FEB-2026
C		ISSUED FOR REVIEW		07-JAN-2026
B		ISSUED FOR REVIEW		14-NOV-2025

REVISIONS

CONFIDENTIAL INFORMATION
THIS DRAWING AND THE IDEAS AND DESIGNS SHOWN THEREON ARE THE EXCLUSIVE PROPERTY OF ELI LILLY AND COMPANY AND ARE NOT TO BE USED, REPRODUCED OR DISCLOSED, EITHER IN WHOLE OR IN PART, WITHOUT THE WRITTEN CONSENT OF ELI LILLY AND COMPANY.

HANSON™
HANSON PROFESSIONAL SERVICES, INC.
www.hanson-inc.com
Offices Nationwide
11931 Wickchester Lane, Suite 370
Houston, TX 77043
(346) 297-1720

REV	DATE	DES	ENG	CHK	APP	PM APP
2	10-APR-2026	RKN	SJS	FCB	RMF	SS
1	03-APR-2026	RKN	SJS	FCB	RMF	SS
0	20-FEB-2026	RKN	SJS	FCB	RMF	SS
C	07-JAN-2026	RKN	SJS	FCB	FCB	SS
B	14-NOV-2025	RKN	SJS	FCB	FCB	SS

Lilly


STRUCTURAL STEEL FRAMING AND BRACE DETAILS

RAIL UNLOADING RACK

SYSTEM TYPE: NA			EDIFICE/BUILDING: UNLOADING RACK	LEVEL/FLOOR: 0	
SUB DISCIPLINE: SF	LOCATION CODE: LP1	LOCATION/GRID: NA	CCI CODE: YELLOW	PROJECT NAME:	
CRITICAL QUALITY:		ENTERPRISE GROUP: API	DRAWING INTENTION:	DRAWING SCALE: NONE	
CRITICAL BUSINESS:		EQUIPMENT CLASSIFICATION: NA	ALTERNATE DOCUMENT ID: NA		MERIDIAN REV: 2
CRITICAL HSE:		VENDOR: NA	DOCUMENT ID: LP1Y-SF-0009P953		
NON-CRITICAL:		ENGINEERING AGENCY DOC ID: NA			

IF YOU ARE USING A PRINTED COPY OF THIS DOCUMENT, IT IS AN UNCONTROLLED PRINT. CONFIRM WITH THE OFFICIAL "ELECTRONIC RECORD" DOCUMENT IN THE GLOBAL ENGINEERING CONTENT MANAGEMENT SYSTEM.


IF YOU ARE USING A PRINTED COPY OF THIS DOCUMENT, IT IS AN UNCONTROLLED PRINT. CONFIRM WITH THE OFFICIAL "ELECTRONIC RECORD" DOCUMENT IN THE GLOBAL ENGINEERING CONTENT MANAGEMENT SYSTEM.

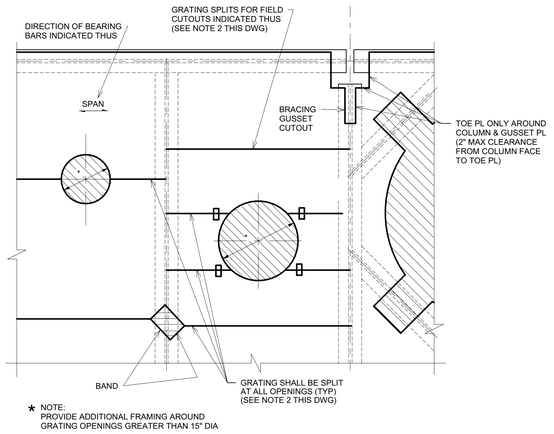

* NOTE:
PROVIDE ADDITIONAL FRAMING AROUND GRATING OPENINGS GREATER THAN 15" DIA

GRATING PLAN AT FLOOR OPENINGS

1 **DETAIL**
1" = 1'-0"
LP1Y-SF-0009P955

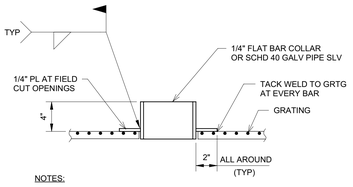


NOTES:

1. OPENINGS IN GRATING 8" DIA OR LESS SHALL BE LOCATED AND CUT BY FIELD UNLESS NOTED OTHERWISE.
2. SLEEVES ARE NOT REQD FOR OPENINGS LESS THAN 4" DIA. FIELD PROVIDE SLEEVES FOR OPENINGS 4" THROUGH 8" DIA.
3. PROVIDE 1/4"x4" FLAT BAR COLLAR AT OPENINGS GREATER THAN 8" DIAMETER.


SLEEVE OR COLLAR DETAIL AT FLOOR OPENINGS

2 **DETAIL**
1" = 1'-0"
LP1Y-SF-0009P955

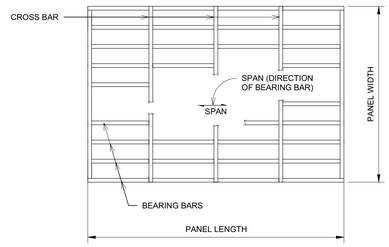

TYPICAL GRATING PANEL

3 **DETAIL**
1" = 1'-0"
LP1Y-SF-0009P955

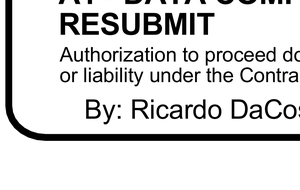

TYPICAL GRATING ATTACHMENT DETAILS

4 **DETAIL**
1" = 1'-0"
LP1Y-SF-0009P955

NOTES:

1. FOR GENERAL NOTES, DESIGN CRITERIA, AND STANDARDS, REFER TO DRAWING LP1Y-SF-0009P001.
2. FABRICATOR MAY VARY LOCATION OF SPLIT LINES A MAXIMUM OF 1/2" TO THE NEAREST REGULAR BEARING BAR.
3. X-FCM GRATING FASTENING SYSTEM BY HILTI, 5400 S. 122nd, E. AVE., TULSA, OK 74146. PHONE 1-866-445-8827, WEB SITE WWW.US.HILTI.COM.
4. SADDLE CLIP ANCHORS BY IKG-BORDEN, 1423 WADSWORTH; HOUSTON, TX 77015. PHONE 1-800-324-8417.
5. "GRATE-FAST" ANCHORS BY STRUCT-FAST, INC., 8648 COMMERCE DR, SUITE 1200, EASTON, MD 21601. PHONE (800) 327-6719.
6. A MINIMUM OF 1" BEARING SHALL BE PROVIDED.
7. EACH REMOVABLE FABRICATED GRATING PANEL SHALL NOT EXCEED 150 LBS, AND ALL EDGES SHALL BE BANDED.

No Lilly comments

REVIEWED
By:Homayoon S. CSA,saf16975,March 10, 2026

No comment

A1 - DATA COMPLETE - NO COMMENTS - DO NOT RESUBMIT

Authorization to proceed does not relieve Contractor/Supplier of its responsibility or liability under the Contract and or Purchase Order.

By: Ricardo DaCosta dac54131 March 11, 2026

RYNE M. FIORITO REGISTERED PE12100177 STATE OF INDIANA PROFESSIONAL ENGINEER

REV	ZONE	PROJECT NUMBER / DESCRIPTION	CHANGE CONTROL	DATE
0		ISSUED FOR CONSTRUCTION		20-FEB-2026
C		ISSUED FOR REVIEW		07-JAN-2026
B		ISSUED FOR REVIEW		14-NOV-2025
A		ISSUED FOR REVIEW		10-OCT-2025

REVISIONS

CONFIDENTIAL INFORMATION
THIS DRAWING AND THE IDEAS AND DESIGNS SHOWN THEREON ARE THE EXCLUSIVE PROPERTY OF ELI LILLY AND COMPANY AND ARE NOT TO BE USED, REPRODUCED OR DISCLOSED, EITHER IN WHOLE OR IN PART, WITHOUT THE WRITTEN CONSENT OF ELI LILLY AND COMPANY.

HANSON™
HANSON PROFESSIONAL SERVICES, INC.
www.hanson-inc.com
Offices Nationwide
11931 Wickchester Lane, Suite 370
Houston, TX 77043
(346) 297-1720

REV	DATE	DES	ENG	CHK	APP	PM APP
0	20-FEB-2026	RKN	SJS	FCB	RMF	SS
C	07-JAN-2026	RKN	SJS	FCB	FCB	SS
B	14-NOV-2025	RKN	SJS	FCB	FCB	SS
A	10-OCT-2025	RKN	SJS	FCB	RMF	SS

Lilly

STRUCTURAL GRATING DETAILS

RAIL UNLOADING RACK


SYSTEM TYPE: NA			EDIFICE/BUILDING: UNLOADING RACK	LEVEL/FLOOR: 0	
SUB DISCIPLINE: SF	LOCATION CODE: LP1	LOCATION/GRID: NA	CCI CODE: YELLOW	PROJECT NAME:	
CRITICAL QUALITY:		ENTERPRISE GROUP: API	DRAWING INTENTION:	DRAWING SCALE: NONE	
CRITICAL BUSINESS:		EQUIPMENT CLASSIFICATION: NA	ALTERNATE DOCUMENT ID: NA		MERIDIAN REV: 0
CRITICAL HSE:		VENDOR: NA	DOCUMENT ID: LP1Y-SF-0009P955		
NON-CRITICAL:		ENGINEERING AGENCY DOC ID: NA			

IF YOU ARE USING A PRINTED COPY OF THIS DOCUMENT, IT IS AN UNCONTROLLED PRINT. CONFIRM WITH THE OFFICIAL "ELECTRONIC RECORD" DOCUMENT IN THE GLOBAL ENGINEERING CONTENT MANAGEMENT SYSTEM.


IF YOU ARE USING A PRINTED COPY OF THIS DOCUMENT, IT IS AN UNCONTROLLED PRINT. CONFIRM WITH THE OFFICIAL "ELECTRONIC RECORD" DOCUMENT IN THE GLOBAL ENGINEERING CONTENT MANAGEMENT SYSTEM.

NOTES:

1. FOR GENERAL NOTES, DESIGN CRITERIA, AND STANDARDS, REFER TO DRAWING LP1Y-SF-0009P001.
2. ALL CORNERS TO BE MITERED AND ALL BURRS TO BE REMOVED.
3. FABRICATE AND SHIP STAIRS AND HANDRAILS IN SECTIONS AS LONG AS PRACTICAL.

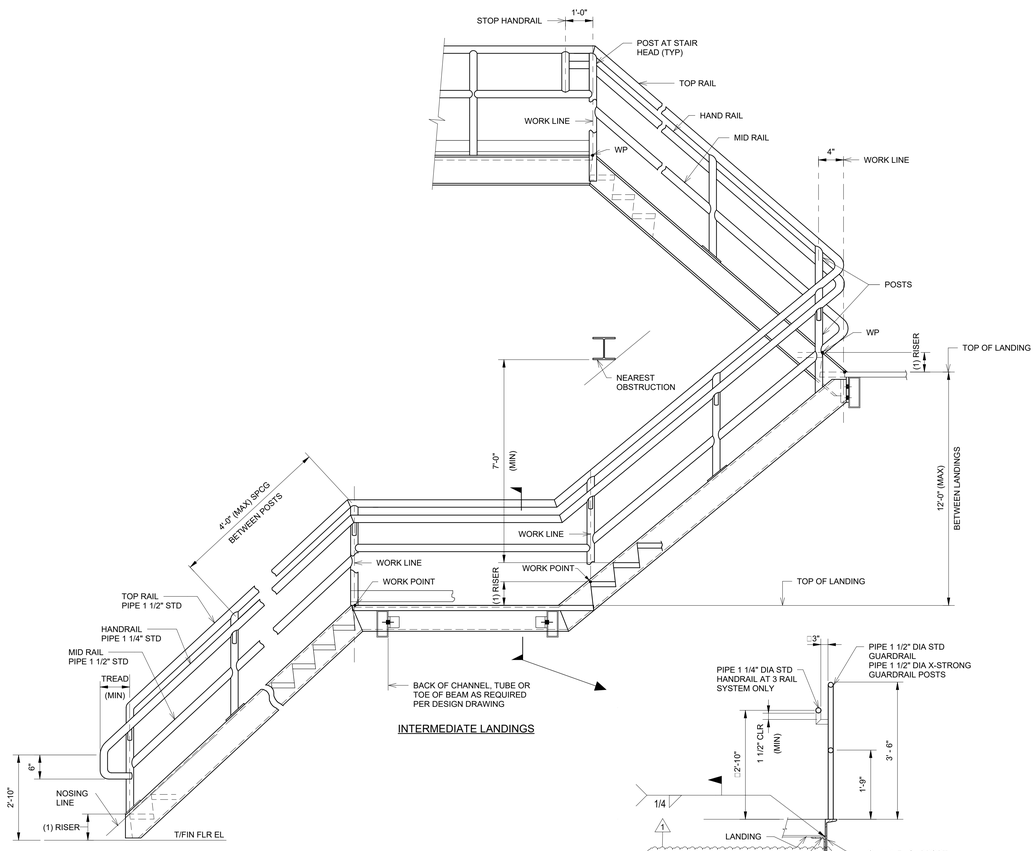


INTERMEDIATE LANDINGS

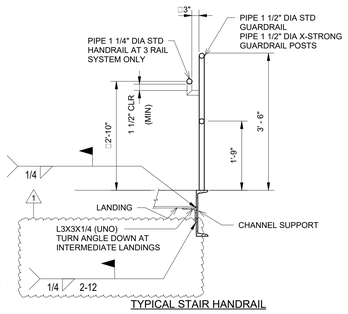

TYPICAL STAIR HANDRAIL


1 3 RAIL (2 GUARDRAIL & 1 HANDRAIL) SYSTEM

N.T.S.
LP1Y-SF-0009P956

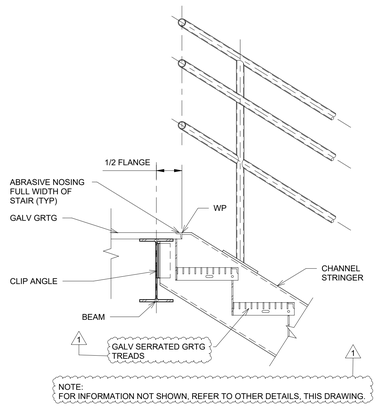


2 DETAIL

1" = 1'-0"
LP1Y-SF-0009P956

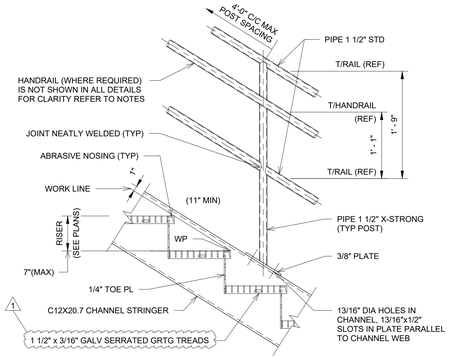


3 STAIR DETAIL

1" = 1'-0"
LP1Y-SF-0009P956

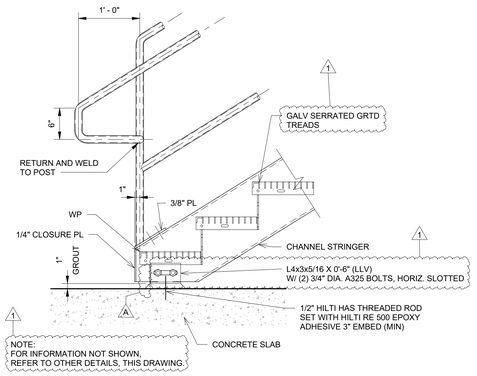


6 DETAIL

1" = 1'-0"
LP1Y-SF-0009P956

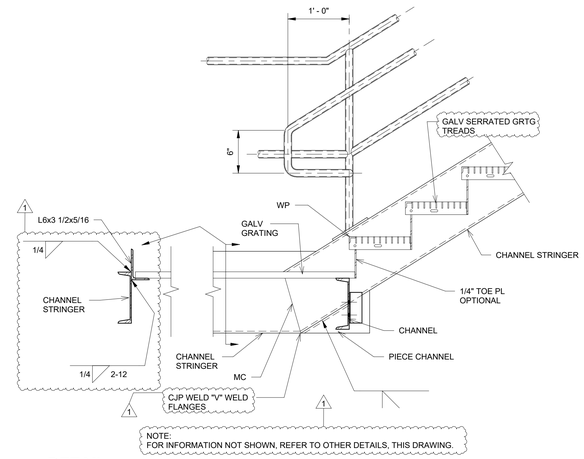


5 DETAIL

1" = 1'-0"
LP1Y-SF-0009P956

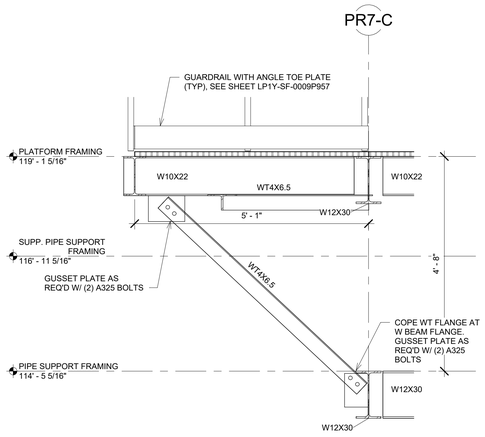


4 SECTION AT UPPER STAIR LANDING KICKERS

3/4" = 1'-0"
LP1Y-SF-0009P956

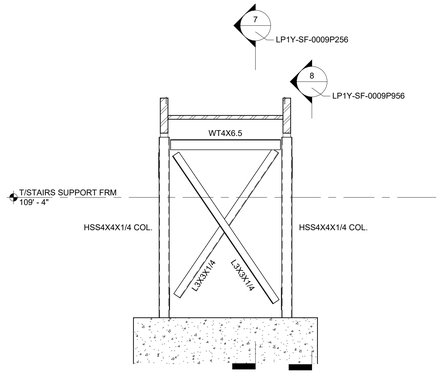

7 SECTION AT NORTH STAIR LANDING

1/2" = 1'-0"
LP1Y-SF-0009P956

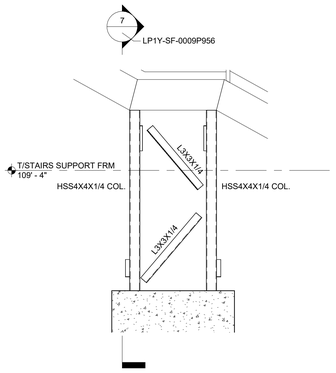

8 SECTION AT NORTH STAIR LANDING

1/2" = 1'-0"
LP1Y-SF-0009P956

NOTE:
SLAB-ON-GRADE AND SECONDARY CONTAINMENT SYSTEM NOT SHOWN

A1- DATA COMPLETE - NO COMMENTS - DO NOT RESUBMIT

Authorization to proceed does not relieve Contractor/Supplier of its responsibility or liability under the Contract and or Purchase Order.

By dac54131 at Apr 10, 2026

RYNE M. FIORITO REGISTERED PE12100177 STATE OF INDIANA PROFESSIONAL ENGINEER

HANSON™
HANSON PROFESSIONAL SERVICES, INC.
www.hanson-inc.com
Offices Nationwide
11931 Wickchester Lane, Suite 370
Houston, TX 77043
(346) 297-1720

REV	DATE	DES	ENG	CHK	APP	PM APP
3	03-APR-2026	RKN	SJS	FCB	RMF	SS
2	20-FEB-2026	RKN	SJS	FCB	RMF	SS
1	14-NOV-2025	RKN	SJS	FCB	FCB	SS
0	10-OCT-2025	RKN	SJS	FCB	RMF	SS

Lilly

STRUCTURAL STAIR AND HANDRAIL DETAILS

RAIL UNLOADING RACK

REV	ZONE	PROJECT NUMBER / DESCRIPTION	CHANGE CONTROL	DATE
1		ISSUED FOR CONSTRUCTION		03-APR-2026
0		ISSUED FOR CONSTRUCTION		20-FEB-2026
B		ISSUED FOR REVIEW		14-NOV-2025
A		ISSUED FOR REVIEW		10-OCT-2025

REVISIONS

CONFIDENTIAL INFORMATION

THIS DRAWING AND THE IDEAS AND DESIGNS SHOWN THEREON ARE THE EXCLUSIVE PROPERTY OF ELI LILLY AND COMPANY AND ARE NOT TO BE USED, REPRODUCED OR DISCLOSED, EITHER IN WHOLE OR IN PART, WITHOUT THE WRITTEN CONSENT OF ELI LILLY AND COMPANY.


SYSTEM TYPE: NA		EDIFICE/BUILDING: UNLOADING RACK	LEVEL/FLOOR: 0
SUB DISCIPLINE: SF	LOCATION CODE: LP1	LOCATION/GRID: NA	CCI CODE: YELLOW / PROJECT NAME:
CRITICAL QUALITY:		ENTERPRISE GROUP: API	DRAWING INTENTION / DRAWING SCALE: NONE
CRITICAL BUSINESS:		EQUIPMENT CLASSIFICATION: NA	ALTERNATE DOCUMENT ID: NA / MERIDIAN REV: 1
CRITICAL HSE:		VENDOR: NA	DOCUMENT ID: LP1Y-SF-0009P956
NON-CRITICAL:		ENGINEERING AGENCY DOC ID: NA	

IF YOU ARE USING A PRINTED COPY OF THIS DOCUMENT, IT IS AN UNCONTROLLED PRINT. CONFIRM WITH THE OFFICIAL "ELECTRONIC RECORD" DOCUMENT IN THE GLOBAL ENGINEERING CONTENT MANAGEMENT SYSTEM.


IF YOU ARE USING A PRINTED COPY OF THIS DOCUMENT, IT IS AN UNCONTROLLED PRINT. CONFIRM WITH THE OFFICIAL "ELECTRONIC RECORD" DOCUMENT IN THE GLOBAL ENGINEERING CONTENT MANAGEMENT SYSTEM.

NOTES:

1. FOR GENERAL NOTES, DESIGN CRITERIA, AND STANDARDS, REFER TO DRAWING LP1Y-SF-0009P001.

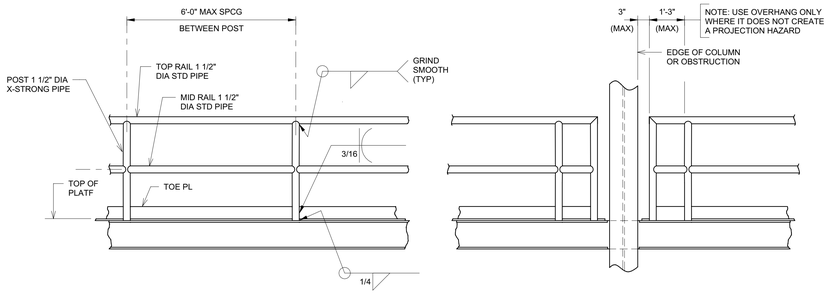


1 **GUARDRAIL ELEVATION**
1" = 1'-0"
LP1Y-SF-0009P957

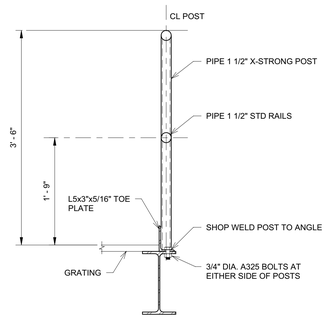

NOTE: DETAIL IS ADEQUATE FOR OSHA LIVE LOADS ON GUARDRAIL.

2 **TYP GUARDRAIL CONN**
1" = 1'-0"
LP1Y-SF-0009P957

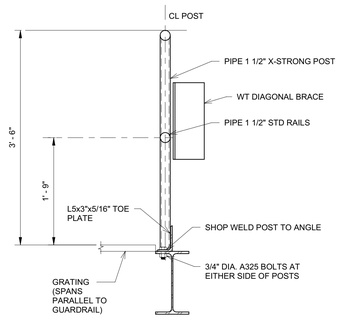

NOTE: DETAIL IS ADEQUATE FOR OSHA LIVE LOADS ON GUARDRAIL.

3 **GUARDRAIL CONN. AT X-BRACING**
1" = 1'-0"
LP1Y-SF-0009P957

No Lilly comment

REVIEWED
By:Homayoon S. CSA,saf16975,March 10, 2026

No comment

A1 - DATA COMPLETE - NO COMMENTS - DO NOT RESUBMIT
Authorization to proceed does not relieve Contractor/Supplier of its responsibility or liability under the Contract and or Purchase Order.
By: Ricardo DaCosta dac54131 March 11, 2026

RYNE M. FIORITO
REGISTERED
PE12100177
STATE OF
INDIANA
PROFESSIONAL ENGINEER

REV	ZONE	PROJECT NUMBER / DESCRIPTION	CHANGE CONTROL	DATE
0		ISSUED FOR CONSTRUCTION		20-FEB-2026
C		ISSUED FOR REVIEW		07-JAN-2026
B		ISSUED FOR REVIEW		14-NOV-2025
A		ISSUED FOR REVIEW		10-OCT-2025

REVISIONS

CONFIDENTIAL INFORMATION

THIS DRAWING AND THE IDEAS AND DESIGNS SHOWN THEREON ARE THE EXCLUSIVE PROPERTY OF ELI LILLY AND COMPANY AND ARE NOT TO BE USED, REPRODUCED OR DISCLOSED, EITHER IN WHOLE OR IN PART, WITHOUT THE WRITTEN CONSENT OF ELI LILLY AND COMPANY.

HANSON PROFESSIONAL SERVICES, INC.
www.hanson-inc.com
Offices Nationwide
11931 Wickchester Lane, Suite 370
Houston, TX 77043
(346) 297-1720

REV	DATE	DES	ENG	CHK	APP	PM APP
0	20-FEB-2026	RKN	SJS	FCB	RMF	SS
C	07-JAN-2026	RKN	SJS	FCB	FCB	SS
B	14-NOV-2025	RKN	SJS	FCB	FCB	SS
A	10-OCT-2025	RKN	SJS	FCB	RMF	SS

Lilly


STRUCTURAL GUARDRAIL DETAILS

RAIL UNLOADING RACK


SYSTEM TYPE: NA				EDIFICE/BUILDING: UNLOADING RACK	LEVEL/FLOOR: 0
SUB DISCIPLINE: SF	LOCATION CODE: LP1	LOCATION/GRID: NA		CCI CODE: YELLOW	PROJECT NAME:
CRITICAL QUALITY		ENTERPRISE GROUP: API		DRAWING INTENTION	DRAWING SCALE: NONE
CRITICAL BUSINESS		EQUIPMENT CLASSIFICATION: NA		ALTERNATE DOCUMENT ID: NA	MERIDIAN REV: 0
CRITICAL HSE		VENDOR: NA		DOCUMENT ID: LP1Y-SF-0009P957	
NON-CRITICAL		ENGINEERING AGENCY DOC ID: NA			

IF YOU ARE USING A PRINTED COPY OF THIS DOCUMENT, IT IS AN UNCONTROLLED PRINT. CONFIRM WITH THE OFFICIAL "ELECTRONIC RECORD" DOCUMENT IN THE GLOBAL ENGINEERING CONTENT MANAGEMENT SYSTEM.

IF YOU ARE USING A PRINTED COPY OF THIS DOCUMENT, IT IS AN UNCONTROLLED PRINT. CONFIRM WITH THE OFFICIAL "ELECTRONIC RECORD" DOCUMENT IN THE GLOBAL ENGINEERING CONTENT MANAGEMENT SYSTEM.

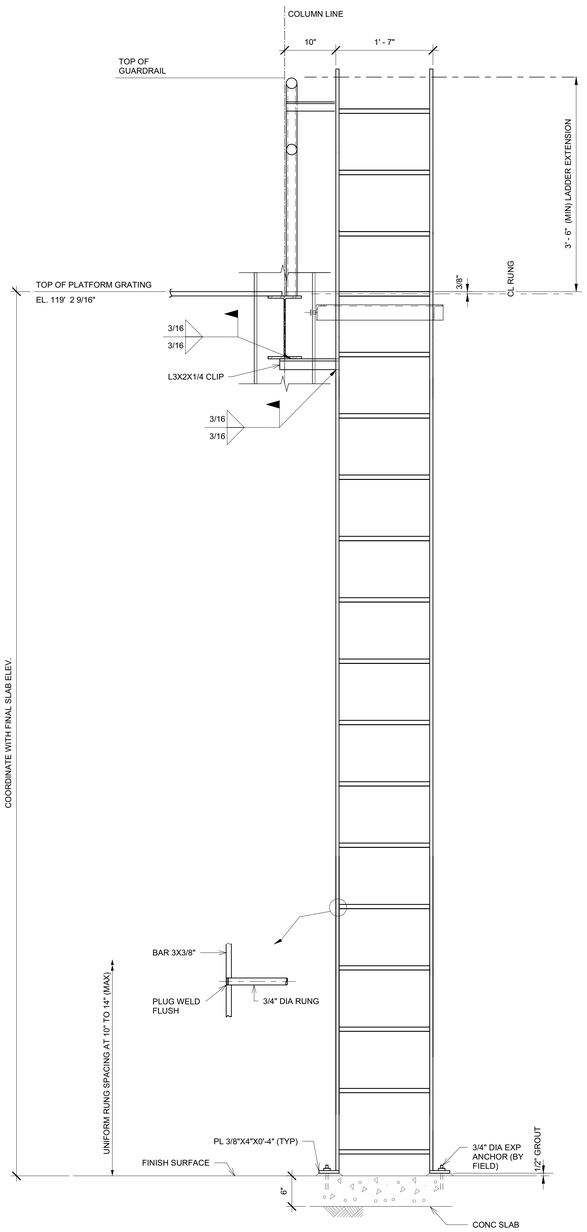

1 **LADDER ELEVATION**
1" = 1'-0"
LP1Y-SF-0009P958

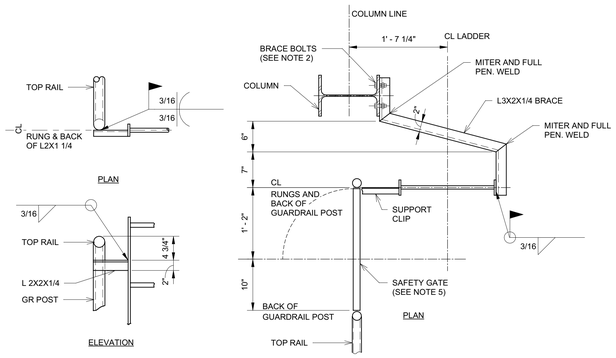

2 **LADDER SUPPORT DETAILS**
1" = 1'-0"
LP1Y-SF-0009P958

NOTES:

1. FOR GENERAL NOTES, DESIGN CRITERIA, AND STANDARDS, REFER TO DRAWING LP1Y-SF-0009P001.
2. BOLTS SHALL BE 5/8" DIA COMMON (MACHINE) BOLTS UNLESS NOTED OTHERWISE.
3. LADDERS TO BE SHIPPED ASSEMBLED.
4. ALL SHARP CORNERS AND BURRS SHALL BE REMOVED BEFORE GALVANIZING OR SHOP PRIMING.
5. A SAFETY GATE SHALL BE PROVIDED AT ALL LADDER ACCESS TO PLATFORMS UNLESS NOTED OTHERWISE ON DESIGN DRAWINGS. SAFETY GATE SHALL BE FABENCO MODEL Z70-24 TO X70-33 (DEPENDENT ON WIDTH OF OPENING) OR APPROVED SUBSTITUTE.
6. THESE DETAILS, AS SHOWN, COMPLY WITH OSHA (OCCUPATIONAL SAFETY AND HEALTH ADMINISTRATION) REGULATION 29CFRXVII, SECTION 1910.27.

No Lilly comment

A1 - DATA COMPLETE - NO COMMENTS - DO NOT RESUBMIT
Authorization to proceed does not relieve Contractor/Supplier of its responsibility or liability under the Contract and or Purchase Order.
By: Ricardo DaCosta dac54131 March 11, 2026

REVIEWED
By:Homayoon S. CSA,sa#16975,March 10, 2026
No comment

RYNE M. FIORITO REGISTERED PE12100177 STATE OF INDIANA PROFESSIONAL ENGINEER

REV	ZONE	PROJECT NUMBER / DESCRIPTION	CHANGE CONTROL	DATE
0		ISSUED FOR CONSTRUCTION		20-FEB-2026
C		ISSUED FOR REVIEW		07-JAN-2026
B		ISSUED FOR REVIEW		14-NOV-2025
A		ISSUED FOR REVIEW		10-OCT-2025

REVISIONS

CONFIDENTIAL INFORMATION
THIS DRAWING AND THE IDEAS AND DESIGNS SHOWN THEREON ARE THE EXCLUSIVE PROPERTY OF ELI LILLY AND COMPANY AND ARE NOT TO BE USED, REPRODUCED OR DISCLOSED, EITHER IN WHOLE OR IN PART, WITHOUT THE WRITTEN CONSENT OF ELI LILLY AND COMPANY.

HANSON™
HANSON PROFESSIONAL SERVICES, INC.
www.hanson-inc.com
Offices Nationwide
11931 Wickchester Lane, Suite 370
Houston, TX 77043
(346) 297-1720

REV	DATE	DES	ENG	CHK	APP	PM APP
0	20-FEB-2026	RKN	SJS	FCB	RMF	SS
C	07-JAN-2026	RKN	SJS	FCB	FCB	SS
B	14-NOV-2025	RKN	SJS	FCB	FCB	SS
A	10-OCT-2025	RKN	SJS	FCB	RMF	SS

Lilly

STRUCTURAL LADDER DETAILS

RAIL UNLOADING RACK

SYSTEM TYPE: NA			EDIFICE/BUILDING: UNLOADING RACK	LEVEL/FLOOR: 0	
SUB DISCIPLINE: SF	LOCATION CODE: LP1	LOCATION/GRID: NA	CCI CODE: YELLOW	PROJECT NAME	
CRITICAL QUALITY		ENTERPRISE GROUP: API	DRAWING INTENTION	DRAWING SCALE: NONE	
CRITICAL BUSINESS		EQUIPMENT CLASSIFICATION: NA	ALTERNATE DOCUMENT ID: NA		MERIDIAN REV: 0
CRITICAL HSE		VENDOR: NA	DOCUMENT ID: LP1Y-SF-0009P958		
NON-CRITICAL		ENGINEERING AGENCY DOC ID: NA			

IF YOU ARE USING A PRINTED COPY OF THIS DOCUMENT, IT IS AN UNCONTROLLED PRINT. CONFIRM WITH THE OFFICIAL "ELECTRONIC RECORD" DOCUMENT IN THE GLOBAL ENGINEERING CONTENT MANAGEMENT SYSTEM.

IF YOU ARE USING A PRINTED COPY OF THIS DOCUMENT, IT IS AN UNCONTROLLED PRINT. CONFIRM WITH THE OFFICIAL "ELECTRONIC RECORD" DOCUMENT IN THE GLOBAL ENGINEERING CONTENT MANAGEMENT SYSTEM.

Branch Panel: 48-LP/00-00-01

Location: TFS E-House 48-EB/00-00-01 Electrical Room
Supply From: 48-MCC/00-00-01 (VIA 48-TX/00-00-02)
Mounting: Surface
Enclosure: NEMA 1 Indoor

Volts: 208/120 Wye
Phases: 3
Wires: 4

A.I.C. Rating: 10kA
Mains Type: MCB
Mains Rating: 150 A
MCB Rating: 150 A

Notes:

CKT	LOCATION	LOAD SERVED	CB AMP	CB POLE	CB OPT	A (kVA)		B (kVA)		C (kVA)		CB OPT	CB POLE	CB AMP	LOAD SERVED	LOCATION	CKT
1	E-HOUSE BLDG 48 DELTA V ROOM	LIGHTING - DELTA V ROOM	20	1		0.15	0.22						1	20	LIGHTING - IT IDF ROOM	E-HOUSE BLDG 48 IT IDF ROOM	2
3	SEE NOTE 2	LIGHTING - ELECTRICAL ROOM	20	1				0.65	0.58				1	20	LIGHTING - E-HOUSE EXTERIOR LIGHTING	E-HOUSE BLDG 48	4
5	--	SPARE	20	1	--					0.00	0.00	--	1	20	SPARE	--	6
7	--	SPARE	20	1	--	0.00	0.00					--	1	20	SPARE	--	8
9	--	SPARE	20	1	--			0.00	0.00			--	1	20	SPARE	--	10
11	--	SPARE	20	1	--					0.00	0.00	--	1	20	SPARE	--	12
13	--	SPARE	20	1	--	0.00	0.00					--	1	20	SPARE	--	14
15	--	SPARE	20	1	--			0.00	0.00			--	1	20	SPARE	--	16
17	--	SPARE	20	1	--					0.00	0.00	--	1	20	SPARE	--	18
19	--	SPARE	20	1	--	0.00	0.00					--	1	20	SPARE	--	20
21	--	SPARE	20	1	--			0.00	0.00			--	1	20	SPARE	--	22
23	--	SPARE	20	1	--					0.00	0.00	--	1	20	SPARE	--	24
25	--	SPARE	20	1	--	0.00	0.00					--	1	20	SPARE	--	26
27	--	SPARE	20	1	--			0.00	0.00			--	1	20	SPARE	--	28
29	--	SPARE	20	1	--					0.00	0.00	--	1	20	SPARE	--	30
31	--	SPARE	20	1	--	0.00	0.00					--	1	20	SPARE	--	32
33	--	SPARE	20	1	--			0.00	0.00			--	1	20	SPARE	--	34
35	--	SPARE	20	1	--					0.00	0.00	--	1	20	SPARE	--	36
37	--	SPARE	20	1	--	0.00	0.00					--	1	20	SPARE	--	38
39	--	SPARE	20	1	--			0.00	0.00			--	1	20	SPARE	--	40
41	--	SPARE	20	1	--					0.00	0.00	--	1	20	SPARE	--	42
					Total Load:	0.37 kVA		1.23 kVA		0.00 kVA							
					Total Amps:	4 A		11 A		0 A							

LEGEND:

LOAD CLASSIFICATION	CONNECTED LOAD (kVA)	DEMAND FACTOR	DEMAND LOAD (kVA)	PANEL TOTALS	
RECEPTACLE		100% 1ST 10 kVA (PER NEC ARTICLE 210), 50% > 10 kVA			
LIGHTING / CONTINUOUS	1.59	125%	1.99	**TOTAL CONN. LOAD:**	1.59 kVA
KITCHEN		100% PER NEC ARTICLE 220.56		**TOTAL EST. DEMAND:**	1.99 kVA
MOTOR		100% PER NEC ARTICLE 430.24		**TOTAL CONN.:**	4 A
LARGEST MOTOR		125%		**TOTAL EST. DEMAND:**	6 A
EQUIPMENT / MISC		100%			
SUBFEED LOAD(S)		100%			

Notes:
1. REFER TO B1LG-6-0020-00-00066 FOR EQUIPMENT LAYOUT AND MOUNTING ARRANGEMENT.
2. LOCATION OF CKT 3: E-HOUSE BLDG. 48 ELECTRICAL ROOM.

Branch Panel: 48-RP/00-00-01

Location: TFS E-House 48-EB/00-00-01 Electrical Room
Supply From: 48-MCC/00-00-01 (VIA 48-TX/00-00-01)
Mounting: Surface
Enclosure: NEMA 1 Indoor

Volts: 208/120 Wye
Phases: 3
Wires: 4

A.I.C. Rating: 10kA
Mains Type: MCB
Mains Rating: 150 A
MCB Rating: 150 A

Notes:

CKT	LOCATION	LOAD SERVED	CB AMP	CB POLE	CB OPT	A (kVA)		B (kVA)		C (kVA)		CB OPT	CB POLE	CB AMP	LOAD SERVED	LOCATION	CKT
1						0.00	0.00										2
3	E-HOUSE BLDG 48 DELTA V ROOM	48-RP/00-00-02	60	3				1.50	0.00				3	60	48-RP/00-00-03	E-HOUSE BLDG 48 IT IDF ROOM	4
5										1.30	0.00						6
7	SEE NOTE 2	ELECTRICAL ROOM RECEPTACLES	20	1		1.62	0.44						1	20	48-CTL-10-0001-001 - HVAC...	SEE NOTE 2	8
9	E-HOUSE BLDG. 48 IT IDF ROOM	IT IDF ROOM RECEPTACLES	20	1				0.54	1.38				1	20	48-H-10020 - DELTA V ROOM...	E-HOUSE BLDG 48 DELTA V ROOM	10
11	E-HOUSE BLDG 48 DELTA V ROOM	DELTA V ROOM RECEPTACLES	20	1						0.54	1.38		1	20	48-H-10030 - IT IDF ROOM HUMIDIFIER	E-HOUSE BLDG. 48 IT IDF ROOM	12
13	--	SPARE	20	1	--	0.00	0.00					--	1	20	SPARE	--	14
15	RAIL CAR LOADING	LP1Y P-0631A (SEE NOTE 3)	20	1				0.14	0.00			--	1	20	SPARE	--	16
17	--	SPARE	20	1	--					0.00	0.00	--	1	20	SPARE	--	18
19	--	SPARE	20	1	--	0.00	0.00					--	1	20	SPARE	--	20
21	--	SPARE	20	1	--			0.00	0.00			--	1	20	SPARE	--	22
23	--	SPARE	20	1	--					0.00	0.00	--	1	20	SPARE	--	24
25	--	SPARE	20	1	--	0.00	0.00					--	1	20	SPARE	--	26
27	--	SPARE	20	1	--			0.00	0.00			--	1	20	SPARE	--	28
29	--	SPARE	20	1	--					0.00	0.00	--	1	20	SPARE	--	30
31	--	SPARE	20	1	--	0.00	0.00					--	1	20	SPARE	--	32
33	--	SPARE	20	1	--			0.00	0.00			--	1	20	SPARE	--	34
35	UNLOADING RACK (K215)	LP1-GMD/00-0621A (SEE NOTE 4)	20	1	--					0.50	0.72	--	1	20	RECEPTACLES - PLATFORM LEVEL	UNLOADING RACK (K215)	36
37	UNLOADING RACK (K215)	LP1-GMD/00-0631A (SEE NOTE 4)	20	1	--	0.50	0.72					--	1	20	RECEPTACLES - GROUND LEVEL	UNLOADING RACK (K215)	38
39	UNLOADING RACK (K215)	LP1-GMD/00-0640A (SEE NOTE 4)	20	1	--			0.50	0.15			--	1	20	Y-SSEW-15-0621-02 (SSEW)	UNLOADING RACK (K215)	40
41	UNLOADING RACK (K215)	LP1-GMD/00-0651A (SEE NOTE 4)	20	1	--					0.50	0.15	--	1	20	Y-SSEW-15-0621-01 (SSEW)	UNLOADING RACK (K215)	42
					Total Load:	3.26 kVA		4.21 kVA		5.09 kVA							
					Total Amps:	27 A		36 A		44 A							

[DESIGN HOLD] 0B

LEGEND:

LOAD CLASSIFICATION	CONNECTED LOAD (kVA)	DEMAND FACTOR	DEMAND LOAD (kVA)	PANEL TOTALS	
RECEPTACLE	2.70	100% 1ST 10 kVA (PER NEC ARTICLE 210), 50% > 10 kVA	2.70		
LIGHTING / CONTINUOUS		125%		**TOTAL CONN. LOAD:**	12.58 kVA
KITCHEN		100% PER NEC ARTICLE 220.56		**TOTAL EST. DEMAND:**	12.58 kVA
MOTOR		100% PER NEC ARTICLE 430.24		**TOTAL CONN.:**	35 A
LARGEST MOTOR		125%		**TOTAL EST. DEMAND:**	35 A
EQUIPMENT / MISC	4.14	100%	4.14		
SUBFEED LOAD(S)		100%			

Notes:
1. REFER TO B1LG-6-0020-00-00066 FOR EQUIPMENT LAYOUT AND MOUNTING ARRANGEMENT.
2. LOCATION OF CKT 7 & 8: E-HOUSE BLDG. 48 ELECTRICAL ROOM.
3. CKT 15: MOTOR HEATER SUPPLY (48-MCC/00-00-01, 5E)
4. CKT 35,37,39,41 : GROUNDING MONITORING SYSTEM LOADING ARM. [DESIGN HOLD]

0B

Branch Panel: 48-RP/00-00-03

Location: TFS E-House 48-EB/00-00-01 IT IDF Room
Supply From: 48-RP/00-00-01
Mounting: Surface
Enclosure: NEMA 1 Indoor

Volts: 208/120 Wye
Phases: 3
Wires: 4

A.I.C. Rating: 10kA
Mains Type: MCB
Mains Rating: 60 A
MCB Rating: 60 A

Notes:

CKT	LOCATION	LOAD SERVED	CB AMP	CB POLE	CB OPT	A (kVA)		B (kVA)		C (kVA)		CB OPT	CB POLE	CB AMP	LOAD SERVED	LOCATION	CKT
1	--	SPARE	20	2	--	0.00	0.00					--	2	20	SPARE	--	2
3								0.00	0.00								4
5	--	SPARE	20	2	--					0.00	0.00	--	1	20	SPARE	--	6
7						0.00	0.00					--	1	20	SPARE	--	8
9	--	SPARE	20	1	--			0.00	0.00			--	1	20	SPARE	--	10
11	--	SPARE	20	1	--					0.00	0.00	--	1	20	SPARE	--	12
13	--	SPARE	20	1	--	0.00	0.00					--	1	20	SPARE	--	14
15	--	SPARE	20	1	--			0.00	0.00			--	1	20	SPARE	--	16
17	--	SPARE	20	1	--					0.00	0.00	--	1	20	SPARE	--	18
19	--	SPARE	20	1	--	0.00	0.00					--	1	20	SPARE	--	20
21	--	SPARE	20	1	--			0.00	0.00			--	1	20	SPARE	--	22
23	--	SPARE	20	1	--					0.00	0.00	--	1	20	SPARE	--	24
25	--	SPARE	20	1	--	0.00	0.00					--	1	20	SPARE	--	26
27	--	SPARE	20	1	--			0.00	0.00			--	1	20	SPARE	--	28
29	--	SPARE	20	1	--					0.00	0.00	--	1	20	SPARE	--	30
					Total Load:	0.00 kVA		0.00 kVA		0.00 kVA							
					Total Amps:	0 A		0 A		0 A							

LEGEND:

LOAD CLASSIFICATION	CONNECTED LOAD (kVA)	DEMAND FACTOR	DEMAND LOAD (kVA)	PANEL TOTALS	
RECEPTACLE		100% 1ST 10 kVA (PER NEC ARTICLE 210), 50% > 10 kVA			
LIGHTING / CONTINUOUS		125%		**TOTAL CONN. LOAD:**	0.00 kVA
KITCHEN		100% PER NEC ARTICLE 220.56		**TOTAL EST. DEMAND:**	0.00 kVA
MOTOR		100% PER NEC ARTICLE 430.24		**TOTAL CONN.:**	0 A
LARGEST MOTOR		125%		**TOTAL EST. DEMAND:**	0 A
EQUIPMENT / MISC		100%			
SUBFEED LOAD(S)		100%			

Notes:

Branch Panel: 48-LP/00-00-02

Location: TFS E-House 48-EB/00-00-01 Electrical Room
Supply From: 48-MCC/00-00-01 (VIA 48-TX/00-00-03)
Mounting: Surface
Enclosure: NEMA 1 Indoor

Volts: 480/277 Wye
Phases: 3
Wires: 4

A.I.C. Rating: 14kA
Mains Type: MCB
Mains Rating: 100 A
MCB Rating: 100 A

Notes:

CKT	LOCATION	LOAD SERVED	CB AMP	CB POLE	CB OPT	A (kVA)		B (kVA)		C (kVA)		CB OPT	CB POLE	CB AMP	LOAD SERVED	LOCATION	CKT
1	UNLOADING RACK (K215)	LIGHTING - UNLOADING RACK	20	1	--	0.82	0.00					--	1	20	SPARE		2
3		SPARE	20	1	--			0.00	0.00			--	1	20	SPARE		4
5		SPARE	20	1	--					0.00	0.00	--	1	20	SPARE		6
7		SPARE	20	1	--	0.00	0.00					--	1	20	SPARE		8
9		SPARE	20	1	--			0.00	0.00			--	1	20	SPARE		10
11		SPARE	20	1	--					0.00	0.00	--	1	20	SPARE		12
13		SPARE	20	1	--	0.00	0.00					--	1	20	SPARE		14
15		SPARE	20	1	--			0.00	0.00			--	1	20	SPARE		16
17		SPARE	20	1	--					0.00	0.00	--	1	20	SPARE		18
19		SPARE	20	1	--	0.00	0.00					--	1	20	SPARE		20
21		SPARE	20	1	--			0.00	0.00			--	1	20	SPARE		22
23		SPARE	20	1	--					0.00	0.00	--	1	20	SPARE		24
25		SPARE	20	1	--	0.00	0.00					--	1	20	SPARE		26
27	UNLOADING RACK (K215)	Y-IPP-00-0048-001 IPP (NORMAL)	20	1	--			0.50	0.50			--	1	20	Y-IO-00-0048-001 CHARM I/O (NORMAL)	UNLOADING RACK (K215)	28
29	UNLOADING RACK (K215)	Y-IPP-00-0048-001 IPP (UTILITY)	20	1	--					0.50	0.50	--	1	20	Y-IO-00-0048-001 CHARM I/O (UTILITY)	UNLOADING RACK (K215)	30
					Total Load:	0.82 kVA		0.00 kVA		0.00 kVA							
					Total Amps:	3 A		0 A		0 A							

0B

LEGEND:

LOAD CLASSIFICATION	CONNECTED LOAD (kVA)	DEMAND FACTOR	DEMAND LOAD (kVA)	PANEL TOTALS	
RECEPTACLE		100% 1ST 10 kVA (PER NEC ARTICLE 210), 50% > 10 kVA			
LIGHTING / CONTINUOUS		125%		**TOTAL CONN. LOAD:**	0.82 kVA
KITCHEN		100% PER NEC ARTICLE 220.56		**TOTAL EST. DEMAND:**	0.82 kVA
MOTOR		100% PER NEC ARTICLE 430.24		**TOTAL CONN.:**	1 A
LARGEST MOTOR		125%		**TOTAL EST. DEMAND:**	1 A
EQUIPMENT / MISC		100%			
SUBFEED LOAD(S)		100%			

Notes:

Branch Panel: 48-RP/00-00-02

Location: TFS E-House 48-EB/00-00-01 Delta V Room
Supply From: 48-RP/00-00-01
Mounting: Surface
Enclosure: NEMA 1 Indoor

Volts: 208/120 Wye
Phases: 3
Wires: 4

A.I.C. Rating: 10kA
Mains Type: MCB
Mains Rating: 60 A
MCB Rating: 60 A

Notes:

CKT	LOCATION	LOAD SERVED	CB AMP	CB POLE	CB OPT	A (kVA)		B (kVA)		C (kVA)		CB OPT	CB POLE	CB AMP	LOAD SERVED	LOCATION	CKT
1						0.00	0.00										2
3	--	SPARE	20	2	--			0.00	0.00			--	2	20	SPARE	--	4
5										0.00	0.00						6
7	--	SPARE	20	2	--	0.00	0.00					--	2	20	SPARE	--	8
9	TFS (NEAR OPS SHELTER)	Y-IO-00-0048-002 (NORMAL)	20	1				0.50	0.00			--	1	20	SPARE	--	10
11	TFS (NEAR OPS SHELTER)	Y-IO-00-0048-002 (UTILITY)	20	1						0.30	0.00	--	1	20	SPARE	--	12
13	--	SPARE	20	1	--	0.00	0.00					--	1	20	SPARE	--	14
15	--	SPARE	20	1	--			0.00	0.00			--	1	20	SPARE	--	16
17	--	SPARE	20	1	--					0.00	0.00	--	1	20	SPARE	--	18
19	--	SPARE	20	1	--	0.00	0.00					--	1	20	SPARE	--	20
21	--	SPARE	20	1	--			0.00	0.00			--	1	20	SPARE	--	22
23	--	SPARE	20	1	--					0.00	0.00	--	1	20	SPARE	--	24
25	--	SPARE	20	1	--	0.00	0.00					--	1	20	SPARE	--	26
27	UNLOADING RACK (K215)	Y-IPP-00-0048-001 IPP (NORMAL)	20	1	--			0.50	0.50			--	1	20	Y-IO-00-0048-001 CHARM I/O (NORMAL)	UNLOADING RACK (K215)	28
29	UNLOADING RACK (K215)	Y-IPP-00-0048-001 IPP (UTILITY)	20	1	--					0.50	0.50	--	1	20	Y-IO-00-0048-001 CHARM I/O (UTILITY)	UNLOADING RACK (K215)	30
					Total Load:	0.00 kVA		1.80 kVA		1.30 kVA							
					Total Amps:	0 A		14 A		13 A							

0B

LEGEND:

LOAD CLASSIFICATION	CONNECTED LOAD (kVA)	DEMAND FACTOR	DEMAND LOAD (kVA)	PANEL TOTALS	
RECEPTACLE		100% 1ST 10 kVA (PER NEC ARTICLE 210), 50% > 10 kVA			
LIGHTING / CONTINUOUS		125%		**TOTAL CONN. LOAD:**	2.80 kVA
KITCHEN		100% PER NEC ARTICLE 220.56		**TOTAL EST. DEMAND:**	2.80 kVA
MOTOR		100% PER NEC ARTICLE 430.24		**TOTAL CONN.:**	8 A
LARGEST MOTOR		125%		**TOTAL EST. DEMAND:**	8 A
EQUIPMENT / MISC	0.80	100%	0.80		
SUBFEED LOAD(S)		100%			

Notes:

REFERENCE DRAWINGS & DOCUMENTS:	
DOCUMENT NUMBER	DOCUMENT TITLE
LP148-265-LST-002	ELECTRICAL CABLE LIST - E-HOUSE #48
LP148-265-LST-003	ELECTRICAL EQUIPMENT LIST - E-HOUSE #48
LP1Y-AI-00000258	EQUIPMENT GENERAL ARRANGEMENT TANK FARM, LOADING FACILITIES
B1LG-6-0020-00-00066	48-EB-00-00-01 E-HOUSE ELECTRICAL DESIGN DRAWING SUBMITTALS PACKAGE
LP1Y-EP-0009A005	ELECTRICAL POWER PLAN - GROUND LEVEL (RAIL UNLOADING RACK)
LP1Y-EP-0009B005	ELECTRICAL POWER PLAN - PLATFORM LEVEL (RAIL UNLOADING RACK)
LP1Y-EL-00090001	ELECTRICAL LIGHTING PLAN - RAIL UNLOADING RACK

0B

FLUOR® EFDEE Engineering PC PROJECT NO. B1LG NODE: TFS

REV	DATE	DES	ENG	CHK	APP	PM APP
0A	17-APR-2026	ML	AT	BM	RN	SS
0A	02-MAR-2026	ML	AT	BM	RN	SS
0	11-DEC-2025	NC	MS	EA	TL	EM
A	24-SEP-2025	NC	MS	EA	TL	EM

Lilly

ELECTRICAL PANELBOARD SCHEDULES, BLDG 48
NORMAL LIGHTING AND SMALL POWER, 48-LP/00-00-01
48-LP/00-00-02, 48-RP/00-00-01, 48-RP/00-00-02, 48-RP/00-00-03

REV	ZONE	PROJECT NUMBER / DESCRIPTION	CHANGE CONTROL	DATE
0B	ALL	ISSUED FOR REVIEW	NA	17-APR-2026
0A	ALL	ISSUED FOR REVIEW	NA	02-MAR-2026
0	ALL	ISSUED FOR CONSTRUCTION	NA	11-DEC-2025
A	ALL	ISSUED FOR SQUAD CHECK	NA	24-SEP-2025

REVISIONS

CONFIDENTIAL INFORMATION:
THIS DRAWING AND THE IDEAS AND DESIGNS SHOWN THEREON ARE THE EXCLUSIVE PROPERTY OF ELI LILLY AND COMPANY AND ARE NOT TO BE USED, REPRODUCED OR DISCLOSED, EITHER IN WHOLE OR IN PART, WITHOUT THE WRITTEN CONSENT OF ELI LILLY AND COMPANY.

SYSTEM TYPE: NA		EDIFICE/BUILDING: 48	LEVEL/FLOOR: NA
SUB DISCIPLINE: EK	LOCATION CODE: LP1	LOCATION/GRID: ALL	CCI CODE: YELLOW
CRITICAL QUALITY:		ENTERPRISE GROUP: API	DRAWING INTENTION:
CRITICAL BUSINESS:		EQUIPMENT CLASSIFICATION: NA	ALTERNATE DOCUMENT ID: NA
CRITICAL HSE:		VENDOR: NA	DOCUMENT ID: LP148-EK-00000101
NON-CRITICAL:		ENGINEERING AGENCY DOC ID: NA	

PROJECT NAME: LP1-306-1181
DRAWING SCALE:
MERIDIAN REV: 0B

IF YOU ARE USING A PRINTED COPY OF THIS DOCUMENT, IT IS AN UNCONTROLLED PRINT. CONFIRM WITH THE OFFICIAL "ELECTRONIC RECORD" DOCUMENT IN THE GLOBAL ENGINEERING CONTENT MANAGEMENT SYSTEM.

IF YOU ARE USING A PRINTED COPY OF THIS DOCUMENT, IT IS AN UNCONTROLLED PRINT. CONFIRM WITH THE OFFICIAL "ELECTRONIC RECORD" DOCUMENT IN THE GLOBAL ENGINEERING CONTENT MANAGEMENT SYSTEM.

Autodesk Docs://1580007 - Honors Rule/Lilly/LP1OY-TFS-EN-000-000-00-FDL_detached.rvt
4/20/2026 1:00:53 PM

IF YOU ARE USING A PRINTED COPY OF THIS DOCUMENT, IT IS AN UNCONTROLLED PRINT. CONFIRM WITH THE OFFICIAL "ELECTRONIC RECORD" DOCUMENT IN THE GLOBAL ENGINEERING CONTENT MANAGEMENT SYSTEM.

Branch Panel: 48-UPP/00-00-01

Location: TFS E-House 48-EB/00-00-01 Delta V Room
Supply From: 48-UDP/00-00-01
Mounting: Surface
Enclosure: NEMA 1 Indoor

Volts: 208/120 Wye
Phases: 3
Wires: 4

A.I.C. Rating: 10kA
Mains Type: MCB
Mains Rating: 60 A
MCB Rating: 60 A

Notes:

CKT	LOCATION	LOAD SERVED	CB AMP	CB POLE	CB OPT	A (kVA)		B (kVA)		C (kVA)		CB OPT	CB POLE	CB AMP	LOAD SERVED	LOCATION	CKT
1	--	SPARE	20	2	--	0.00	0.00					--	2	20	SPARE	--	2
3								0.00	0.00								4
5	--	SPARE	20	2	--					0.00	0.00	--	2	20	SPARE	--	6
7						0.00	0.00										8
9	TFS (NEAR OPS SHELTER)	Y-IO-00-0048-002 (UPS)	20	1				0.50	0.00			--	1	20	SPARE	--	10
11	--	SPARE	20	1	--					0.00	0.00	--	1	20	SPARE	--	12
13	--	SPARE	20	1	--	0.00	0.00					--	1	20	SPARE	--	14
15	--	SPARE	20	1	--			0.00	0.00			--	1	20	SPARE	--	16
17	--	SPARE	20	1	--					0.00	0.00	--	1	20	SPARE	--	18
19	--	SPARE	20	1	--	0.00	0.00					--	1	20	SPARE	--	20
21	--	SPARE	20	1	--			0.00	0.00			--	1	20	SPARE	--	22
23	--	SPARE	20	1	--					0.00	0.00	--	1	20	SPARE	--	24
25	UNLOADING RACK (K215)	Y-IO-00-0048-001 (CHARM I/O)	20	1		0.50	0.00					--	1	20	SPARE	--	26
27	UNLOADING RACK (K215)	Y-IPP-00-0048-001 (IPP)	20	1				0.50	0.00			--	1	20	SPARE	--	28
29	UNLOADING RACK (K215)	Y-LCP-000-0640-001 (LEVEL CTRL PNL)	20	1						0.25	0.25		1	20	Y-LCP-000-0650-001 (LEVEL CTRL PNL)	UNLOADING RACK (K215)	30
						Total Load:		0.50 kVA		1.00 kVA							
						Total Amps:		4 A		8 A							

0B

LEGEND:

LOAD CLASSIFICATION	CONNECTED LOAD (kVA)	DEMAND FACTOR	DEMAND LOAD (kVA)	PANEL TOTALS	
RECEPTACLE		100% 1ST 10 kVA (PER NEC ARTICLE 210), 50% > 10 kVA			
LIGHTING / CONTINUOUS		125%		**TOTAL CONN. LOAD:**	2.00 kVA
KITCHEN		100% PER NEC ARTICLE 220.56		**TOTAL EST. DEMAND:**	2.00 kVA
MOTOR		100% PER NEC ARTICLE 430.24		**TOTAL CONN.:**	6 A
LARGEST MOTOR		125%		**TOTAL EST. DEMAND:**	6 A
EQUIPMENT / MISC	0.50	100%	0.50		
SUBFEED LOAD(S)		100%			

Notes:
1. PROVIDE A GFCI RATED BREAKER.

Branch Panel: 48-UPP/00-00-02

Location: TFS E-House 48-EB/00-00-01 IT IDF Room
Supply From: 48-UDP/00-00-01
Mounting: Surface
Enclosure: NEMA 1 Indoor

Volts: 208/120 Wye
Phases: 3
Wires: 4

A.I.C. Rating: 10kA
Mains Type: MCB
Mains Rating: 60 A
MCB Rating: 60 A

Notes:

CKT	LOCATION	LOAD SERVED	CB AMP	CB POLE	CB OPT	A (kVA)		B (kVA)		C (kVA)		CB OPT	CB POLE	CB AMP	LOAD SERVED	LOCATION	CKT
1	--	SPARE	20	2	--	0.00	0.00					--	1	20	SPARE	--	2
3								0.00	0.00			--	1	20	SPARE	--	4
5	--	SPARE	20	2	--					0.00	0.00	--	1	20	SPARE	--	6
7						0.00	0.00					--	1	20	SPARE	--	8
9	--	SPARE	20	2	--			0.00	0.00			--	2	20	SPARE	--	10
11										0.00	0.00						12
13	--	SPARE	20	1	--	0.00	0.00					--	1	20	SPARE	--	14
15	--	SPARE	20	1	--			0.00	0.00			--	1	20	SPARE	--	16
17	--	SPARE	20	1	--					0.00	0.00	--	1	20	SPARE	--	18
19	--	SPARE	20	1	--	0.00	0.00					--	1	20	SPARE	--	20
21	--	SPARE	20	1	--			0.00	0.00			--	1	20	SPARE	--	22
23	--	SPARE	20	1	--					0.00	0.00	--	1	20	SPARE	--	24
25	--	SPARE	20	1	--	0.00	0.00					--	1	20	SPARE	--	26
27	--	SPARE	20	1	--			0.00	0.00			--	1	20	SPARE	--	28
29	--	SPARE	20	1	--					0.00	0.00	--	1	20	SPARE	--	30
						Total Load:		0.00 kVA		0.00 kVA							
						Total Amps:		0 A		0 A							

0B

LEGEND:

LOAD CLASSIFICATION	CONNECTED LOAD (kVA)	DEMAND FACTOR	DEMAND LOAD (kVA)	PANEL TOTALS	
RECEPTACLE		100% 1ST 10 kVA (PER NEC ARTICLE 210), 50% > 10 kVA			
LIGHTING / CONTINUOUS		125%		**TOTAL CONN. LOAD:**	0.00 kVA
KITCHEN		100% PER NEC ARTICLE 220.56		**TOTAL EST. DEMAND:**	0.00 kVA
MOTOR		100% PER NEC ARTICLE 430.24		**TOTAL CONN.:**	0 A
LARGEST MOTOR		125%		**TOTAL EST. DEMAND:**	0 A
EQUIPMENT / MISC		100%			
SUBFEED LOAD(S)		100%			

Notes:

Branch Panel: 48-UDP/00-00-01

Location: TFS E-House 48-EB/00-00-01 Electrical Room
Supply From: 48-UPS/00-00-01 (VIA 50kVA XFMR)
Mounting: Surface
Enclosure: NEMA 1 Indoor

Volts: 208/120 Wye
Phases: 3
Wires: 4

A.I.C. Rating: 10 kA
Mains Type: MCB
Mains Rating: 150 A
MCB Rating: 150 A

Notes:

CKT	LOCATION	LOAD SERVED	CB AMP	CB POLE	CB OPT	A (kVA)		B (kVA)		C (kVA)		CB OPT	CB POLE	CB AMP	LOAD SERVED	LOCATION	CKT
1						0.50	0.00										2
3	E-HOUSE BLDG 48 DELTA V ROOM	48-UPP/00-00-01	60	3				1.00	0.00				3	60	48-UPP/00-00-02	E-HOUSE BLDG 48 IT IDF ROOM	4
5										0.50	0.00						6
7	--	SPARE	20	1	--	0.00	0.00					--	1	20	SPARE	--	8
9	--	SPARE	20	2	--			0.00	0.00			--	2	20	SPARE	--	10
11										0.00	0.00						12
13	SEE NOTE 1	ETHERNET SWITCH 48-MCC/00-00-01	20	1		0.25	0.25						1	20	ETHERNET SWITCH 48-MCC/00-00-02	SEE NOTE 1	14
15	SEE NOTE 1	ETHERNET SWITCH SPARE 48-MCC/00-00-01	20	1				0.25	0.25				1	20	ETHERNET SWITCH SPARE 48-MCC/00-00-02	SEE NOTE 1	16
17	--	SPARE	20	1	--					0.00	0.00	--	1	20	SPARE	--	18
19	--	SPARE	20	1	--	0.00	0.00					--	1	20	SPARE	--	20
21	--	SPARE	20	1	--			0.00	0.00			--	1	20	SPARE	--	22
23	--	SPARE	20	1	--					0.00	0.00	--	1	20	SPARE	--	24
25	--	SPARE	20	1	--	0.00	0.00					--	1	20	SPARE	--	26
27	--	SPARE	20	1	--			0.00	0.00			--	1	20	SPARE	--	28
29	--	SPARE	20	1	--					0.00	0.00	--	1	20	SPARE	--	30
31	--	SPARE	20	1	--	0.00	0.00					--	1	20	SPARE	--	32
33	--	SPARE	20	1	--			0.00	0.00			--	1	20	SPARE	--	34
35	--	SPARE	20	1	--					0.00	0.00	--	1	20	SPARE	--	36
37	--	SPARE	20	1	--	0.00	0.00					--	1	20	SPARE	--	38
39	--	SPARE	20	1	--			0.00	0.00			--	1	20	SPARE	--	40
41	--	SPARE	20	1	--					0.00	0.00	--	1	20	SPARE	--	42
						Total Load:		1.00 kVA		1.50 kVA							
						Total Amps:		9 A		13 A							

LEGEND:

LOAD CLASSIFICATION	CONNECTED LOAD (kVA)	DEMAND FACTOR	DEMAND LOAD (kVA)	PANEL TOTALS	
RECEPTACLE		100% 1ST 10 kVA (PER NEC ARTICLE 210), 50% > 10 kVA			
LIGHTING / CONTINUOUS		125%		**TOTAL CONN. LOAD:**	3.00 kVA
KITCHEN		100% PER NEC ARTICLE 220.56		**TOTAL EST. DEMAND:**	3.00 kVA
MOTOR		100% PER NEC ARTICLE 430.24		**TOTAL CONN.:**	8 A
LARGEST MOTOR		125%		**TOTAL EST. DEMAND:**	8 A
EQUIPMENT / MISC	1.50	100%	1.50		
SUBFEED LOAD(S)		100%			

Notes:
1. LOCATION OF CKT 13, 14, 15, 16: E-HOUSE BLDG. 48 ELECTRICAL ROOM.

REFERENCE DRAWINGS & DOCUMENTS:	
DOCUMENT NUMBER	DOCUMENT TITLE
LP148-265-LST-002	ELECTRICAL CABLE LIST - E-HOUSE #48
LP148-265-LST-003	ELECTRICAL EQUIPMENT LIST - E-HOUSE #48
LP1Y-AI-00000258	EQUIPMENT GENERAL ARRANGEMENT TANK FARM, LOADING FACILITIES
B1LG-6-0020-00-00066	48-EB-00-00-01 E-HOUSE ELECTRICAL DESIGN DRAWING SUBMITTALS PACKAGE
LP1Y-EP-0009A005	ELECTRICAL POWER PLAN - GROUND LEVEL (RAIL UNLOADING RACK)
LP1Y-EP-0009B005	ELECTRICAL POWER PLAN - PLATFORM LEVEL (RAIL UNLOADING RACK)

FLUOR® EFDEE Engineering PC
PROJECT NO. B1LG
NODE: TFS

REV	DATE	DES	ENG	CHK	APP	PM APP
0B	17-APR-2026	ML	AT	BM	RN	SS
0A	02-MAR-2026	ML	AT	BM	RN	SS
0	11-DEC-2025	NC	MS	EA	TL	EM
A	24-SEP-2025	NC	MS	EA	TL	EM

Lilly

ELECTRICAL PANELBOARD SCHEDULES
BUILDING 48, UPS PANEL
48-UDP/00-00-01, 48-UPP/00-00-01, 48-UPP/00-00-02

REV	ZONE	PROJECT NUMBER / DESCRIPTION	CHANGE CONTROL	DATE
0B	ALL	ISSUED FOR REVIEW	NA	17-APR-2026
0A	ALL	ISSUED FOR REVIEW	NA	02-MAR-2026
0	ALL	ISSUED FOR CONSTRUCTION	NA	11-DEC-2025
A	ALL	ISSUED FOR SQUAD CHECK	NA	24-SEP-2025

REVISIONS


CONFIDENTIAL INFORMATION
THIS DRAWING AND THE IDEAS AND DESIGNS SHOWN THEREON ARE THE EXCLUSIVE PROPERTY OF ELI LILLY AND COMPANY AND ARE NOT TO BE USED, REPRODUCED OR DISCLOSED, EITHER IN WHOLE OR IN PART, WITHOUT THE WRITTEN CONSENT OF ELI LILLY AND COMPANY.

SYSTEM TYPE: NA			EDIFICE/BUILDING: 48	LEVEL/FLOOR: NA
SUB DISCIPLINE: EK	LOCATION CODE: LP1	LOCATION/GRID: ALL	CCI CODE: YELLOW	PROJECT NAME: LP1-306-1181
CRITICAL QUALITY:		ENTERPRISE GROUP: API	DRAWING INTENTION:	DRAWING SCALE: NONE
CRITICAL BUSINESS:		EQUIPMENT CLASSIFICATION: NA	ALTERNATE DOCUMENT ID: NA	MERIDIAN REV: 0B
CRITICAL HSE:		VENDOR: NA	DOCUMENT ID: LP148-EK-00000102	
NON-CRITICAL:		ENGINEERING AGENCY DOC ID: NA		


Autodesk Docs://265007 - Hanson-Flor Lilly/LP1Y-TFS-EH-000-000-XH-FGL_detached.rvt
4/20/2026 1:50:55 PM

IF YOU ARE USING A PRINTED COPY OF THIS DOCUMENT, IT IS AN UNCONTROLLED PRINT. CONFIRM WITH THE OFFICIAL "ELECTRONIC RECORD" DOCUMENT IN THE GLOBAL ENGINEERING CONTENT MANAGEMENT SYSTEM.

NOTE: ALL COMPONENTS ON THE SCHEMATIC DIAGRAM ARE LOCATED WITHIN THE MCC UNLESS INDICATED OTHERWISE.

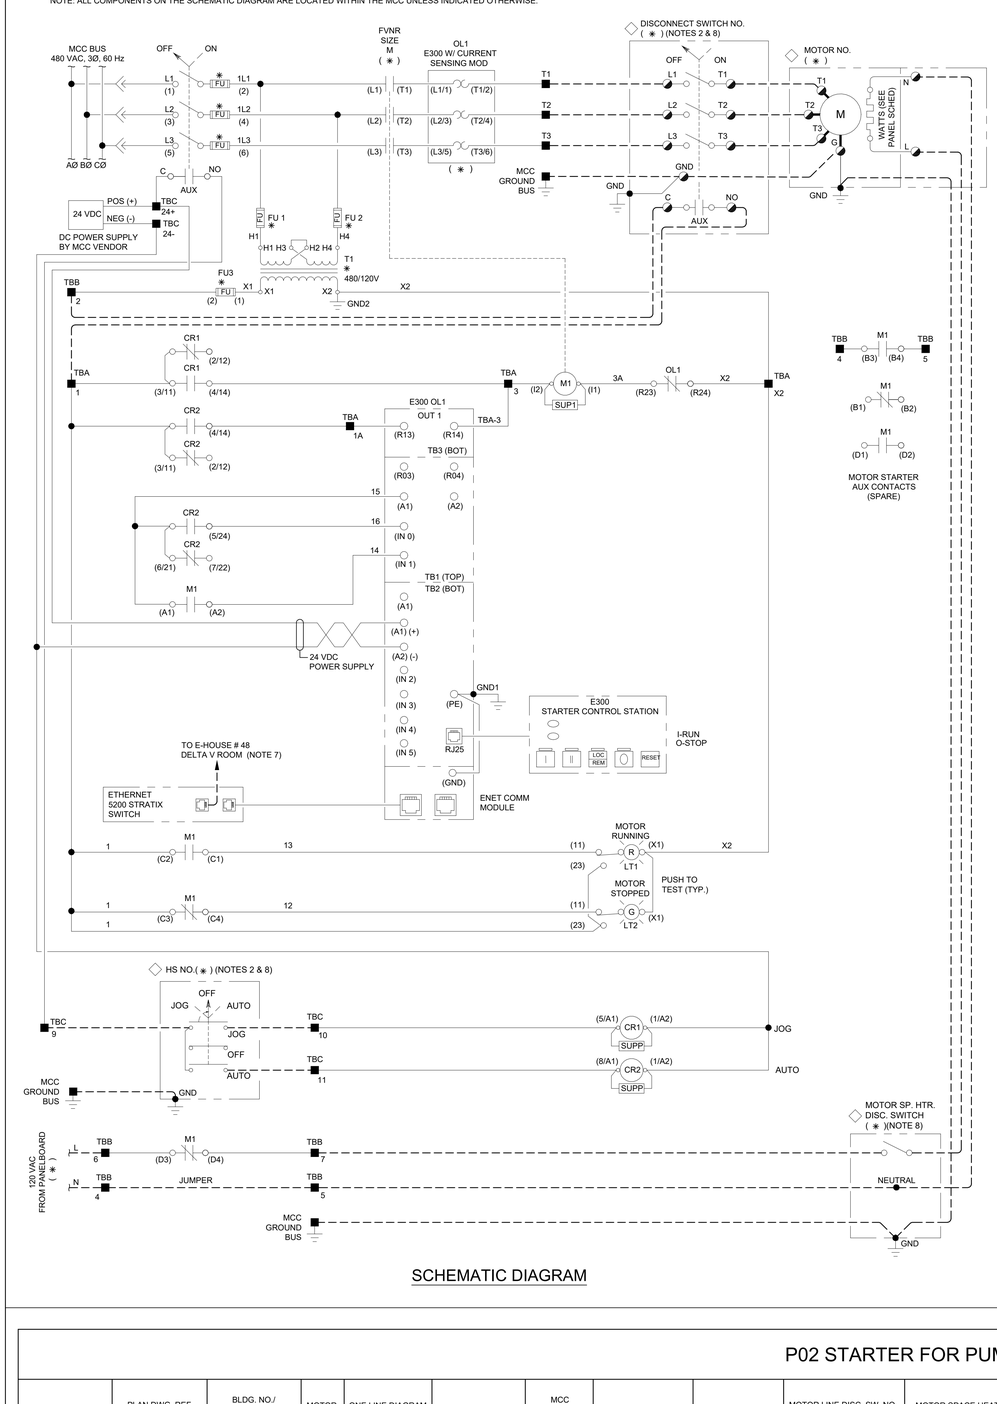

SCHEMATIC DIAGRAM

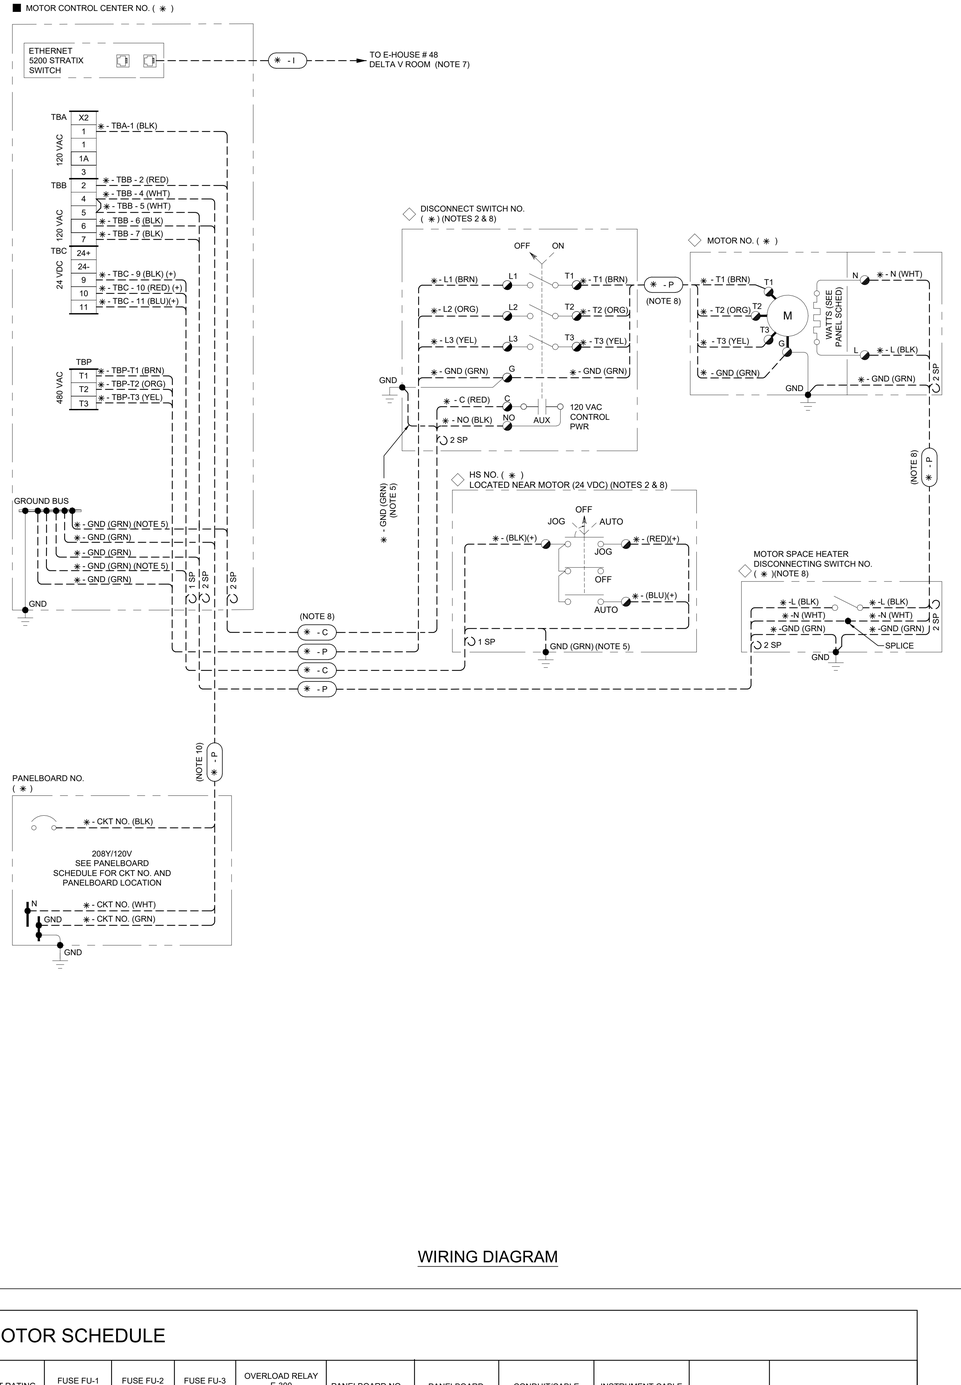


WIRING DIAGRAM

NOTES:

1. SEE DRAWINGS LP100-EJ-00000001 FOR GENERAL NOTES, LP100-EJ-00000002 AND LP100-EJ-00000003 FOR LEGEND AND SYMBOLS.
2. CONTACTS ARE SHOWN IN THE NON-ENERGIZED ("OFF") POSITION, E.G., "SHELF-STATE".
3. CONTRACTOR SHALL PROVIDE HEAT SHRINK MARKING SLEEVES TO IDENTIFY ALL CONDUCTORS AT TERMINATIONS AS INDICATED.
4. WHERE MULTICONDUCTOR CABLES CONTAIN ALL NUMBERED, BLACK, INSULATED CONDUCTORS, (ICEA METHOD 4), CONTRACTOR SHALL LABEL EACH CONDUCTOR WITH A HEAT SHRINK MARKING SLEEVE THAT INDICATES THE COLOR DESIGNATION AS INDICATED, [I.E., (RED)].
5. MULTICONDUCTOR CABLES, REGARDLESS OF ICEA MARKING METHOD, SHALL HAVE ONE OF THE CONDUCTORS MARKED WITH GREEN ELECTRICAL TAPE, AND WITH A HEAT SHRINK SLEEVE IDENTIFYING THE EQUIPMENT GROUNDING CONDUCTOR AS INDICATED.
6. SEE P&ID DWGS. LP100-DI-00000001 THROUGH -00000009 FOR COMPLETE LEGEND.
7. THE CONNECTION BETWEEN MCC TO DELTA-V ROOM IS A PART OF AUXILIARY SYSTEM SCOPE AND SHOWN HERE AS A GENERAL CONCEPT. THIS DOES NOT REPRESENT ACTUAL CABLING. AUXILIARY SYSTEM CABLE DESIGN IS BY OTHERS AND TO BE SHOWN IN IFC REVISION OF DWG. LP1Y-TN-00000003.
8. SUPPLY AND INSTALLATION BY B1LG-00-K215 CONTRACTOR.
9. DRAWING NUMBERS TO BE UPDATED AFTER B1LG-00-K215 CONTRACTOR DESIGN COMPLETION.
10. SUPPLY AND INSTALL BY E-HOUSE VENDOR.

LEGEND

- DEVICE OR TERMINAL LOCATED IN MCC COMPARTMENT
- DEVICE OR TERMINAL LOCATED IN FIELD
- DEVICE OR TERMINAL LOCATED AT OR NEAR MOTOR
- DEVICE TERMINAL
- 1 — MCC TERMINAL
- ✱ - P — CABLE NUMBER (SEE ELECTRICAL CABLE SCHEDULE)
- ✱ - C — CABLE NUMBER (SEE ELECTRICAL / INSTRUMENT CABLE SCHEDULE)
- VENDOR WIRING (INTERNAL) BY EQUIPMENT MANUFACTURER OR FACTORY
- FIELD WIRING (BY CONTRACTOR)
- MECHANICALLY INTERLOCKED
- ✱ - TBA-1 (BLK) — WIRE COLOR (NOTES 3, 4, AND 5); TERM. STRIP (IF APPLICABLE) AND TERMINAL NO.; EQUIPMENT NO. WHERE TERMINATED
- SOFTWARE SIGNAL
- 02 — SCHEME NO.
- P # — PUMP (NOTE 6)
- MOTOR
- XC # — FIXED SPEED CONTROLLER (NOTE 6)
- HS # — HAND SWITCH (NOTE 6)
- STOP — DO C — FUNCTION (AS INDICATED); AI = ANALOG INPUT; AO = ANALOG OUTPUT; DI = DIGITAL INPUT; DO = DIGITAL OUTPUT (NOTE 6)
- ✱ SEE SCHEDULE FOR DETAILS

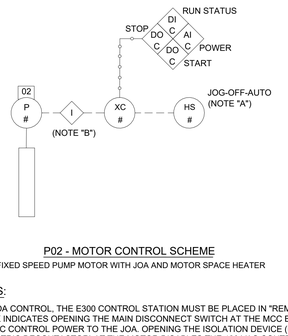

P02 - MOTOR CONTROL SCHEME

FIXED SPEED PUMP MOTOR WITH JOA AND MOTOR SPACE HEATER

SCHEME NOTES:

A. FOR REMOTE JOA CONTROL, THE E300 CONTROL STATION MUST BE PLACED IN "REMOTE".
B. THE INTERLOCK INDICATES OPENING THE MAIN DISCONNECT SWITCH AT THE MCC BUCKET DISABLES 24 VDC CONTROL POWER TO THE JOA. OPENING THE ISOLATION DEVICE (DISCONNECT SWITCH OR MELTRIC DECONTACTOR) AT THE MOTOR DISABLES THE 120 VAC CONTROL POWER IN THE MCC BUCKET.

P02 STARTER FOR PUMP MOTOR SCHEDULE

MOTOR NO.	PLAN DWG. REF. (AT USER)	BLDG. NO./ AREA NO. (AT USER)	MOTOR HP	ONE LINE DIAGRAM DWG. REF.	MCC NO.	MCC SWITCH/FUSE (AMPS)	MOTOR STARTER SIZE	HANDSWITCH NO.	MOTOR LINE DISC. SW. NO. (AT USER)	MOTOR SPACE HEATER DISC. SW. NO.	CPT RATING (VA)	FUSE FU-1 RATING (AMPS)	FUSE FU-2 RATING (AMPS)	FUSE FU-3 RATING (AMPS)	OVERLOAD RELAY E-300 MODEL RANGE (AMPS)	PANELBOARD NO. REF.	PANELBOARD SCHEDULE REF.	CONDUIT/CABLE SCHEDULE REF.	INSTRUMENT CABLE SCHEDULE REF.	MCC P.O. NO. REF.	NOTES
																					10
LP1Y P-0631A	NOTE 9	RAIL LOADING	20	LP148-EK-00000603	48-MCC/00-00-01	60A/40A	NEMA M2	LP1Y P-0631A-LCS	LP1Y P-0631A-DS	LP1Y P-0631A-SH-DS	0.08	0.75	0.75	1	6-60	48-RP/00-00-01	LP148-EK-00000101	LP148-265-LST-002 (NOTE 9)	LP1Y-270-LST-K215-03 (NOTE 9)	B1LG-6-0010-00	

REFERENCE DRAWINGS

DRAWING NUMBER	DESCRIPTION
LP1Y-265-LST-001	ELECTRICAL LOAD LIST - TFS
LP1Y-TN-00000003	COMMUNICATION CABLING SYSTEM BUILDING Y PDC BUILDING LAYOUTS
LP148-265-LST-002	ELECTRICAL CABLE LIST - E HOUSE 48
LP1Y-270-LST-K215-03	INSTRUMENT CABLE SCHEDULE - RAIL UNLOADING RACK
LP1Y-EP-0009A005	ELECTRICAL POWER PLAN - GROUND LEVEL (UNLOADING RACK)

FLUOR

EFDEE Engineering JTC
PROJECT NO. B1LG
NODE: TFS

REV	DATE	DES	ENG	CHK	APP.	PM APP.
10	17-APR-2026	ML	AT	BM	RN	SS
9	02-MAR-2026	ML	AT	BM	RN	SS
8	14-AUG-2025	OC	MS	MP	TL	RD
7	19-JUN-2025	OC	MS	MP	TL	

Lilly

ELECTRICAL LV SCHEMATIC DIAGRAM
P02 FIXED SPEED PUMP MOTOR W/ JOA & MOTOR SPACE HEATER
E-HOUSE BLDG. 48

REV	ZONE	PROJECT NUMBER / DESCRIPTION	CHANGE CONTROL	DATE
10	ALL	ISSUED FOR REVIEW	N/A	17-APR-26
9	ALL	ISSUED FOR REVIEW - REV B	N/A	02-MAR-26
0	ALL	ISSUED FOR CONSTRUCTION	N/A	14-AUG-25
A	ALL	ISSUED FOR SQUAD CHECK (SQCK)	N/A	19-JUN-25

REVISIONS

CONFIDENTIAL INFORMATION


THIS DRAWING AND THE IDEAS AND DESIGNS SHOWN THEREON ARE THE EXCLUSIVE PROPERTY OF ELI LILLY AND COMPANY AND ARE NOT TO BE USED, REPRODUCED OR DISCLOSED, EITHER IN WHOLE OR IN PART, WITHOUT THE WRITTEN CONSENT OF ELI LILLY AND COMPANY.

SYSTEM TYPE: NA		EDIFICE/BUILDING: 48	LEVEL/FLOOR: 0
SUB DISCIPLINE: EK	LOCATION CODE: LP1	LOCATION/GRID: NA	CCI CODE: YELLOW
PROJECT NAME: LP1-306-1181		CRITICAL QUALITY	ENTERPRISE GROUP: API
DRAWING INTENTION		DRAWING SCALE: NONE	
CRITICAL BUSINESS	EQUIPMENT CLASSIFICATION: NA	ALTERNATE DOCUMENT ID: NA	MERIDIAN REV: 0
CRITICAL HSE	VENDOR: NA	DOCUMENT ID: LP148-EK-00000301	
NON-CRITICAL	ENGINEERING AGENCY DOC ID: NA		

V:\CAD\265\DWG\0Y-Tank Farm System\Schematics\1. Working\LP148-EK-00000301.dwg 08-18-25 4:53 pm Printed By: pan27418

IF YOU ARE USING A PRINTED COPY OF THIS DOCUMENT, IT IS AN UNCONTROLLED PRINT. CONFIRM WITH THE OFFICIAL "ELECTRONIC RECORD" DOCUMENT IN THE GLOBAL ENGINEERING CONTENT MANAGEMENT SYSTEM.

IF YOU ARE USING A PRINTED COPY OF THIS DOCUMENT, IT IS AN UNCONTROLLED PRINT. CONFIRM WITH THE OFFICIAL "ELECTRONIC RECORD" DOCUMENT IN THE GLOBAL ENGINEERING CONTENT MANAGEMENT SYSTEM.

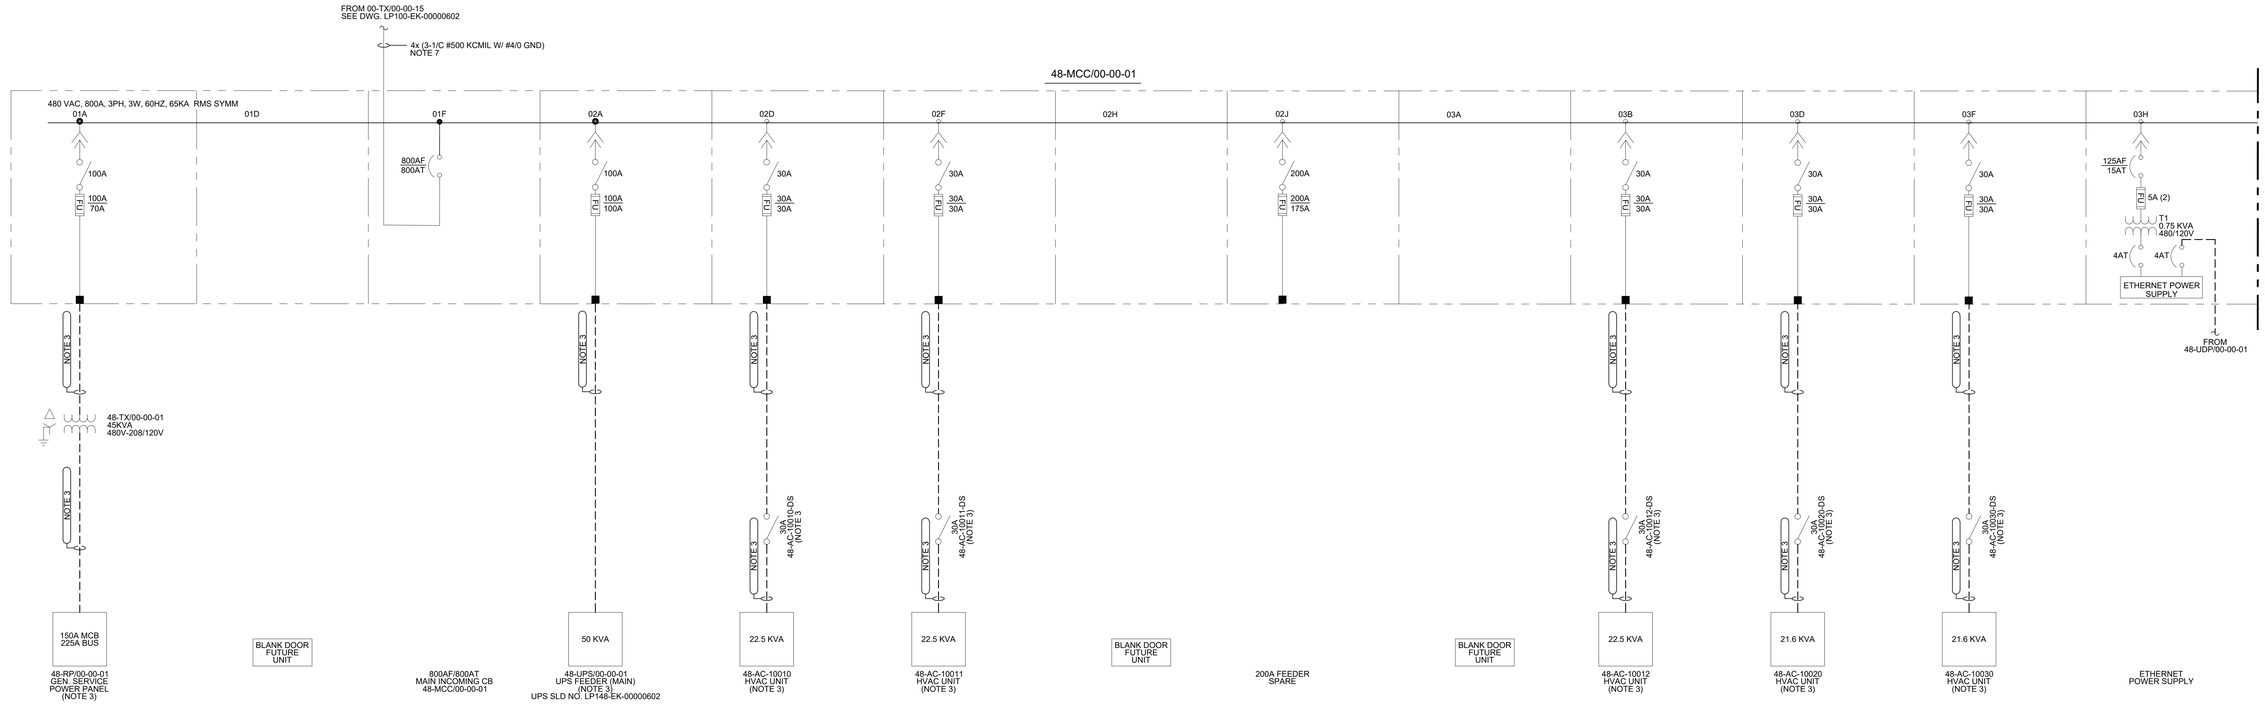

GENERAL NOTES:

1. FOR GENERAL NOTES AND LEGEND AND SYMBOLS, REFER TO DRAWINGS LP100-EJ-00000001 THROUGH LP100-EJ-00000003.
2. JOA CONTROL SUPPLY BEING 24V, THE CABLE BETWEEN JOA TO MCC IS COVERED IN CONTROL SYSTEM CABLE SCHEDULE. REFER TO DOCUMENT NO. LP1Y-270-LST-003 FOR DETAILS.
3. CABLES AND EQUIPMENTS ARE SUPPLIED AND INSTALLED BY E-HOUSE VENDOR.
4. PANEL 48-RP/00-00-01 SUPPLIES 120VAC POWER TO THE MCC TERMINAL, FROM WHICH THE MOTOR SPACE HEATER RECEIVES ITS POWER SUPPLY.
5. ALL SPARE STARTERS RATED 20HP AND ABOVE ARE EQUIPPED WITH A 120VAC TERMINAL FOR FUTURE MOTOR SPACE HEATER CONNECTION.
6. SUPPLY AND INSTALL BY RAIL CAR LOADING VENDOR.
7. REFER TO SITE (STE) CABLE SCHEDULE LP100-265-LST-002 FOR INCOMING FEEDER CONDUCTORS AND GROUND (GND) CABLE TAGS.
8. NEC CODE COMPLIANT LOCAL FUSED DISCONNECT SWITCH TO BE SUPPLIED WITH PACKAGED WATER HEATER PANEL. 10A

LEGEND

FUSE DISCONNECT

XXA - DISCONNECT SWITCH RATING

XXA - FUSE CLIP RATING
XXA - FUSE TRIP RATING

OVERLOAD RELAY

REFERENCE DRAWINGS & DOCUMENTS

DRAWING NUMBER	DRAWING TITLE
LP100-EJ-00000001	ELECTRICAL NOTES & GUIDELINES
LP100-EJ-00000002 LP100-EJ-00000003	ELECTRICAL LEGEND & SYMBOLS
LP100-EK-00000602	ELECTRICAL SITE SINGLE LINE DIAGRAM 12.47kV LOOP, SHEET 2 OF 3 SITE 00
LP148-EK-00000602	ELECTRICAL SINGLE LINE DIAGRAM BUILDING 48 UPS DISTRIBUTION
LP148-EK-00000604	ELECTRICAL SINGLE LINE DIAGRAM BUILDING 48 LP148-MCC/00-00-01 (SHEET 2 OF 2)
LP148-265-LST-002	ELECTRICAL CABLE LIST - EHOUSE #48
LP1Y-265-LST-001	ELECTRICAL LOAD LIST - TFS
LP1Y-270-LST-003	TFS CABLE SCHEDULE
LP148-EK-00000301	ELECTRICAL LV SCHEMATIC DIAGRAM P02 FIXED SPEED PUMP MOTOR W/ JOA AND MOTOR SPACE HEATER
B1LG-6-0020-00-00066	48-EB/00-00-01 E-HOUSE ELECTRICAL DESIGN DRAWING SUBMITTALS PACKAGE

REFERENCE DRAWINGS & DOCUMENTS CONT'D.

DRAWING NUMBER	DRAWING TITLE
LP148-EK-00000101	ELECTRICAL PANELBOARD SCHEDULES, BLDG 48 NORMAL LIGHTING AND SMALL POWER, 48-LP/00-00-01, 48-LP/00-00-02, 48-RP/00-00-01, 48-RP/00-00-02, 48-RP/00-00-03
LP148-EK-00000102	ELECTRICAL PANELBOARD SCHEDULES BUILDING 48 UPS PANEL 48-UPS/00-00-01, 48-LP/00-00-01, 48-LP/00-00-02, 48-RP/00-00-02
LP1Y-EP-0009A005	ELECTRICAL POWER PLAN - GROUND LEVEL (K215 UNLOADING RACK) 10A

HOLD:

1. TAG FOR CABLE, THE POINT OF CONNECTION AND LOAD RATING FOR OPERATION SHELTER IS ON HOLD.
2. LOAD RATING FOR THE LOADS RELATED TO RAIL CAR LOADING AREA IS ON HOLD.

REV.	ZONE	PROJECT NUMBER / DESCRIPTION	CHANGE CONTROL	DATE
2A	ALL	ISSUED FOR REVIEW	NA	17-APR-2026
1	ALL	ISSUED FOR CONSTRUCTION	NA	03-FEB-2026
A	ALL	ISSUED FOR REVIEW	NA	02-DEC-2025

REVISIONS

CONFIDENTIAL INFORMATION

THIS DRAWING AND THE IDEAS AND DESIGNS SHOWN THEREON ARE THE EXCLUSIVE PROPERTY OF ELI LILLY AND COMPANY AND ARE NOT TO BE USED, REPRODUCED OR DISCLOSED, EITHER IN WHOLE OR IN PART, WITHOUT THE WRITTEN CONSENT OF ELI LILLY AND COMPANY.

FLUOR

Lilly

EFDEE Engineering PC
PROJECT NO. B1LG
NODE: TFS

REV	DATE	DES	ENG	CHK	APP	PM APP
2A	17-APR-2026	ML	AT	BM	RN	SS
1	03-FEB-2026	JA	MS	NM	TL	RD
A	02-DEC-2025	JL	MS	EA	TL	RD

ELECTRICAL SINGLE LINE DIAGRAM BUILDING 48 LP148-MCC/00-00-01 (SHEET 1 OF 2)

SYSTEM TYPE: NA		EDIFICE/BUILDING: 48	LEVEL/FLOOR: NA
SUB DISCIPLINE: EK	LOCATION CODE: LP1	LOCATION/GRID	CCI CODE: YELLOW
			PROJECT NAME: LP1-306-1181
CRITICAL QUALITY	ENTERPRISE GROUP: API		DRAWING INTENTION
			DRAWING SCALE: NA
CRITICAL BUSINESS	EQUIPMENT CLASSIFICATION: NA		ALTERNATE DOCUMENT ID: NA / MERIDIAN REV: 0
CRITICAL HSE	VENDOR: NA		DOCUMENT ID: LP148-EK-00000603
NON-CRITICAL	ENGINEERING AGENCY DOC ID: NA		

IF YOU ARE USING A PRINTED COPY OF THIS DOCUMENT, IT IS AN UNCONTROLLED PRINT. CONFIRM WITH THE OFFICIAL "ELECTRONIC RECORD" DOCUMENT IN THE GLOBAL ENGINEERING CONTENT MANAGEMENT SYSTEM.

IF YOU ARE USING A PRINTED COPY OF THIS DOCUMENT, IT IS AN UNCONTROLLED PRINT. CONFIRM WITH THE OFFICIAL "ELECTRONIC RECORD" DOCUMENT IN THE GLOBAL ENGINEERING CONTENT MANAGEMENT SYSTEM.


C:\Users\pan274\18\Downloads\LP148-EK-00000603_R0 (1).dwg 03-10-26 3:48 pm Printed By: pan27418



GENERAL NOTES:

1. FOR GENERAL NOTES AND LEGEND AND SYMBOLS, REFER TO DRAWINGS LP100-EJ-00000001 THROUGH LP100-EJ-00000003.
2. JOA CONTROL SUPPLY BEING 24V, THE CABLE BETWEEN JOA TO MCC IS COVERED IN CONTROL SYSTEM CABLE SCHEDULE. REFER TO DOCUMENT NO. LP1Y-270-LST-003 FOR DETAILS.
3. ALL UNTAGGED CABLES ARE SUPPLIED AND INSTALLED BY E-HOUSE VENDOR.
4. SUPPLY AND INSTALL BY RAIL CAR LOADING VENDOR.

LEGEND:

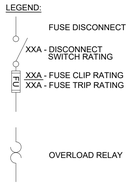

REFERENCE DRAWINGS & DOCUMENTS

DRAWING NUMBER	DRAWING TITLE
LP100-EJ-00000001	ELECTRICAL NOTES & GUIDELINES
LP100-EJ-00000002 LP100-EJ-00000003	ELECTRICAL LEGEND & SYMBOLS
LP100-EK-00000602	ELECTRICAL SITE SINGLE LINE DIAGRAM 12.47kV LOOP, SHEET 2 OF 3 SITE 00
LP148-EK-00000602	ELECTRICAL SINGLE LINE DIAGRAM BUILDING 48 UPS DISTRIBUTION
LP148-EK-00000603	ELECTRICAL SINGLE LINE DIAGRAM BUILDING 48 LP148-MCC/00-00-01 (SHEET 1 OF 2)
LP148-265-LST-002	ELECTRICAL CABLE LIST - EHOUSE #48
LP1Y-265-LST-001	ELECTRICAL LOAD LIST - TFS
LP1Y-270-LST-003	TFS CABLE SCHEDULE
LP148-EK-00000301	ELECTRICAL LV SCHEMATIC DIAGRAM P02 FIXED SPEED PUMP MOTOR W/ JOA AND MOTOR SPACE HEATER
B1LG-6-0020-00-00066	48-EB/00-00-01 E-HOUSE ELECTRICAL DESIGN DRAWING SUBMITTALS PACKAGE

REFERENCE DRAWINGS & DOCUMENTS CONT'D.

DRAWING NUMBER	DRAWING TITLE
LP148-EK-00000101	ELECTRICAL PANELBOARD SCHEDULES, BLDG 48 NORMAL LIGHTING AND SMALL POWER, 48-LP/00-00-01, 48-LP/00-00-02, 48-RP/00-00-01, 48-RP/00-00-02, 48-RP/00-00-03
LP148-EK-00000102	ELECTRICAL PANELBOARD SCHEDULES BUILDING 48 UPS PANEL 48-UPS/00-00-01, 48-UDP/00-00-01, 48-UDP/00-00-02
LP1Y-EP-009A005	ELECTRICAL POWER PLAN - GROUND LEVEL (RAIL UNLOADING RACK)
LP1Y-EP-009B005	ELECTRICAL POWER PLAN - PLATFORM LEVEL (RAIL UNLOADING RACK)

HOLD:

1. LOAD RATING FOR THE LOADS RELATED TO RAIL CAR LOADING AREA IS ON HOLD.

REV	ZONE	PROJECT NUMBER / DESCRIPTION	CHANGE CONTROL	DATE
3	ALL	ISSUED FOR REVIEW - REV B	NA	17-APR-2026
2	ALL	ISSUED FOR CONSTRUCTION	NA	03-FEB-2026
1	ALL	ISSUED FOR REVIEW	NA	02-DEC-2025

REVISIONS

CONFIDENTIAL INFORMATION
THIS DRAWING AND THE IDEAS AND DESIGNS SHOWN THEREON ARE THE EXCLUSIVE PROPERTY OF ELI LILLY AND COMPANY AND ARE NOT TO BE USED, REPRODUCED OR DISCLOSED, EITHER IN WHOLE OR IN PART, WITHOUT THE WRITTEN CONSENT OF ELI LILLY AND COMPANY.

FLUOR

EFDEE Engineering PC
PROJECT NO. B1LG
NODE: TFS

REV	DATE	DES	ENG	CHK	APP	PM APP
3	17-APR-2026	ML	AT	BM	RN	SS
2	03-FEB-2026	JA	MS	NM	TL	RD
1	02-DEC-2025	JL	MS	EA	TL	RD

Lilly

ELECTRICAL SINGLE LINE DIAGRAM
BUILDING 48
LP148-MCC/00-00-01 (SHEET 2 OF 2)

SYSTEM TYPE: NA		EDIFICE/BUILDING: 48	LEVEL/FLOOR: NA
SUB DISCIPLINE: EK	LOCATION CODE: LP1	LOCATION/GRID:	CO CODE: YELLOW
CRITICAL QUALITY:	ENTERPRISE GROUP: API		PROJECT NAME: LP1-306-1181
		DRAWING INTENTION:	DRAWING SCALE: NA
CRITICAL BUSINESS:	EQUIPMENT CLASSIFICATION: NA	ALTERNATE DOCUMENT ID:	MERIDIAN REV: 0
CRITICAL HSE:	VENDOR: NA	DOCUMENT ID: LP148-EK-00000604	
NON-CRITICAL:	ENGINEERING AGENCY DOC ID: NA		

IF YOU ARE USING A PRINTED COPY OF THIS DOCUMENT, IT IS AN UNCONTROLLED PRINT. CONFIRM WITH THE OFFICIAL "ELECTRONIC RECORD" DOCUMENT IN THE GLOBAL ENGINEERING CONTENT MANAGEMENT SYSTEM.

C:\Users\ass83030\OneDrive - Fluor Corporation\Documents\00 PROJECTS\LILLY MCC SLD\Working\LP148-EK-00000604_R0.dwg 03-04-26 1:24 pm Printed By: ass83030

IF YOU ARE USING A PRINTED COPY OF THIS DOCUMENT, IT IS AN UNCONTROLLED PRINT. CONFIRM WITH THE OFFICIAL "ELECTRONIC RECORD" DOCUMENT IN THE GLOBAL ENGINEERING CONTENT MANAGEMENT SYSTEM.